

# MIDSHIP SECTION TYPE F.I.

SCALE 1/2" = 1 FOOT.

DIMENSIONS.

LENGTH B.P. 399.6' BREADTH M.L. 52.66' DEPTH M.L. 26.92'  
TWEEN DECKS 8.6'

NUMERALS	
BREADTH M.L.	52.66
DEPTH M.L.	26.92
+5 FOR 8.6 TWEEN DECKS	+5.00
DEPTH FOR NUMERALS	27.42
TRANSVERSE NUMBER	80.08
LENGTH B.P.	399.60
CONSTITUTIONAL NUMBER	31999
ERECTOR'S	2397
CASINGS ETC.	308
EQUIPMENT NUMBER	34704
L/D TO SHELTER DECK	11.28
d	23.34

EQUIPMENT	
2 BOWER ANCHORS EACH 60 CWT	STOCKLESS
1 BOWER ANCHOR	50 1/2
1 STREAM	1 1/4 Ex. STOCK
1 KEDGE	7
270 FATHOMS 2 3/16	STUD CHAIN CABLE
90	4 3/4 STEEL WIRE
120	4 3/4 TOWLINE
90	3 HAWSEY
90	3
2 at 90	2 1/2

STRAKE .76" FOR 1/2 L. TO .44"  
BUTTS QUADRUPLE RIVETED FOR 1/2 L.  
TREBLE AT ENDS

STRAKE (OUT) .75" .66" FOR 1/2 L. TO .44"  
BUTTS QUADRUPLE RIVETED FOR 1/2 L.  
TREBLE AT ENDS

STRAKE (IN) .66" .66" FOR 1/2 L. TO .48"  
.44" IN PEAKS



STRAKE (OUT) .66" .66" FOR 1/2 L. TO .48"  
.44" IN PEAKS

STRAKE (IN) .66" .66" FOR 1/2 L. TO .48"  
.44" IN PEAKS

STRAKE (OUT) .66" .66" FOR 1/2 L. TO .48"  
.44" IN PEAKS

STRAKE IN .66" .62" TO .46"  
BUTTS QUADRUPLE RIVETED FOR 1/2 L.  
TREBLE AT ENDS

13/10/17  
25/1/18 (27/1/2)  
25-2-18 (27-3-18)

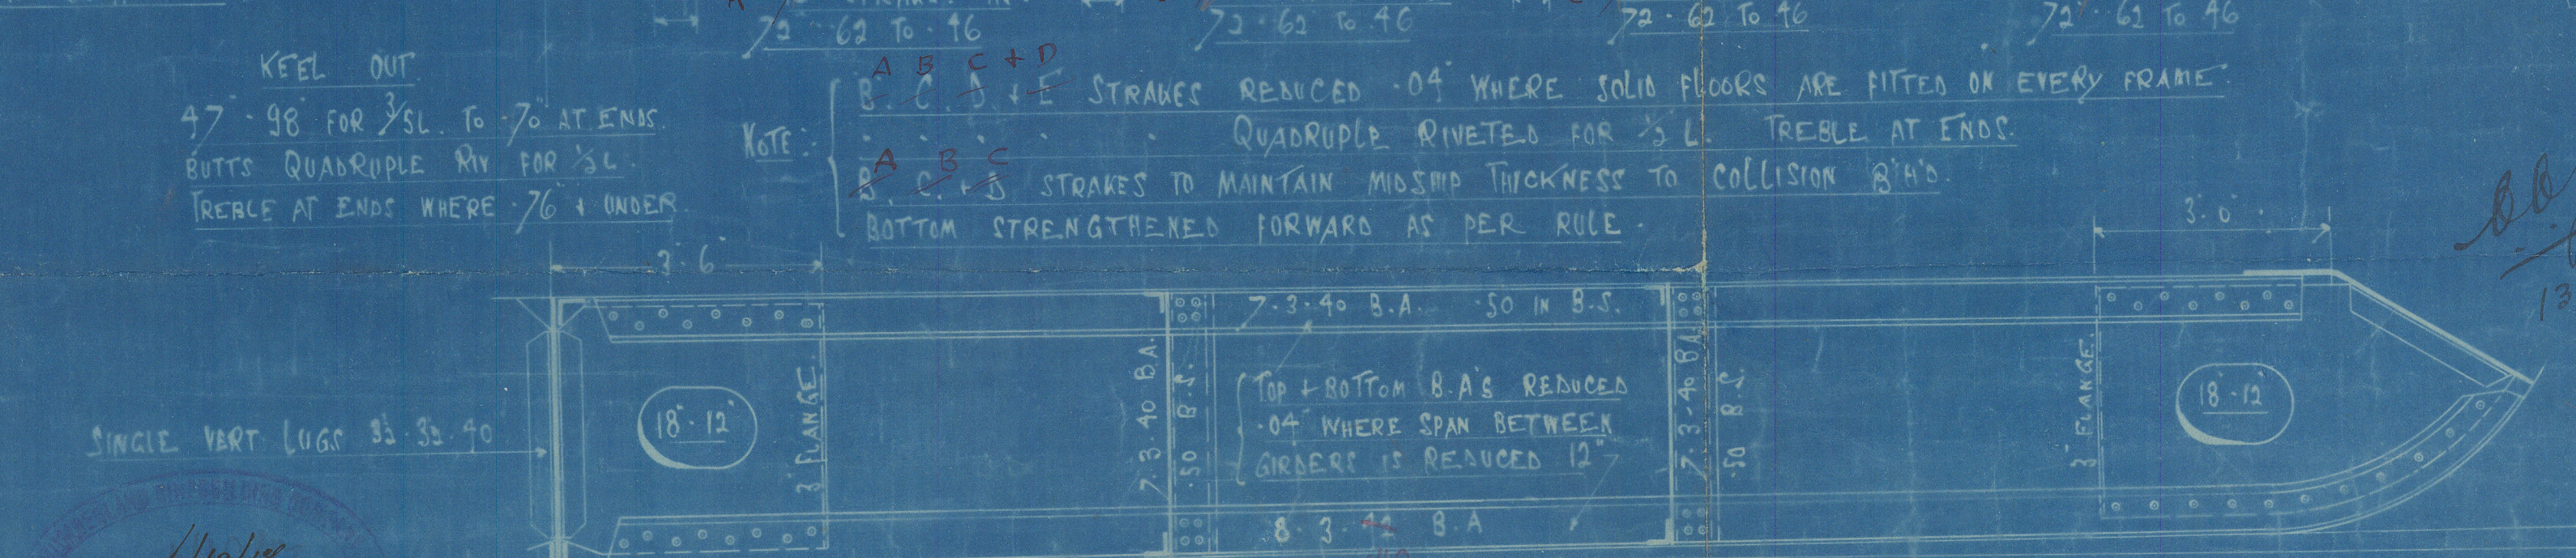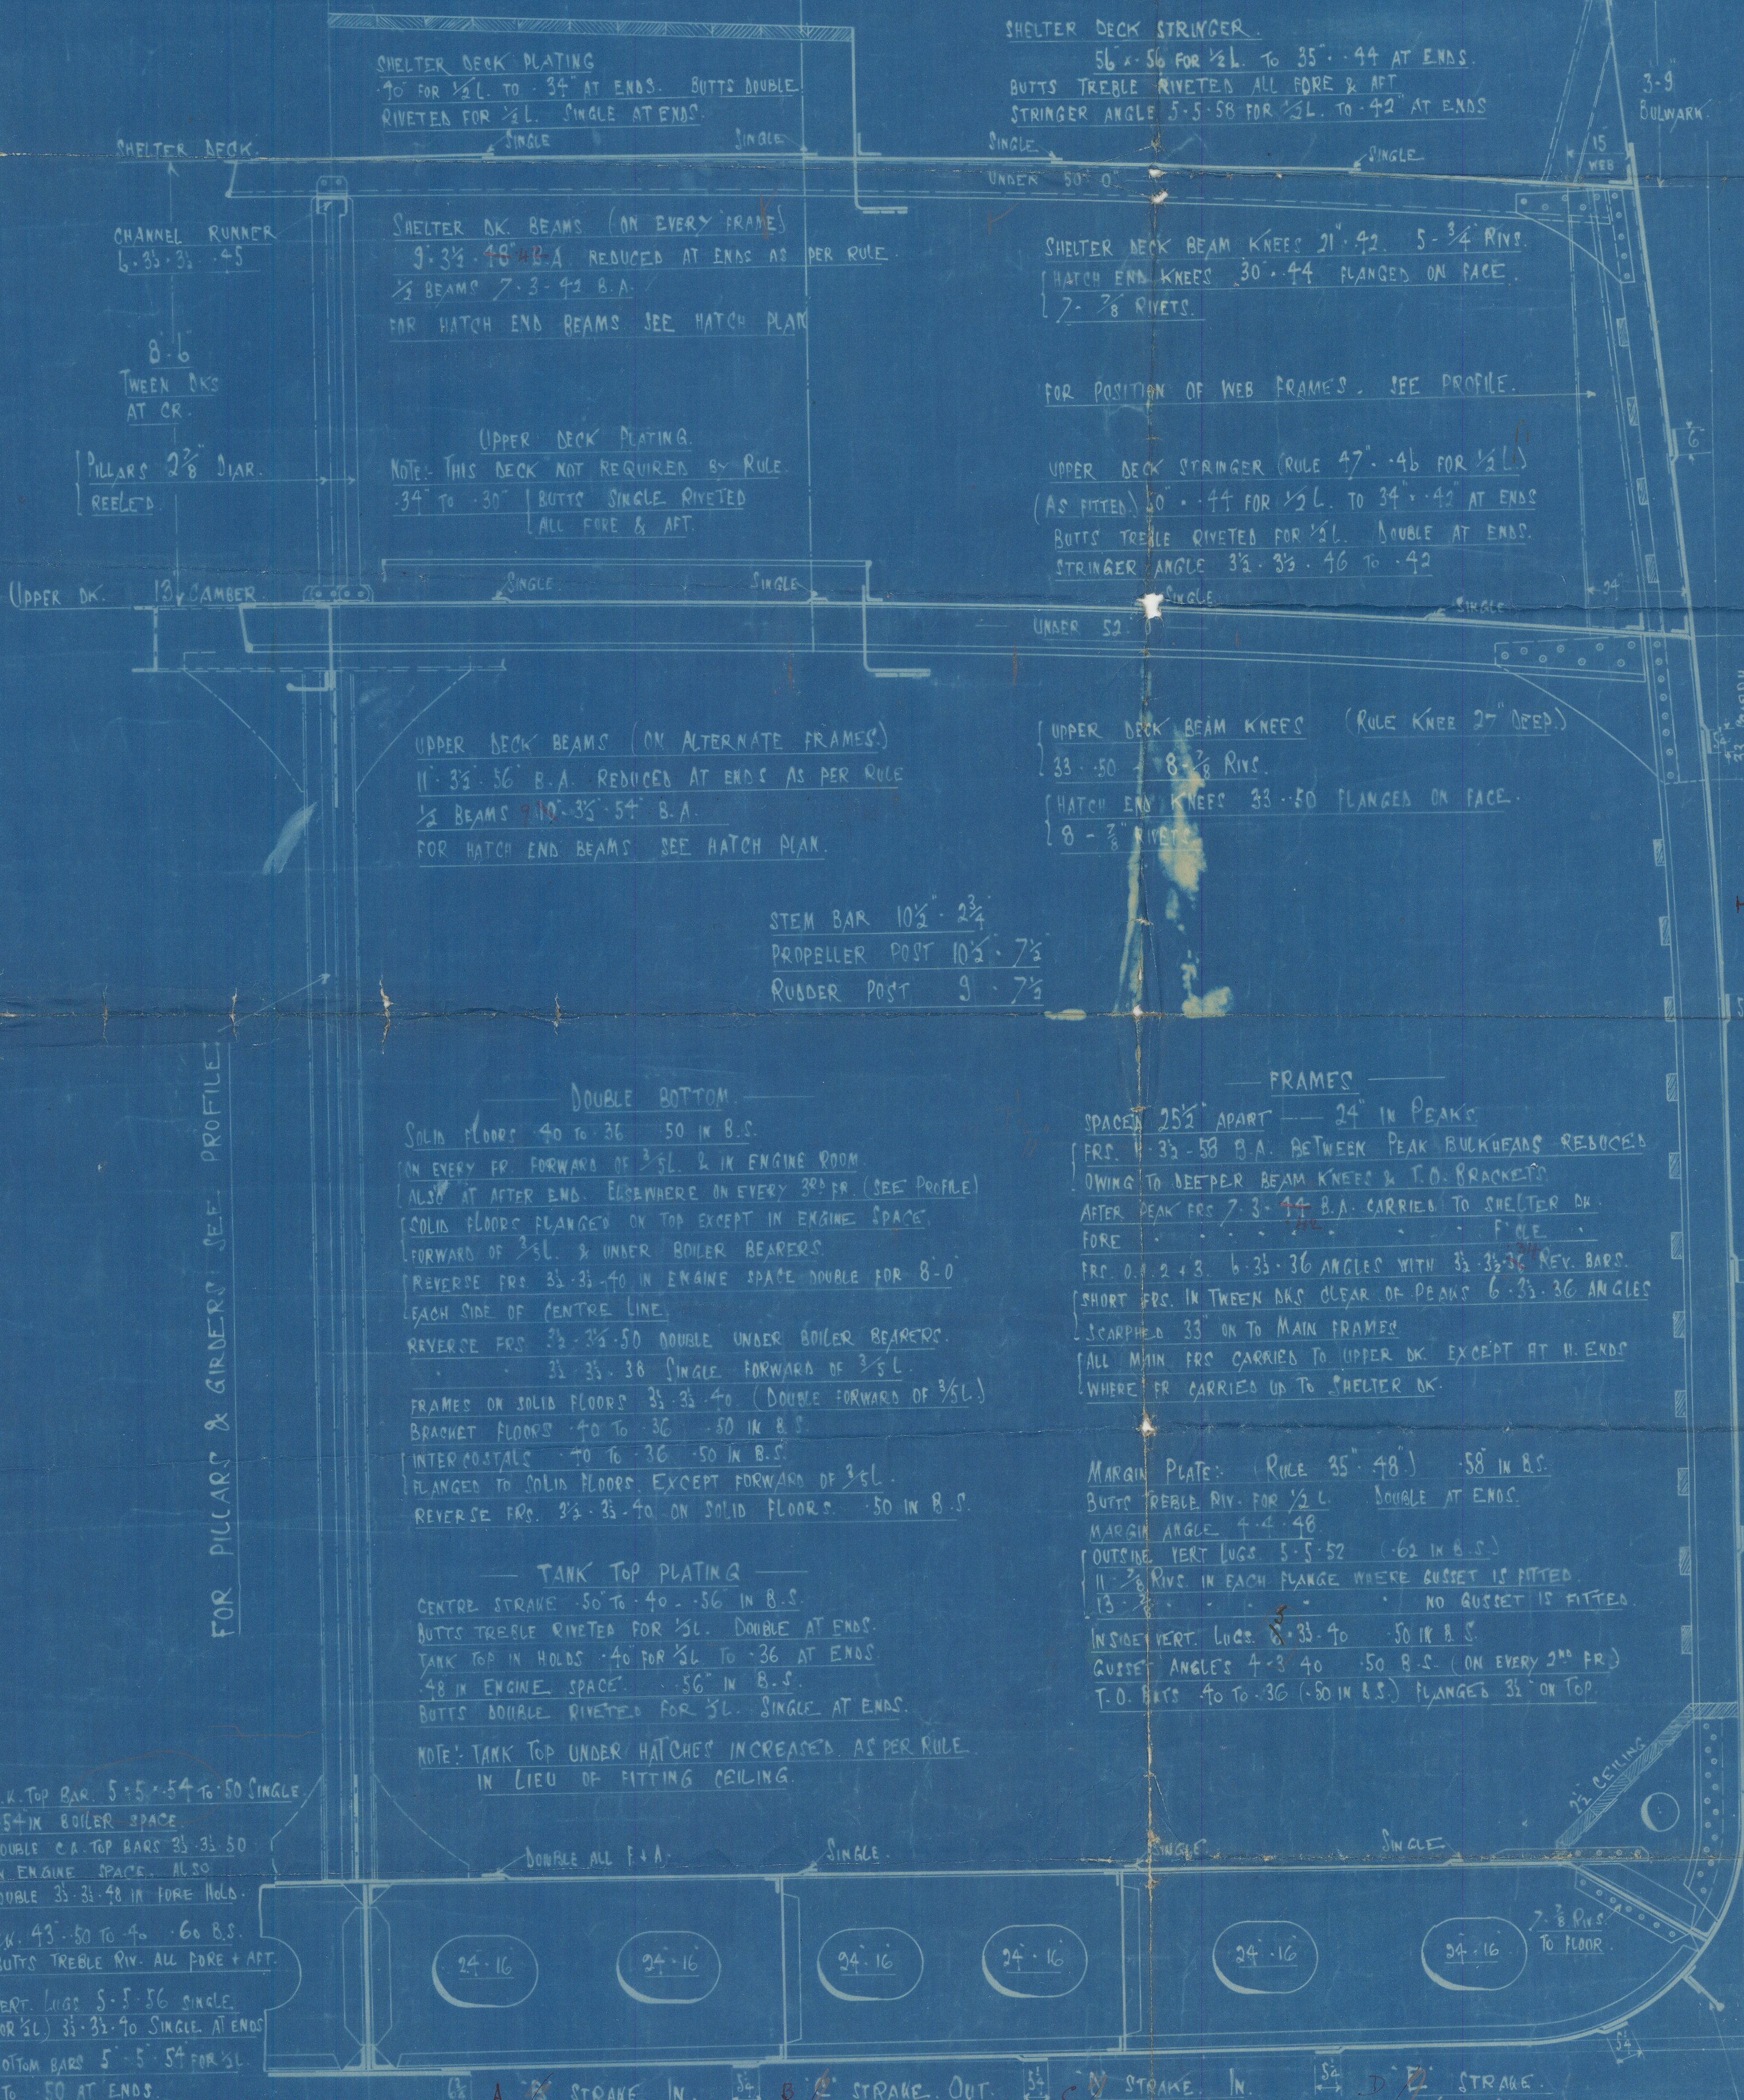

6/10/18  
3273  
288

April 16-17




Northumberland & Co

S.S. 250-251-252  
270/2 273/4  
+ 277-278-279 + 280





Midship Section

S. S. WAR CITADEL  
NEWCASTLE ON TYNE.

Report No. 71419

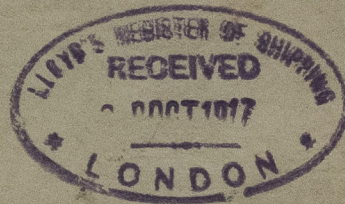


LYRAS \*

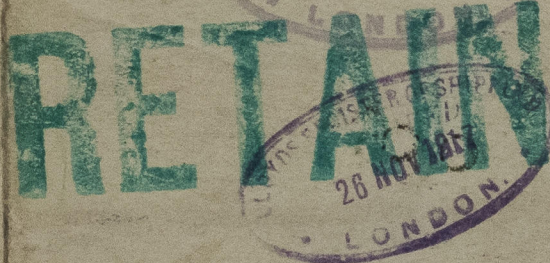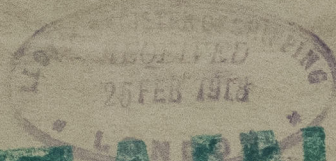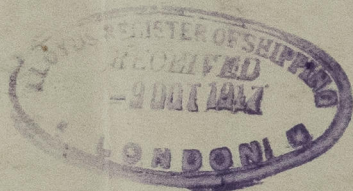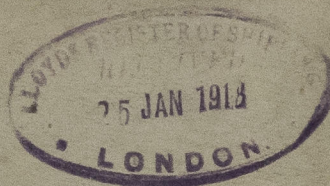

S. S. WAR CASTLE  
NEWCASTLE ON TYNE.

Report No. 71350

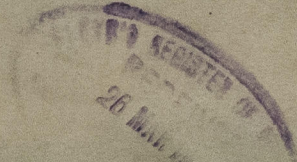

9510-7191M



© 2021

Lloyd's Register  
Foundation