


SCALE - 1" = 1 FOOT.
28.10.1920.

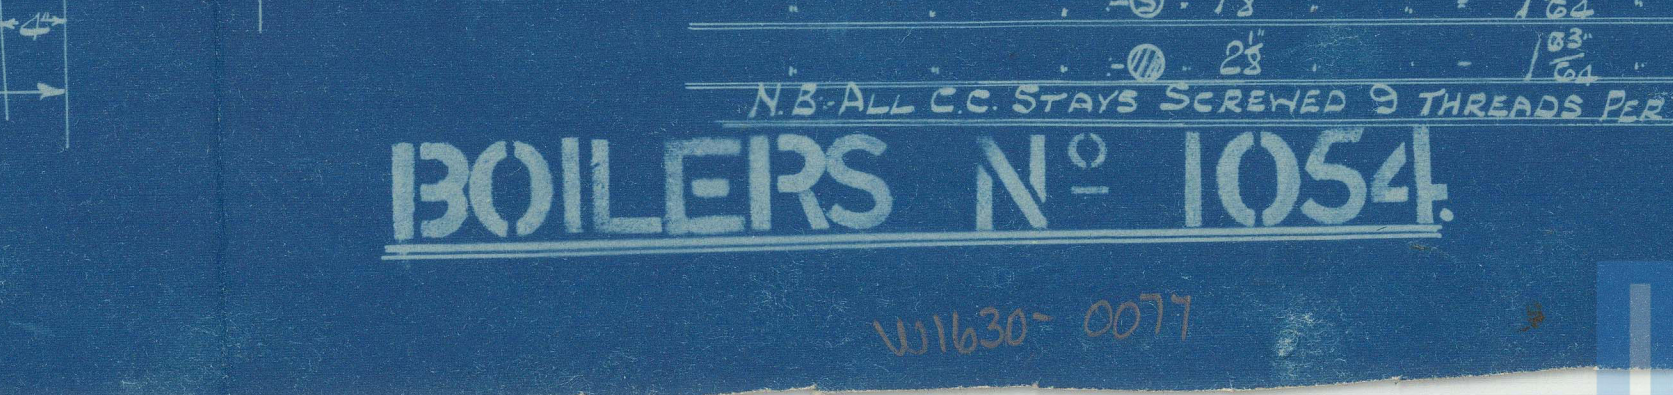

BOILERS N° 1054

SUNDERLAND.

G. CLARK

1054


SIR JAS. LAING

679

AMENDED PLAN

9/3. "BRITISH JUDGE"

35E

SUNDERLAND RPT. NO. 28236

~~W.P. 180 1/2~~

No. 3769
LLOYD'S TEST
360 lbs.
W.P. 180 1/2
G.A.H. 18.7.21

RETAIN




© 2021

Lloyd's Register
Foundation