


PLATE	85.13%
RIVET	85.9%

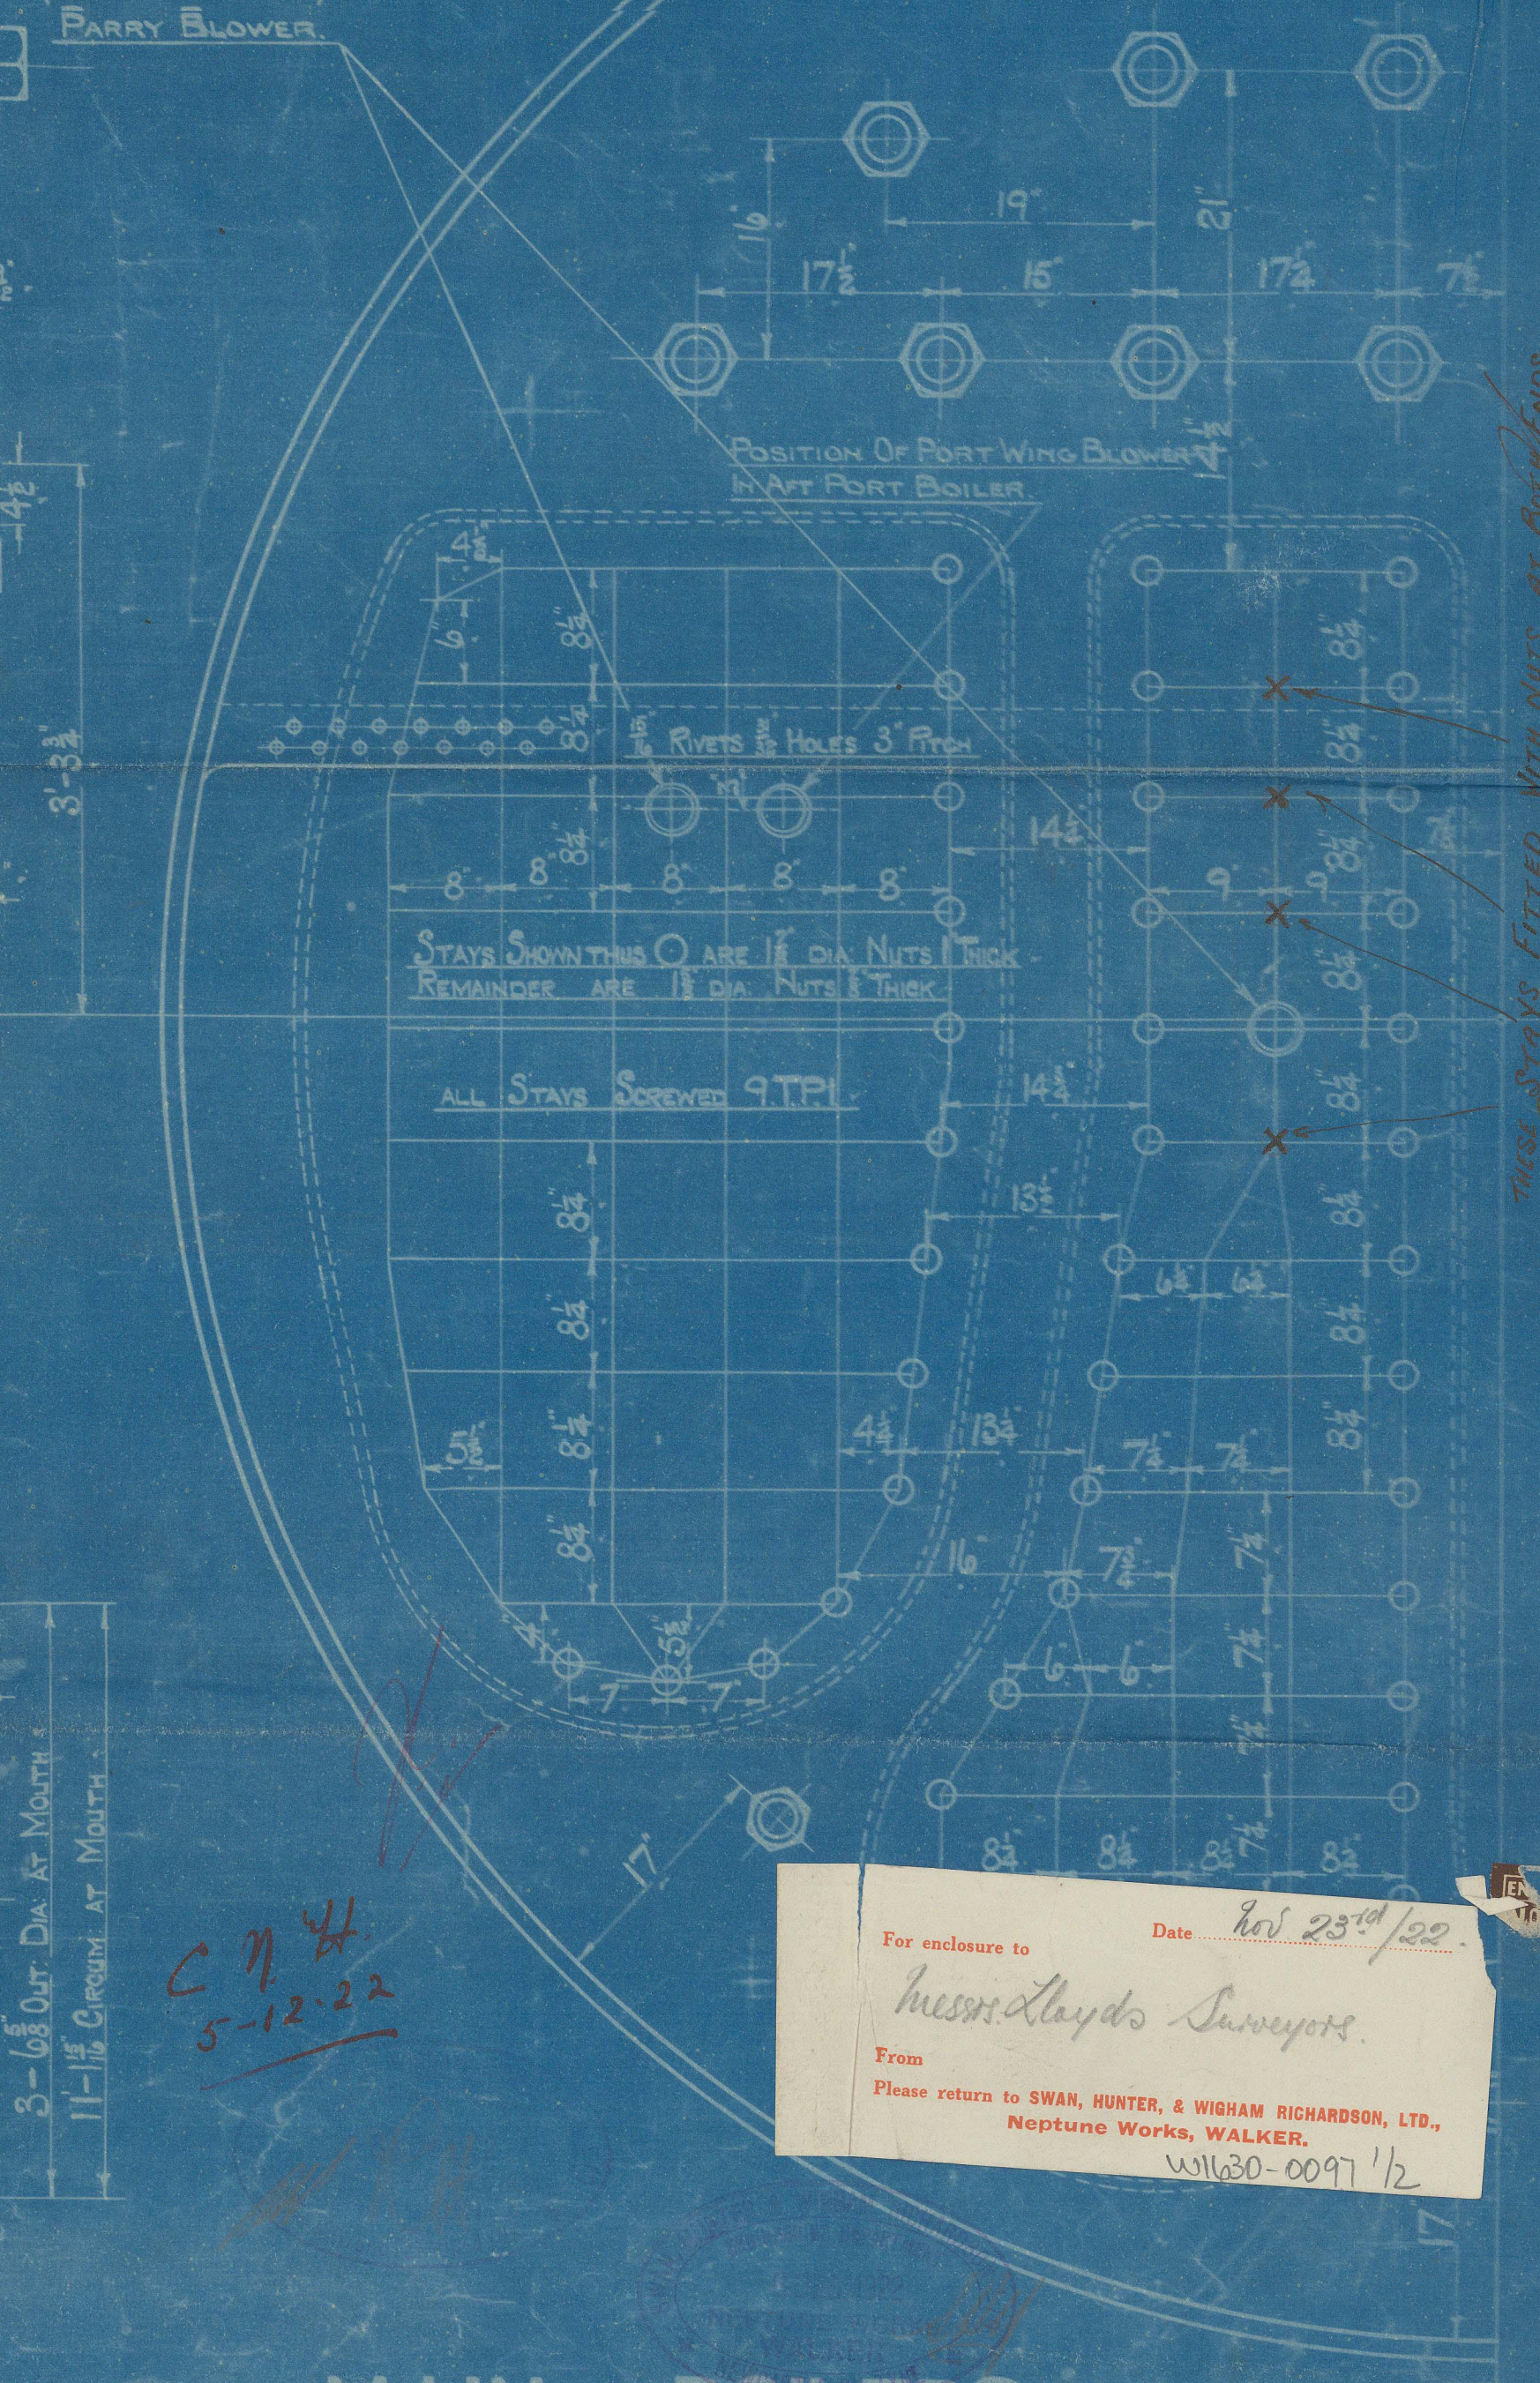



For enclosure to _____ Date Nov 23rd 1922
Messrs Attyds Solicyrs.
 From _____
 Please return to SWAN, HUNTER, & WIDHAM RICHARDSON, LTD.,
 Neptune Works, WALKER.
W11630-0097 1/2

MAIN BOILERS

Nº	DATE
----	------

Lloyd's Register

ALL PLATES OF STEEL
STAYS " "
RIVETS " "
TUBES OF IRON

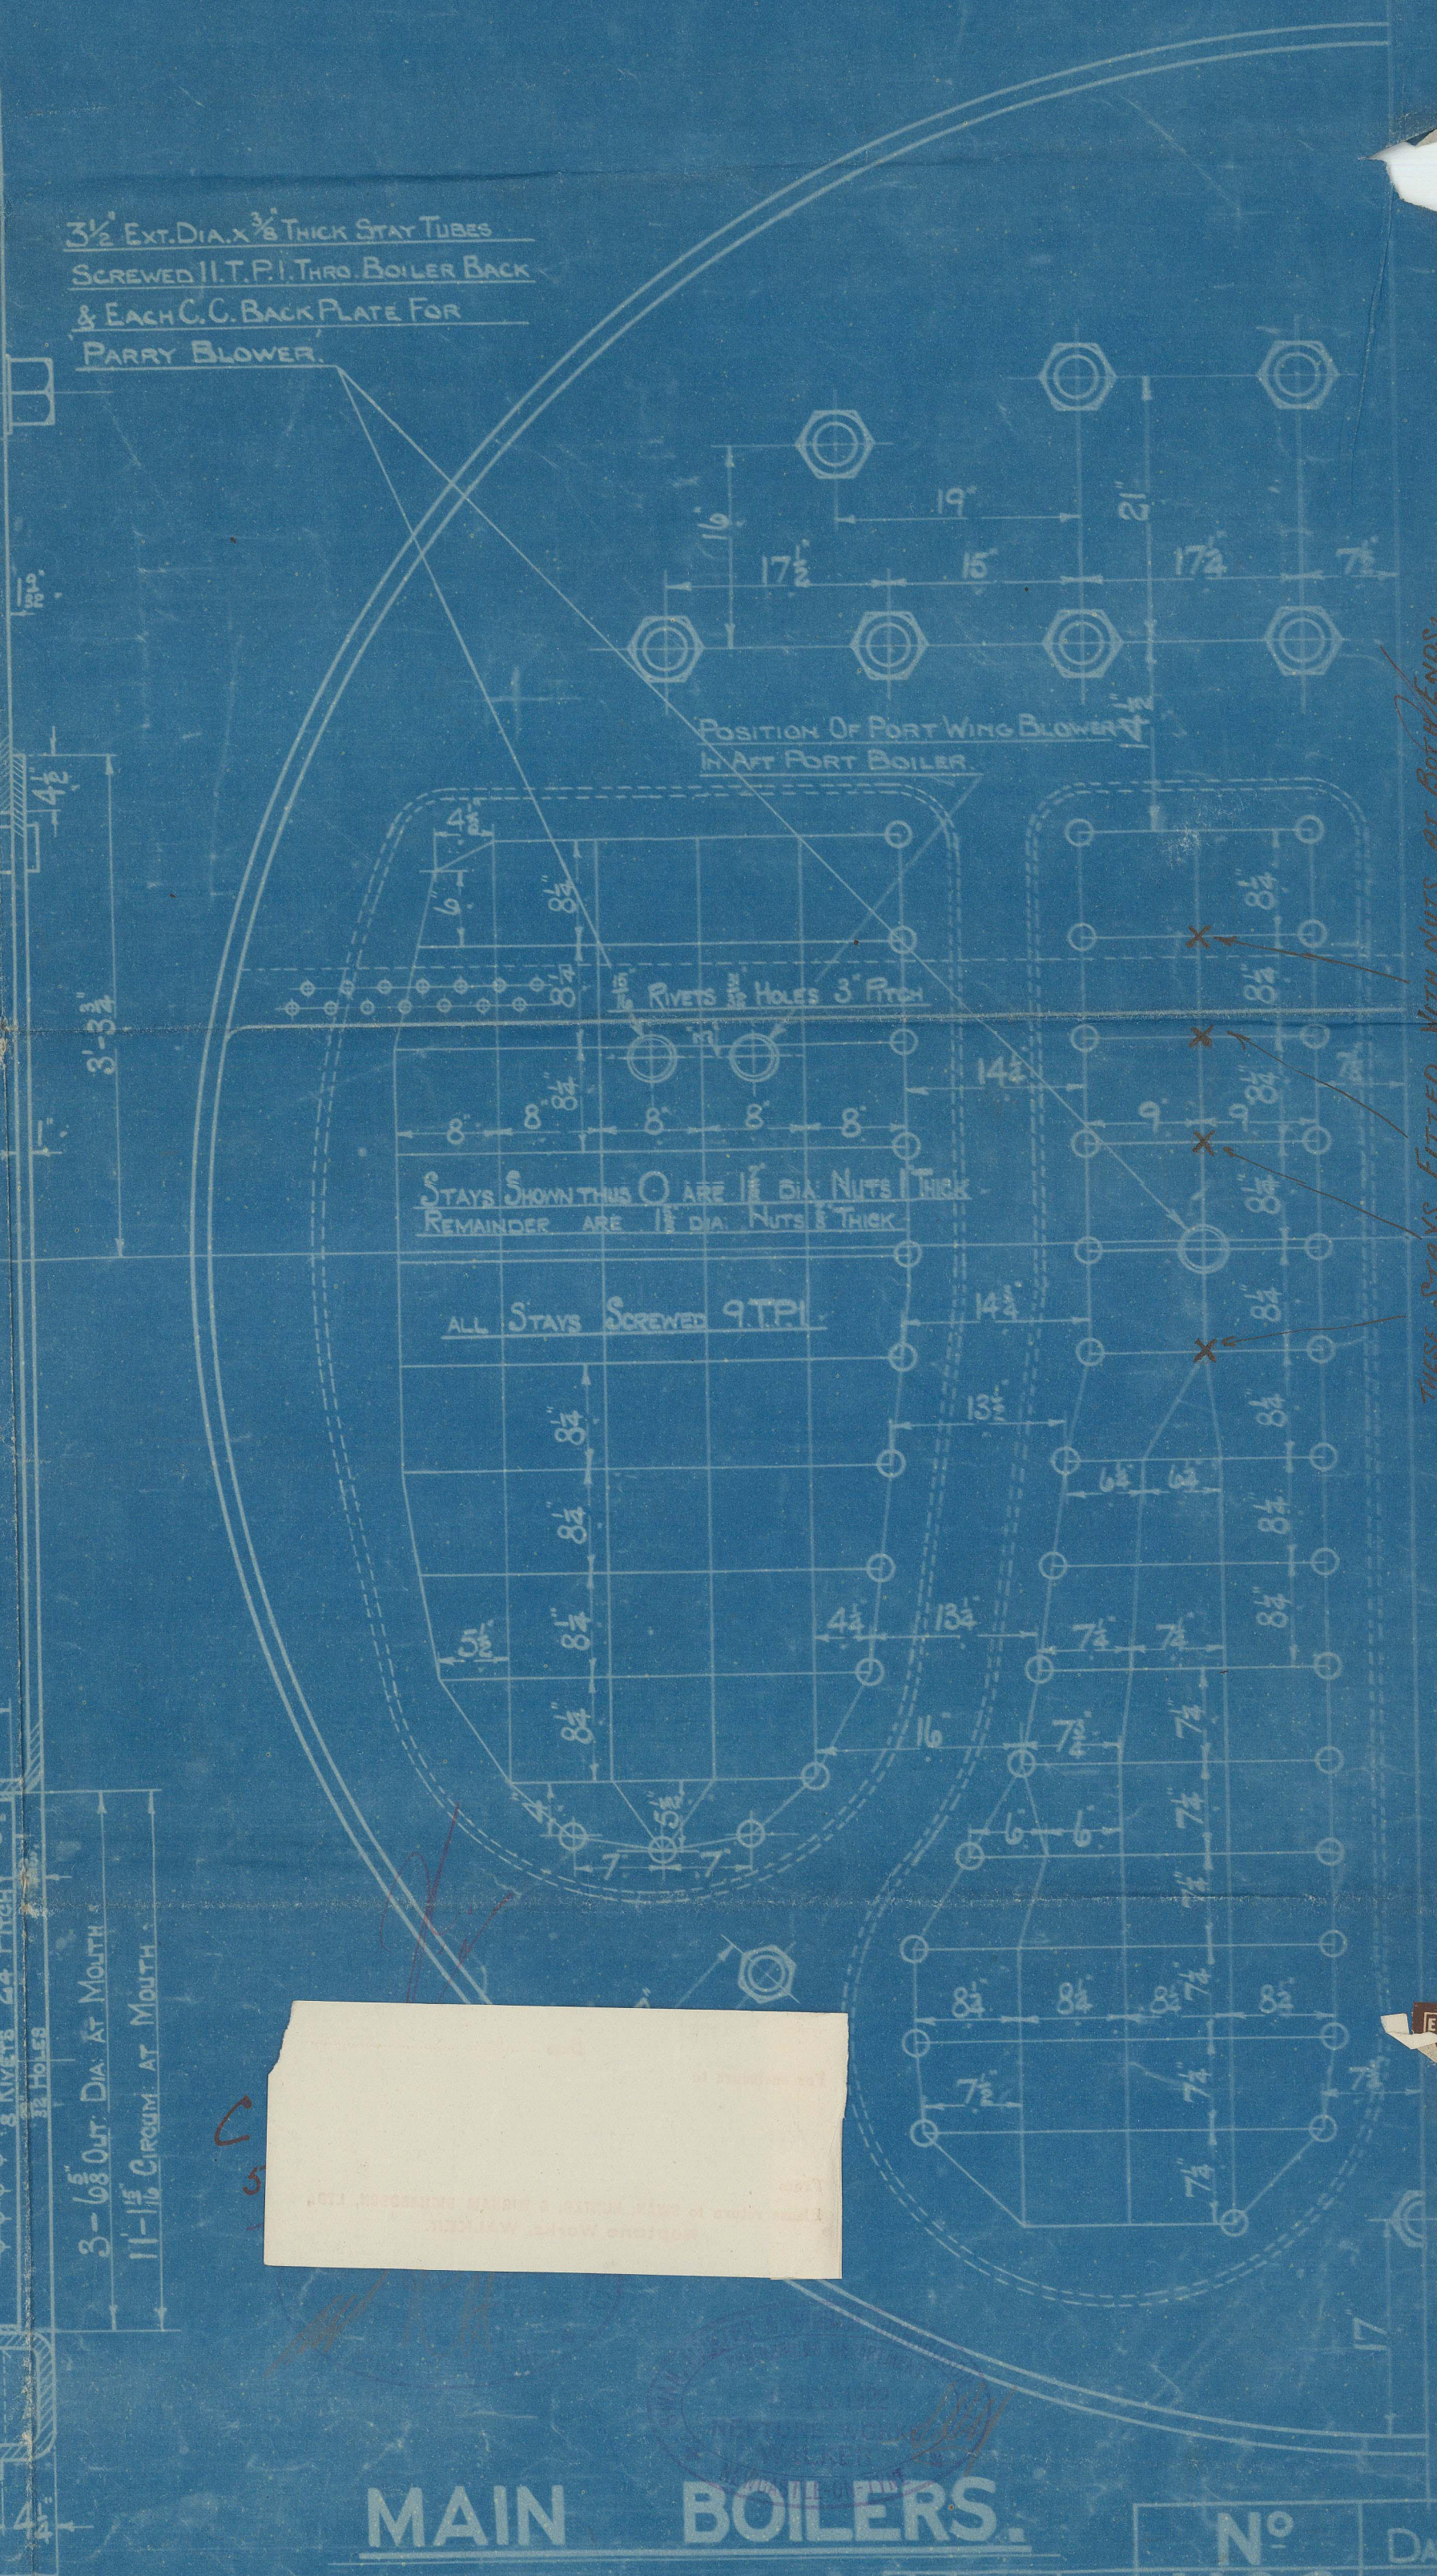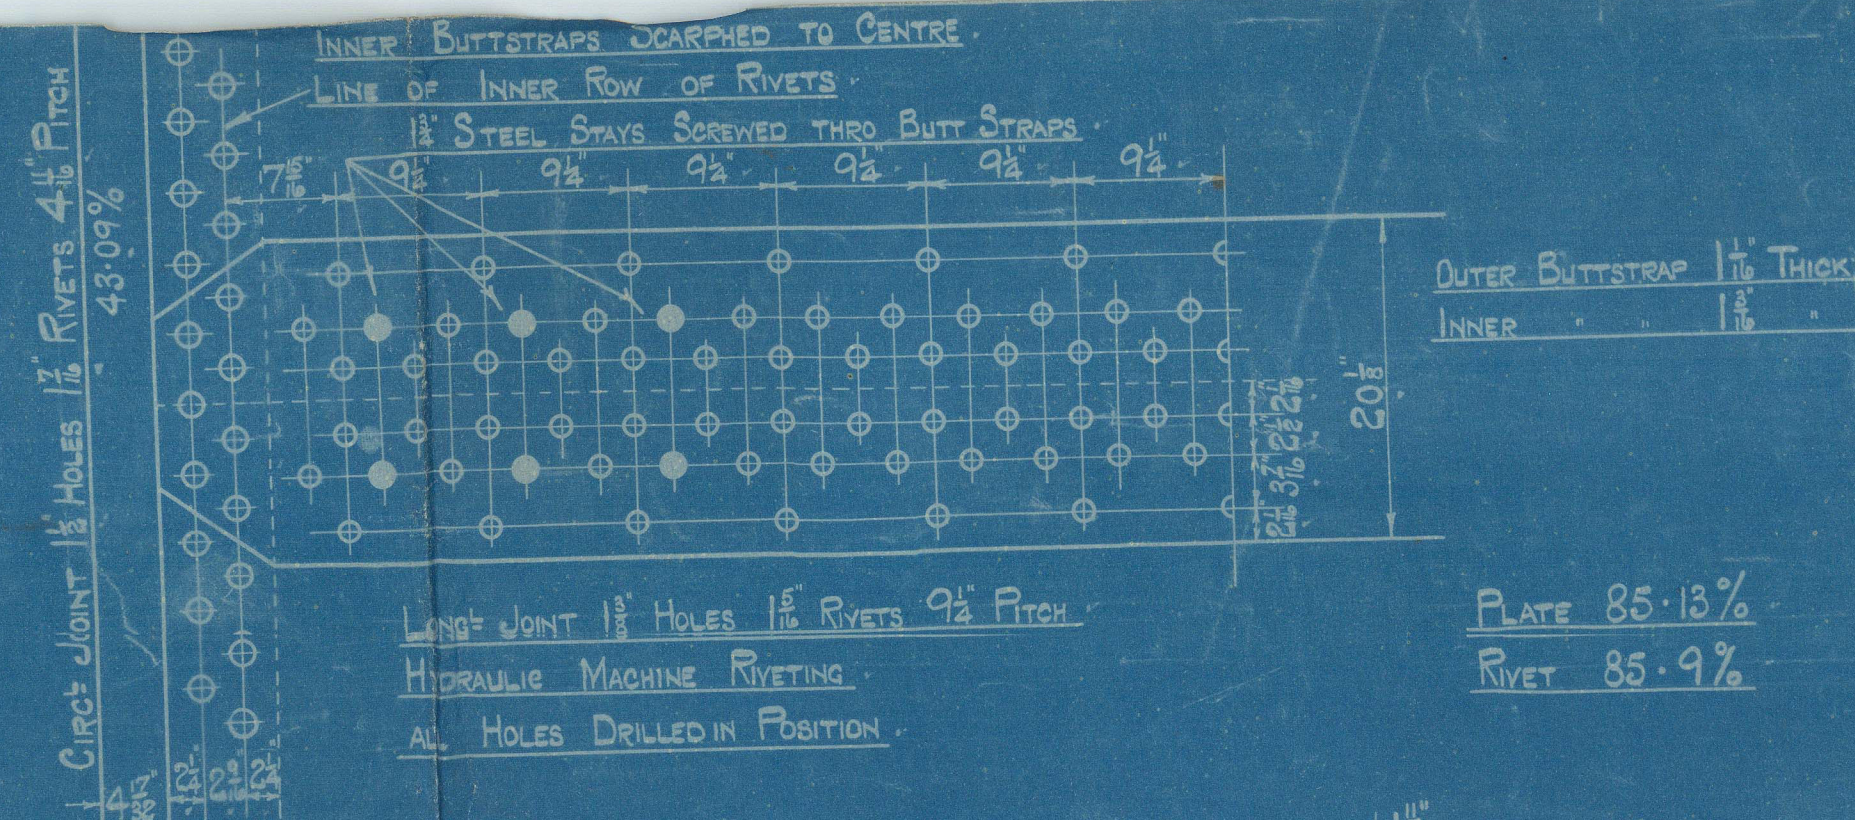

MAIN BOILERS

Lloyd's Reg
Foundation

1138

Suan Hunt, Hugham Richards
Plan B. 238 . (3) Main Boilers

W.P. 200 lbs

H₂ Test 360 lbs

Submitted to London. 28/11/22

Approved. 5. Dec 1922

S.H. & W.R. advised 6 Dec 22.

Ins in Cuckoo C Ch. looks twisted
disposed with Cuckoo & Magnets
being retained

London letter 8/2/23. LRS

S.H. & W.R. advised

9/2/23

V. A. "British Museum"

NEWCASTLE ON TYNE.

Report No.

47121

RETAIN

W1630

0097212

Lloyd's Register
Foundation