


2752

 

PROFILE AND DECKS.  
DIMENSIONS 440'-0" B.P. x 56'-9" M.L.P. x 33'-11" M.L.P. TO UPPER DECK.  
SCALE 1/8" = 1' FT.  
ISHERWOOD SYSTEM PATENT.  
N° 1138.

BRIDGE SIDE PLATING CARRIED DOWN TO  
DECK AT BRIDGE ENDS INCREASED TO .98 FOR MAX. FRAME SPACING  
SHEERSTRAKE 1.06" AT BRIDGE ENDS  
BRIDGE SIDE PLATING AT BRIDGE ENDS .50" FOR MAX. FRAME SPACING .58

These thicknesses shown for upper of stringer  
and depending on Lloyd's scantlings only  
See Table of Owners Extra actually fitted

WALKER  
4-7-22  
WALKER  
WALKER



Profiles

Sirvan Hunter & W. A. Lee S.S. No 1138

Newcastle on Tyne


S. S. "British Hussar"

NEWCASTLE ON TYNE.

Report No. 44121

PROFILE & DECKS.

RETAIN

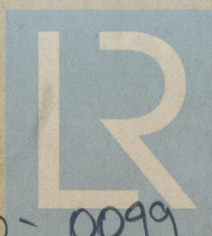

W1630-0099

© 2021

Lloyd's Register  
Foundation