



11.5.50.



Schaal 1:50	1:25	Datum	Betref
Geschied	21/5/50		
Gecontroleerd			
Gezien			
CONSTRUCTIE PLAN I (LANGPLAN)			
N.V. ZAAANLANDSCHE SCHEEPSB.M.J. - ZAANDAM			
No. 454-5			
Onder No. 147590			

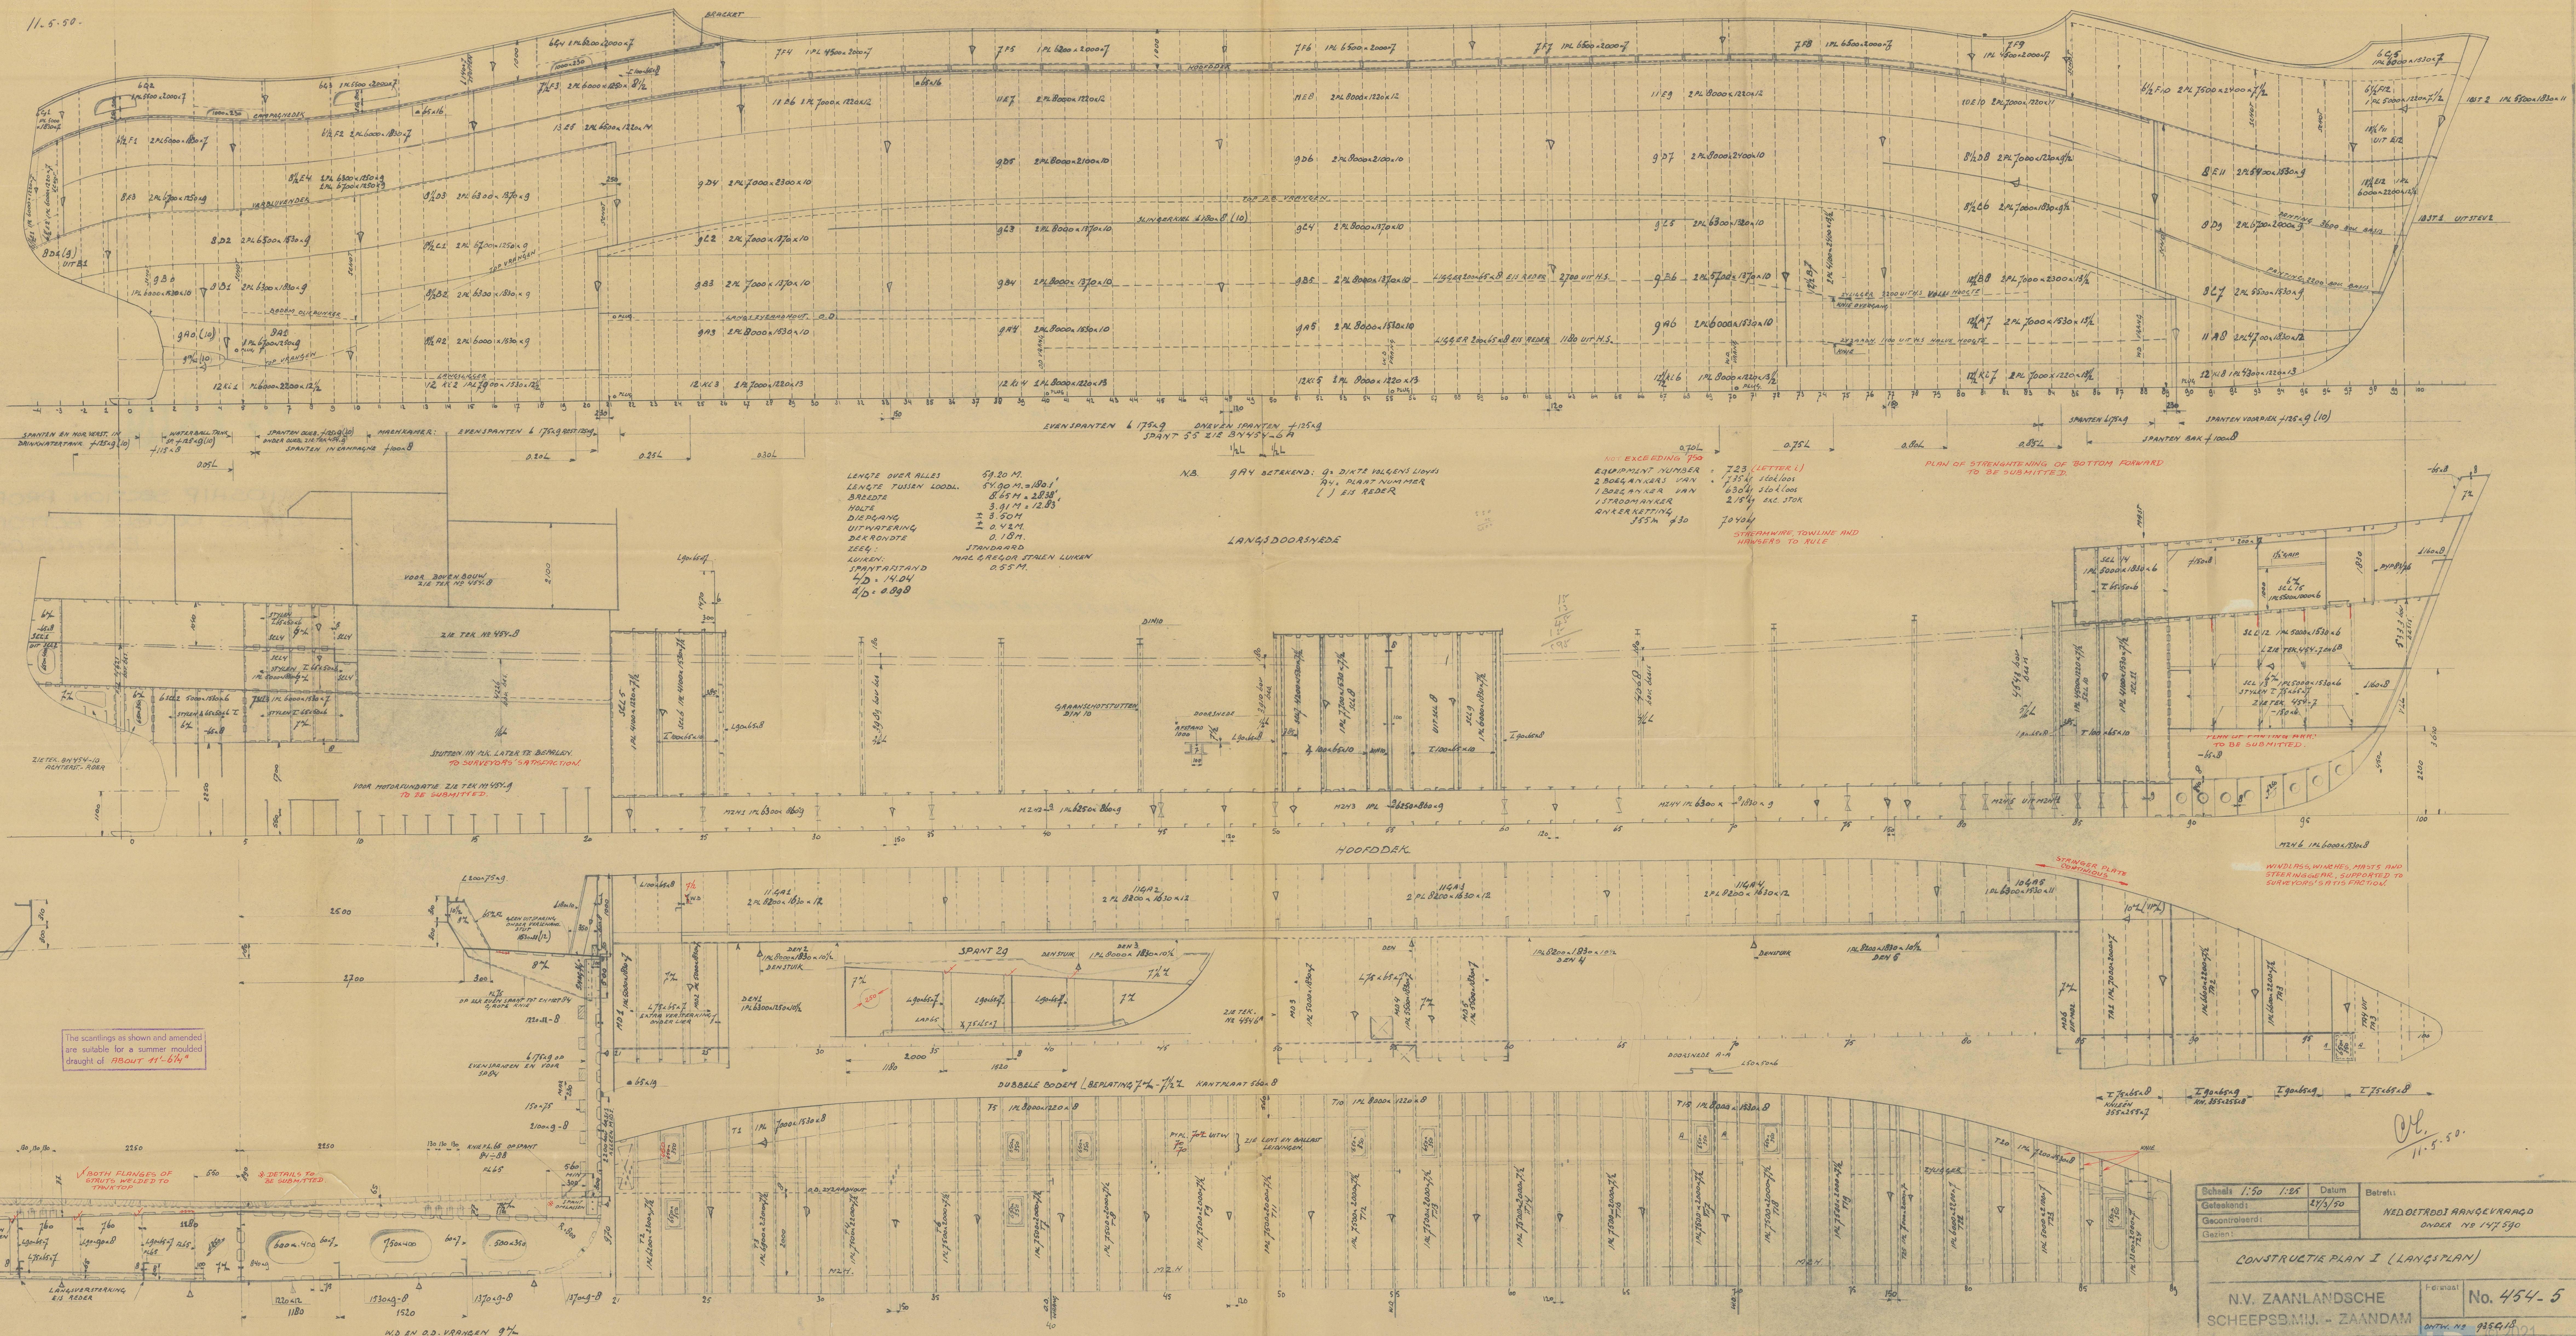

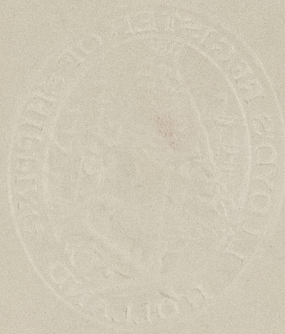

R.P.S. \*

RECORDS DEPT.,  
LONDON

3

ZAANLANDSCHE SCHEEPS.

YARD N° 454

MIDSHIP SECTION, PROFILE &  
DECKS, DOUBLE BOTTOM, SHELL  
EXPANSION

© 2021

V1631-0083

Lloyd's Register  
Foundation



2.  
N.V. ZAAHLANDSCHE  
SCHEEDSBOUW MY

YARD No 454.

MIDSHIP SECTION.  
PROFILE.

DECKS.

DOUBLE BOTTOM.

SHELL EXPANSION.

0083



© 2021

Lloyd's Register  
Foundation