
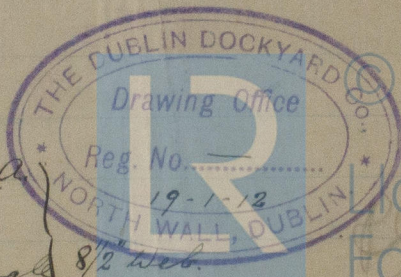


Watergate
watergate
plans

Scantlings of Frame Legs
as Approved
S.S. No 17

Frames in Fore and after Peaks $4 \times 3 \times 34$ Angles
 Frames in C + B Space nos 6 to 32. $5\frac{1}{2} \times 3 \times 36$ Bull Angs
 Frames in Way of R.Q Sk nos 32 to 52. $4\frac{1}{2} \times 3 \times 44$ " "
 Frames in Way of Main Deck nos 52 to 78. $4\frac{1}{2} \times 3 \times 720$ " "

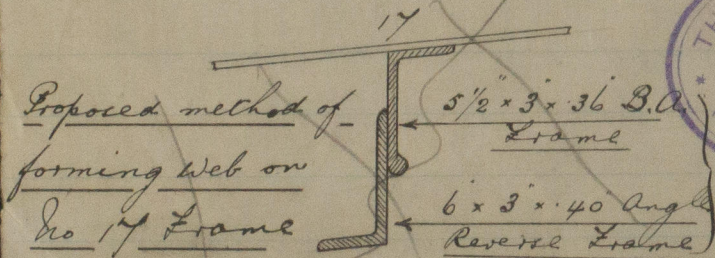

2020
 Lloyd's Register
 Foundation