


12.1.12
22.1.12
22.3.12
10.6.12

PROFILE & DECK PLANS.



S. S. N° 77.

DIMENSIONS - 162 OBP - 25.6 - 12.0 M

Scale 1/8 = 1 Foot

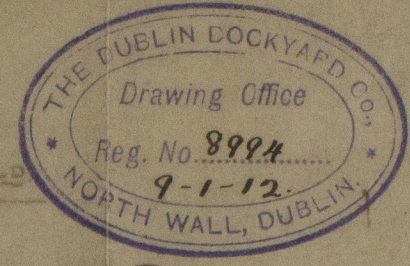

APPROXIMATE PARTICULARS FOR FULLBOARD
REGISTERED DIMENSIONS 162-0 - 25-6 - 12-0
UNDER DECK TONNAGE APPROX - 305 TONS.
SHEER AT STEER 4-6 1/2 FROM STEER 2-3-2
SHEER AT STEER 2-6 1/2 FROM STEER 1-4-2
BRIDGE AND FUNNEL CLOSED.

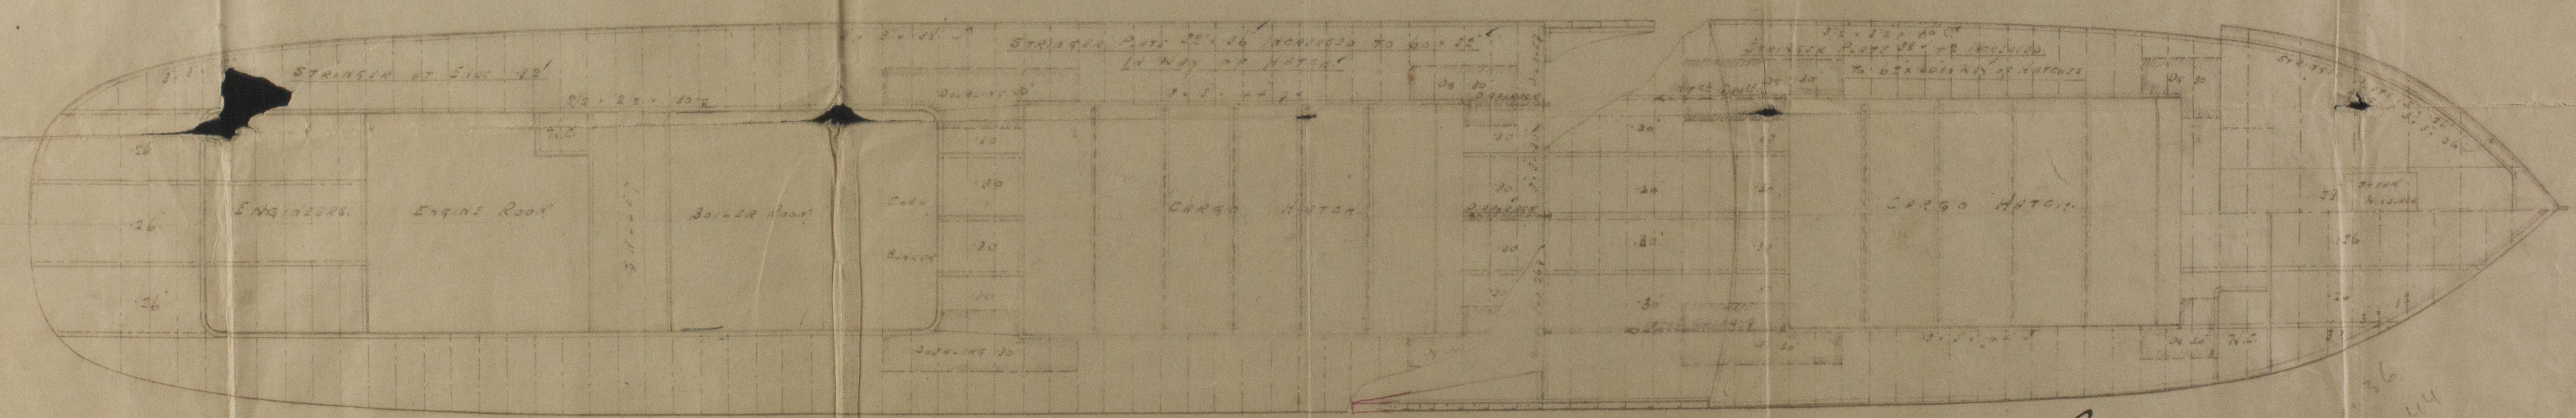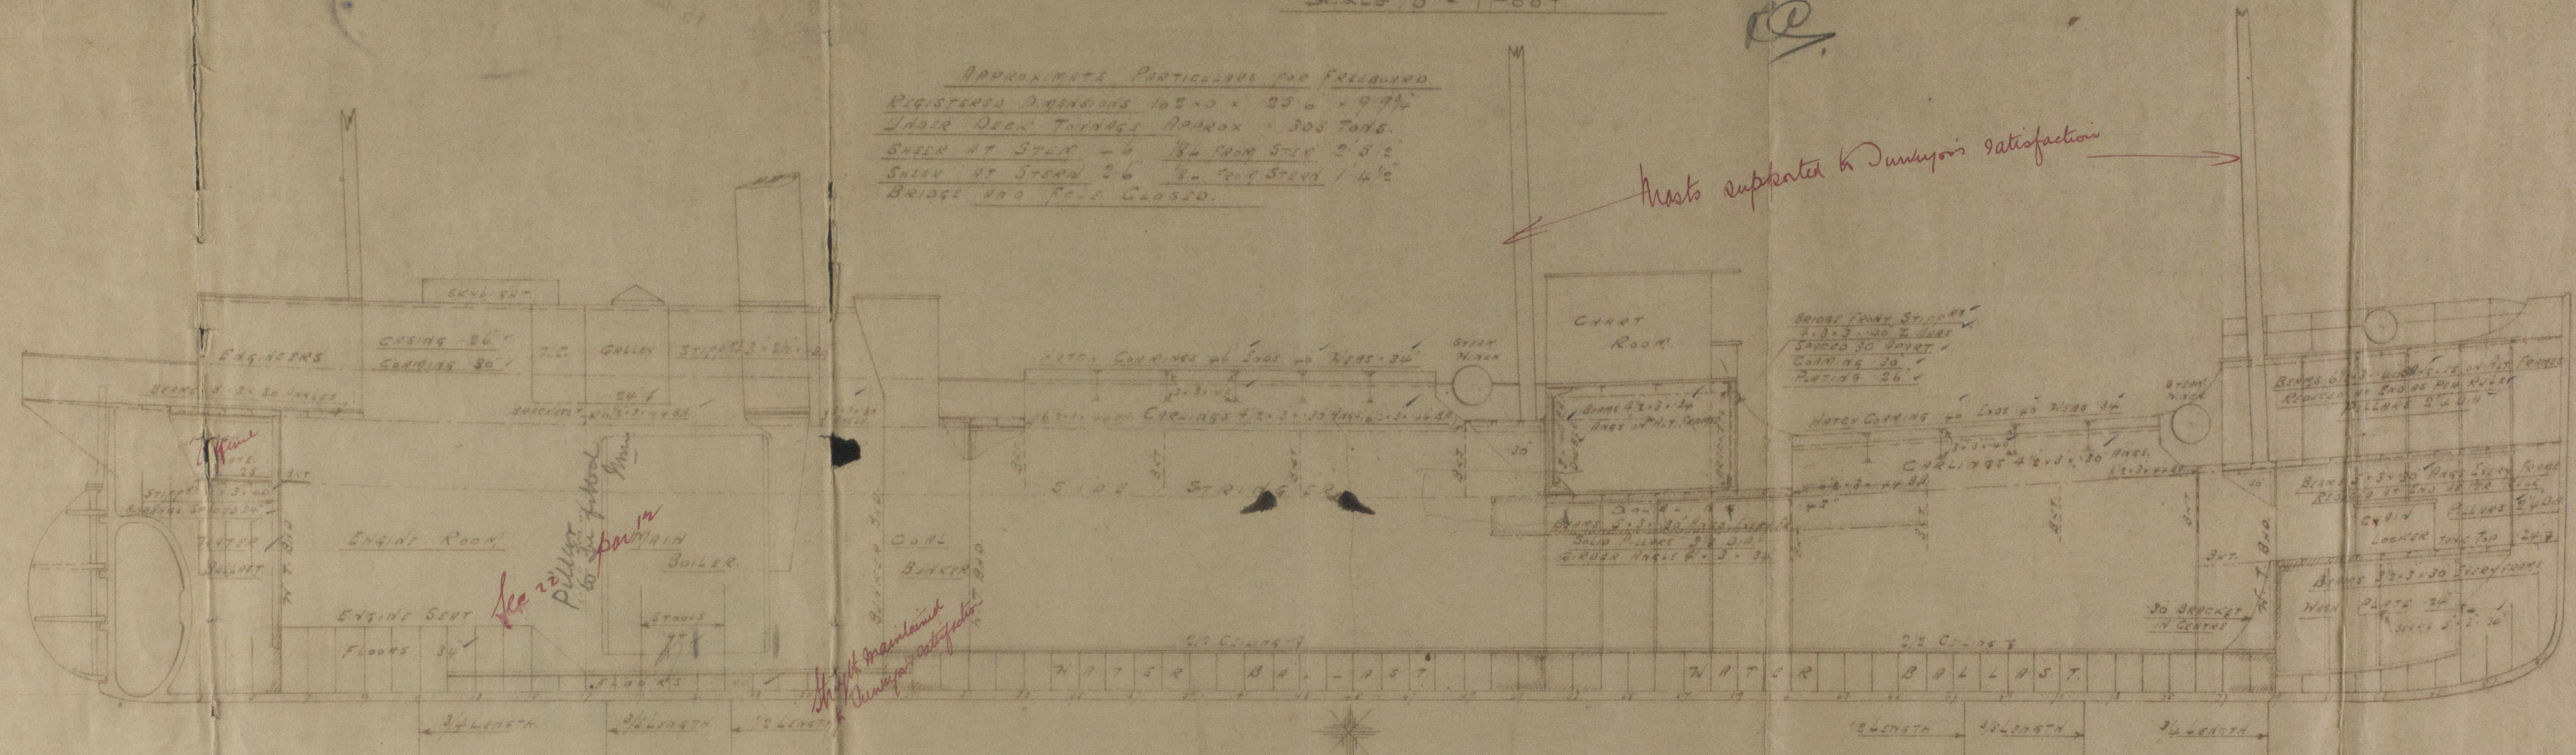

C.B.
12.1.12.

Amended
Profile & Deck Plan

Watersgate ex 77. Out 10/1/12
SS Wheatlands

RECEIVED
22 JAN. 1912
LONDON

RECEIVED
15 JAN 1912
LONDON

RECEIVED
11 JAN 1912
LONDON

RECEIVED
10 MAY 1912
LONDON

RECEIVED
21 MAR 1912
LONDON

RECEIVED
17 FEB. 1912
LONDON

RECEIVED
7 JAN 1912
LONDON

RECEIVED
19 JUL 1912
LONDON

RETAIN

W1641-0054



© 2020

Lloyd's Register
Foundation