



1135. S.S. "Beland"
No. 1101, 21, 23, 39, 41, 43.

PROFILE & DECK PLANS.

BUILDERS DIMENSIONS: 400'0" P x 52'0" M x 31'0" H

TO CLASS ~~100-A~~ ~~1100~~ REGISTER

SCALE $\frac{1}{8}$ " = 1' FOOT.

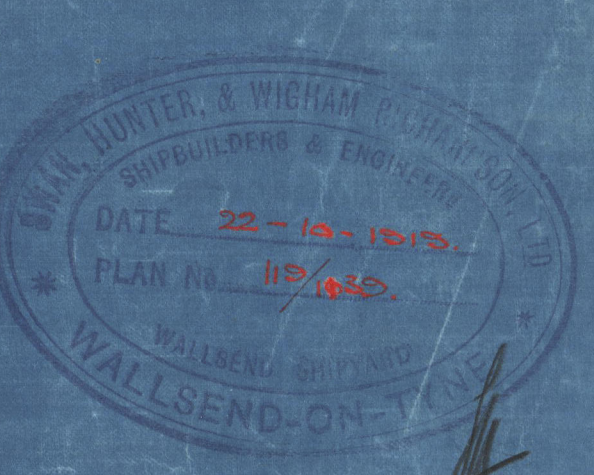 

16th APRIL 1915
1101

Swan Hunter & Wigham Richardson

S.S. 1139

Profile and deck plans.

as built

72406

WED. 29 OCT. 1919

Empire Activities

S. S. BELGIAN

NEWCASTLE ON TYNE.

Report No. 72406

X1165- 0011



© 2021

Lloyd's Register
Foundation