


9770

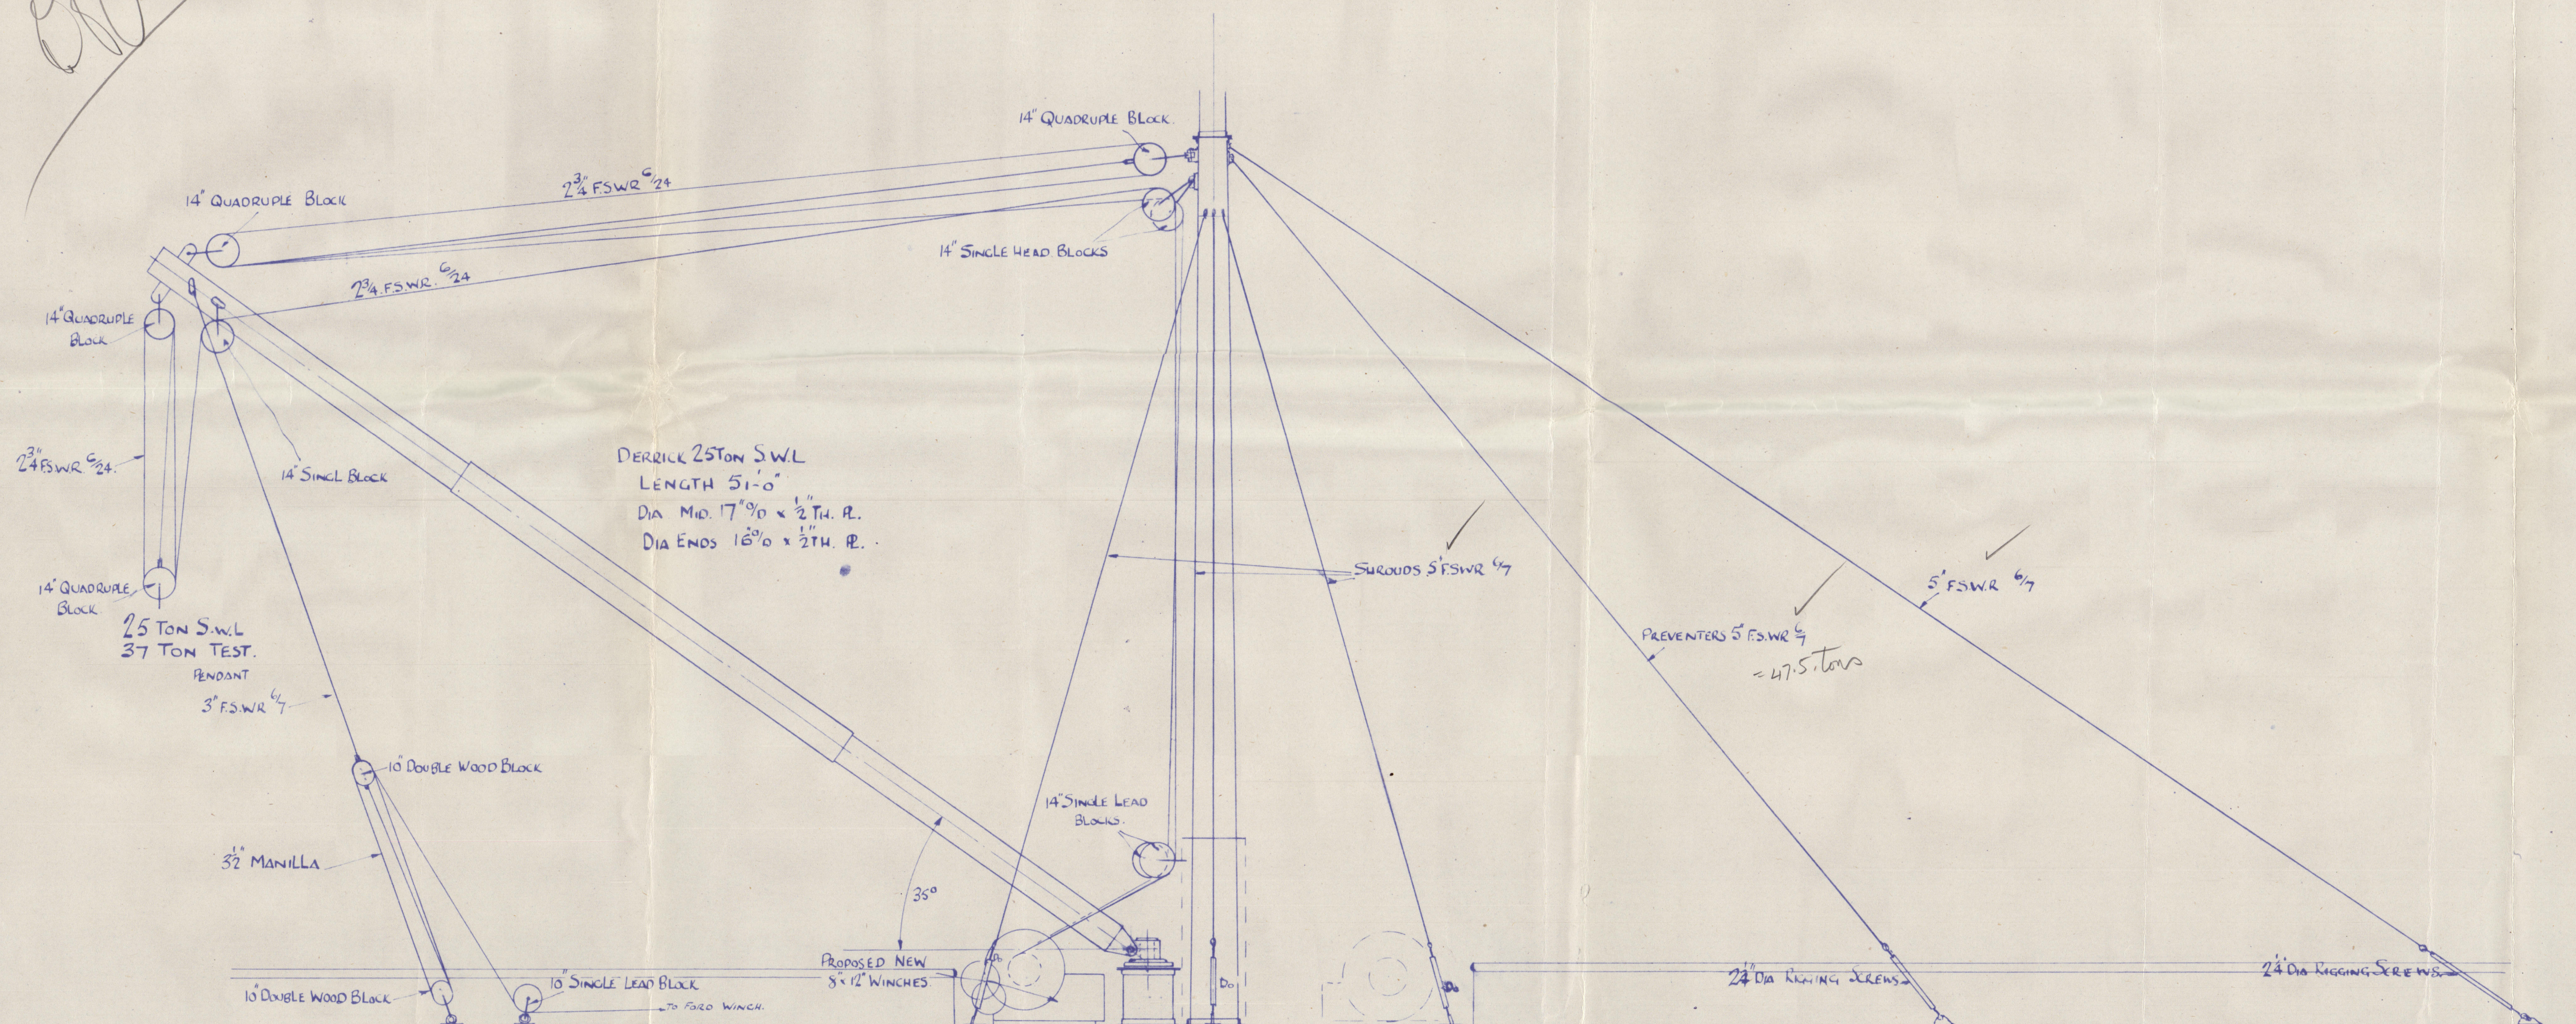


DERRICK 25TON SWL
LENGTH 51'-0"
DIA MID. 17 1/2" x 1/2" T.H. R.
DIA ENDS 16 1/2" x 1/2" T.H. R.

Rule normal loading 3 chords 0.3" = 701 x 3 = 21.18 m"
Prop'd 3 C 5" = 196 x 3 = 58.8
 $\frac{58.8}{21.18} = 2.8$ times Rule

Plan dealt with
for chords only

2 L. Longo	19.6' 42"
1 1/2" dia. block	"
1 1/2" dia. block	19.6' 42"

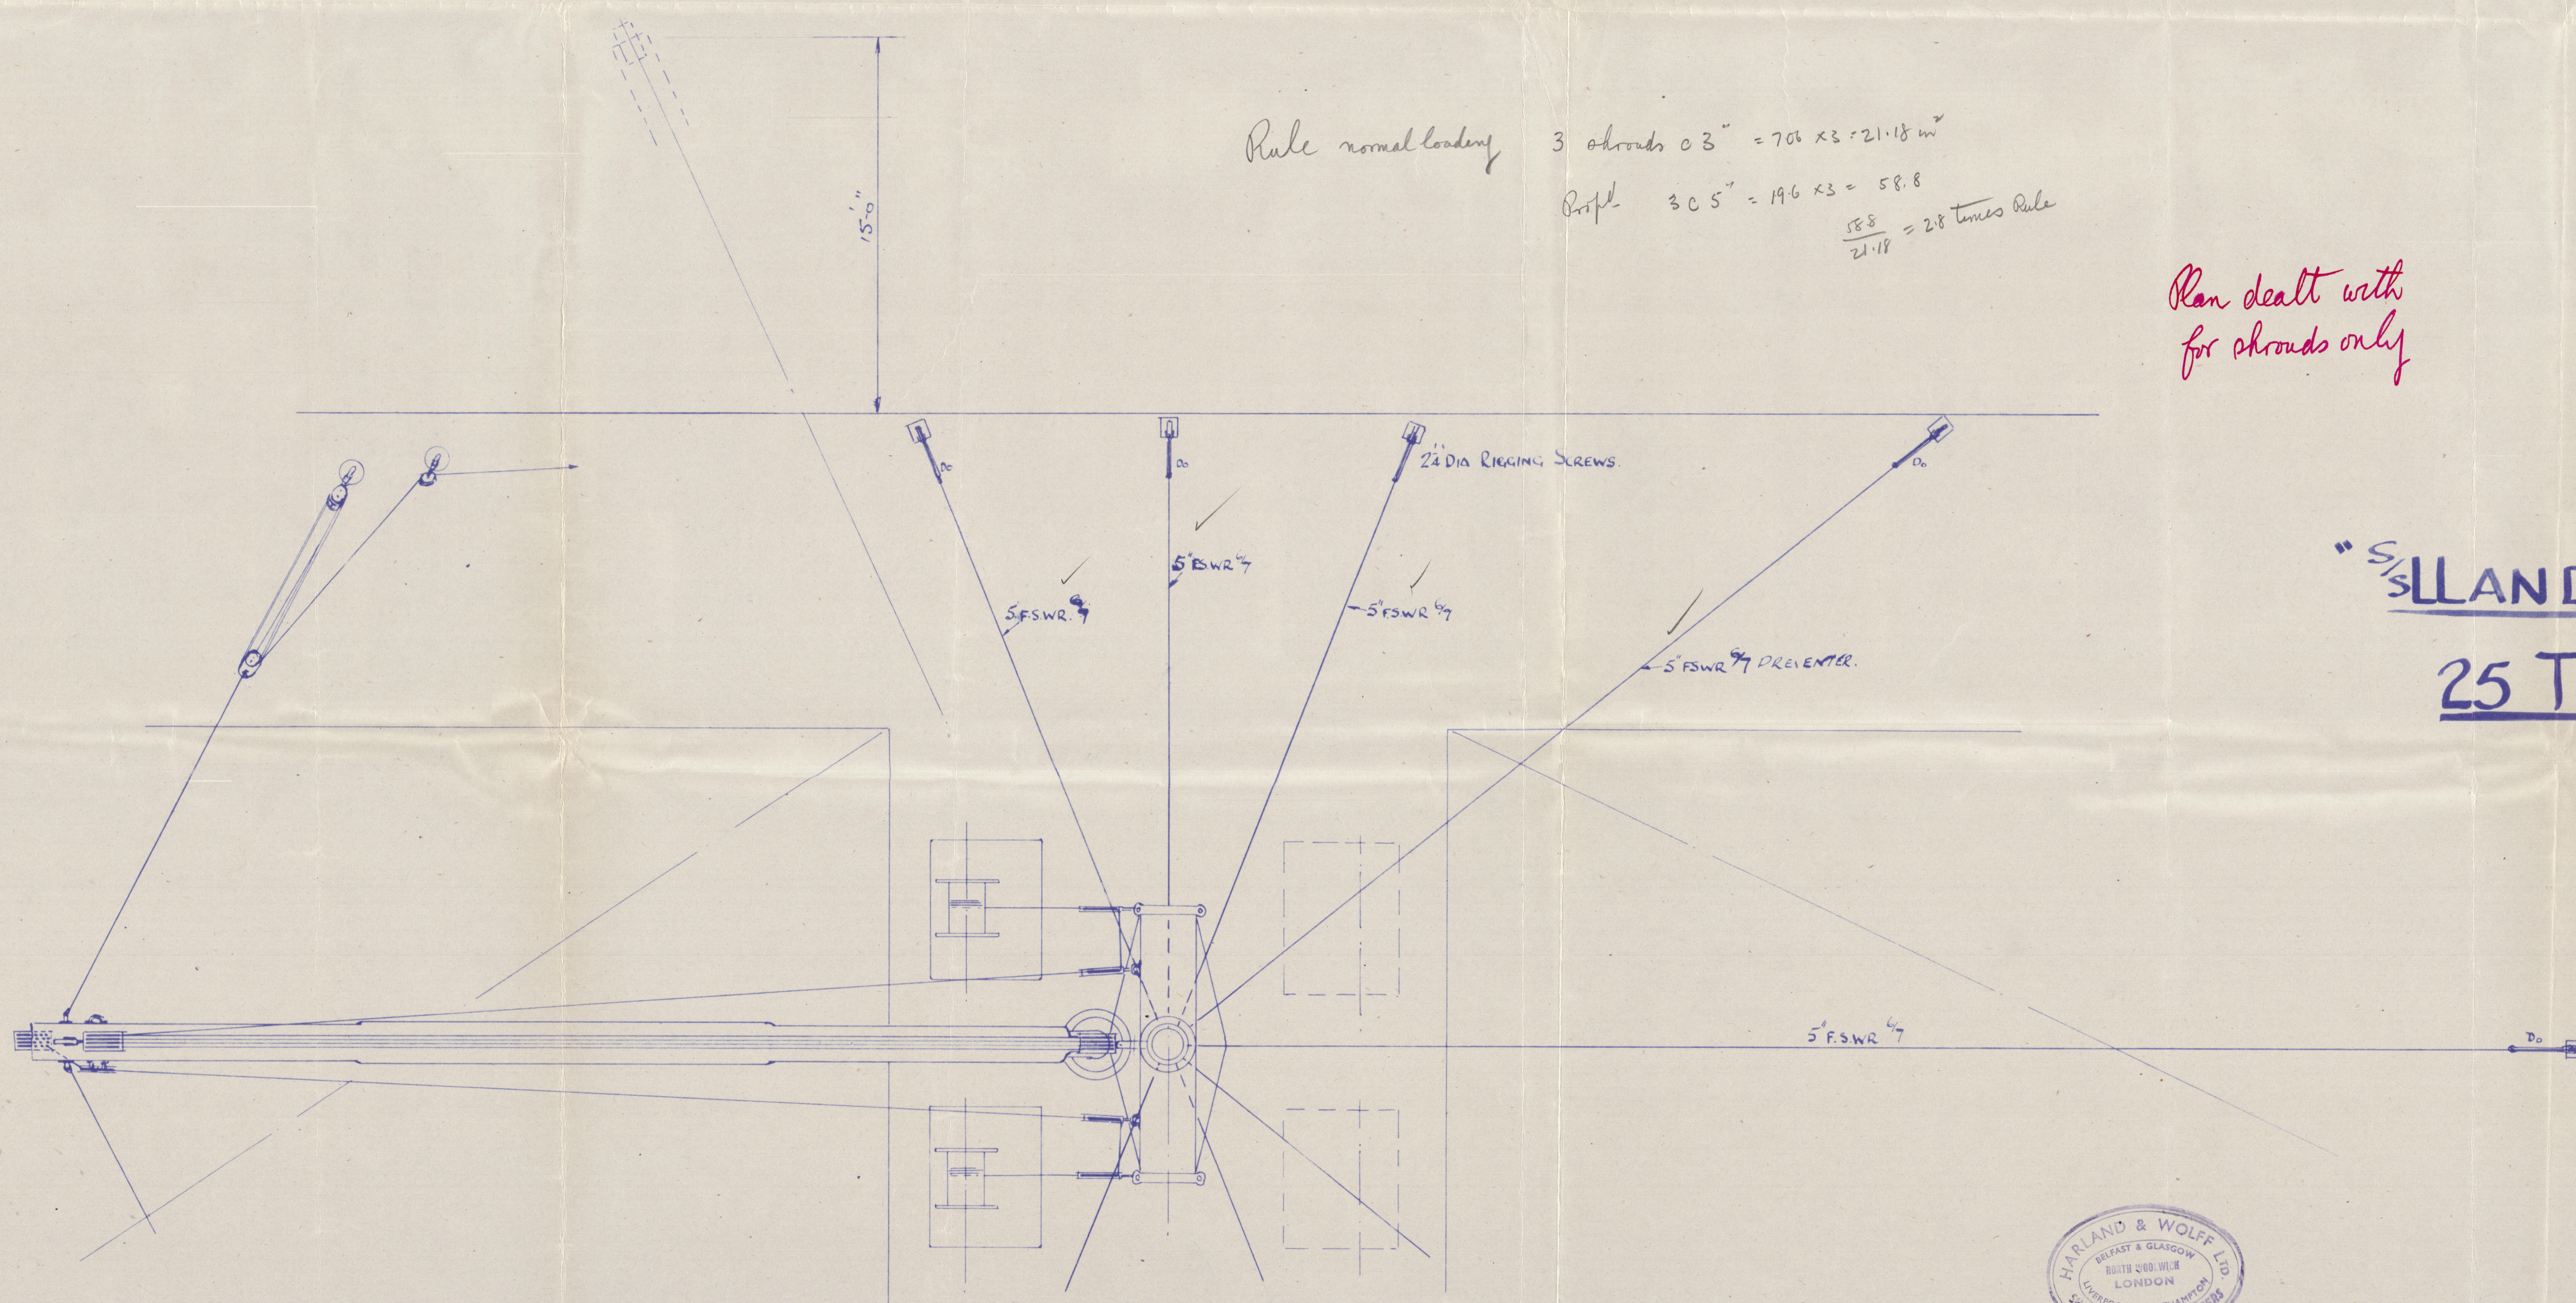

"SILLANDILO"

25 TON DERRICK ARRANG^T

Scale 1/4" = 1 FT.

W.J.
21.5.42



9770

W191-0022

LLANDILO

Don rept No. 110584.

25-ton derrick on
fore mast

Rigging



© 2019

Lloyd's Register
Foundation