
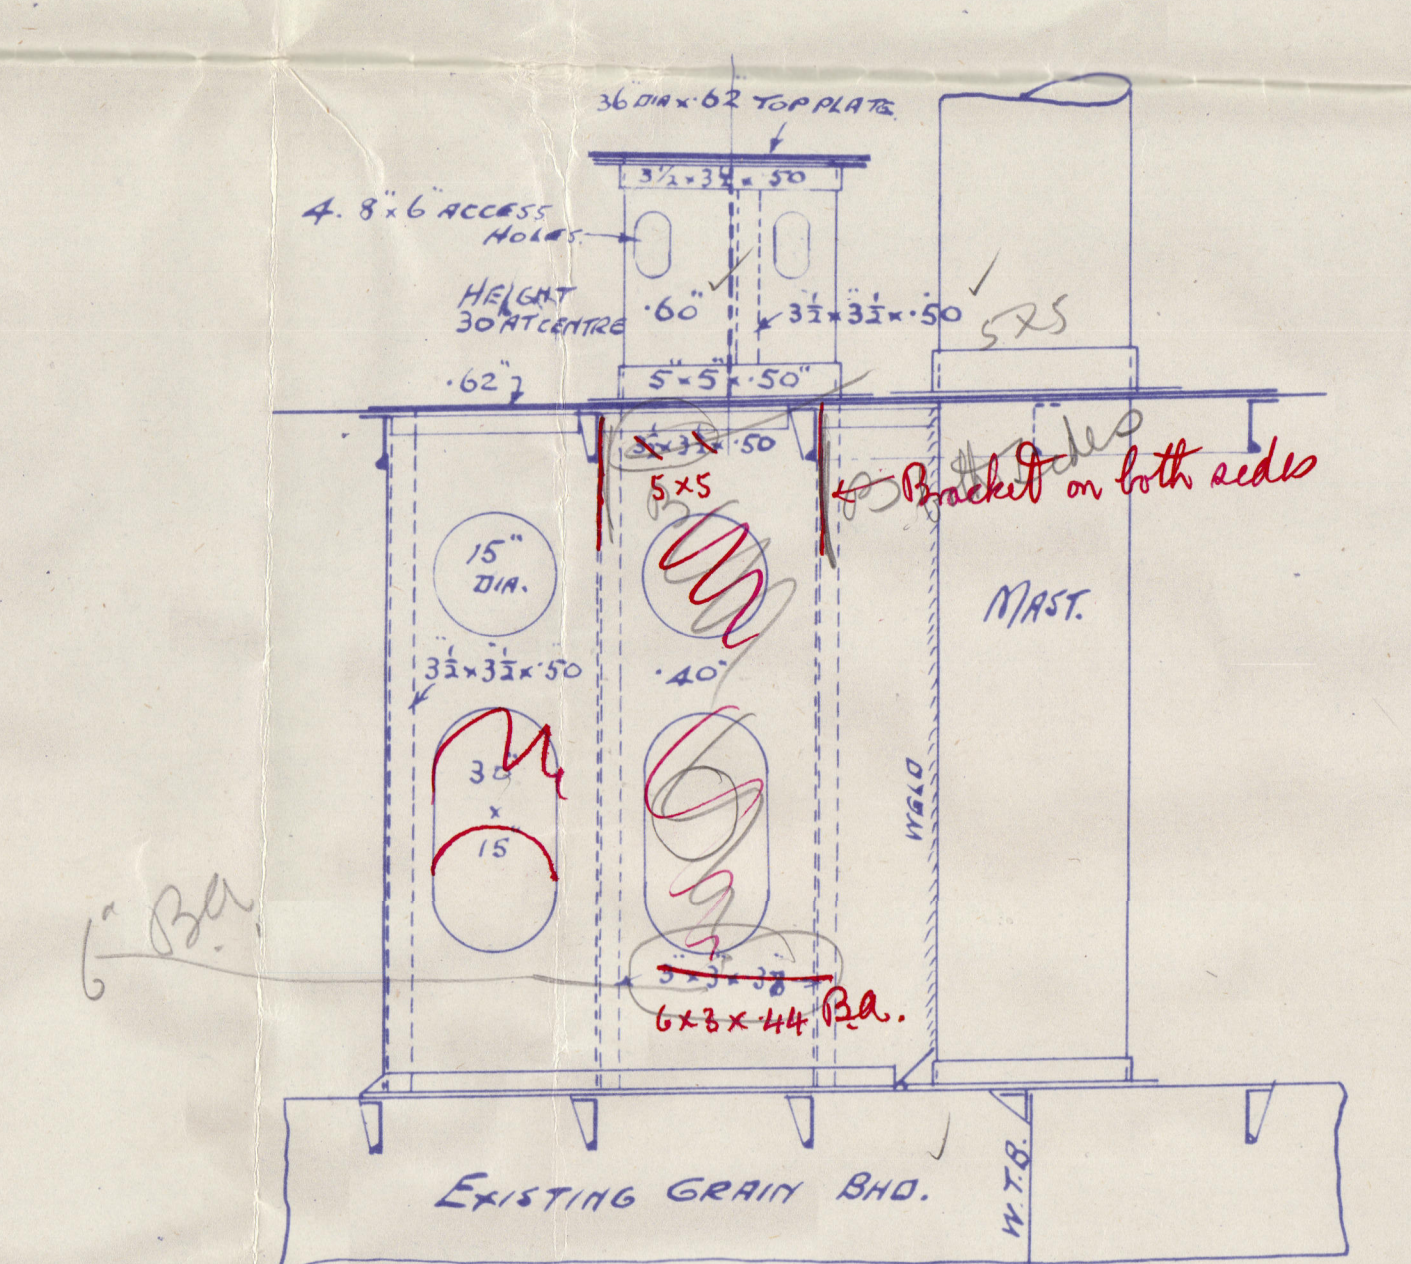
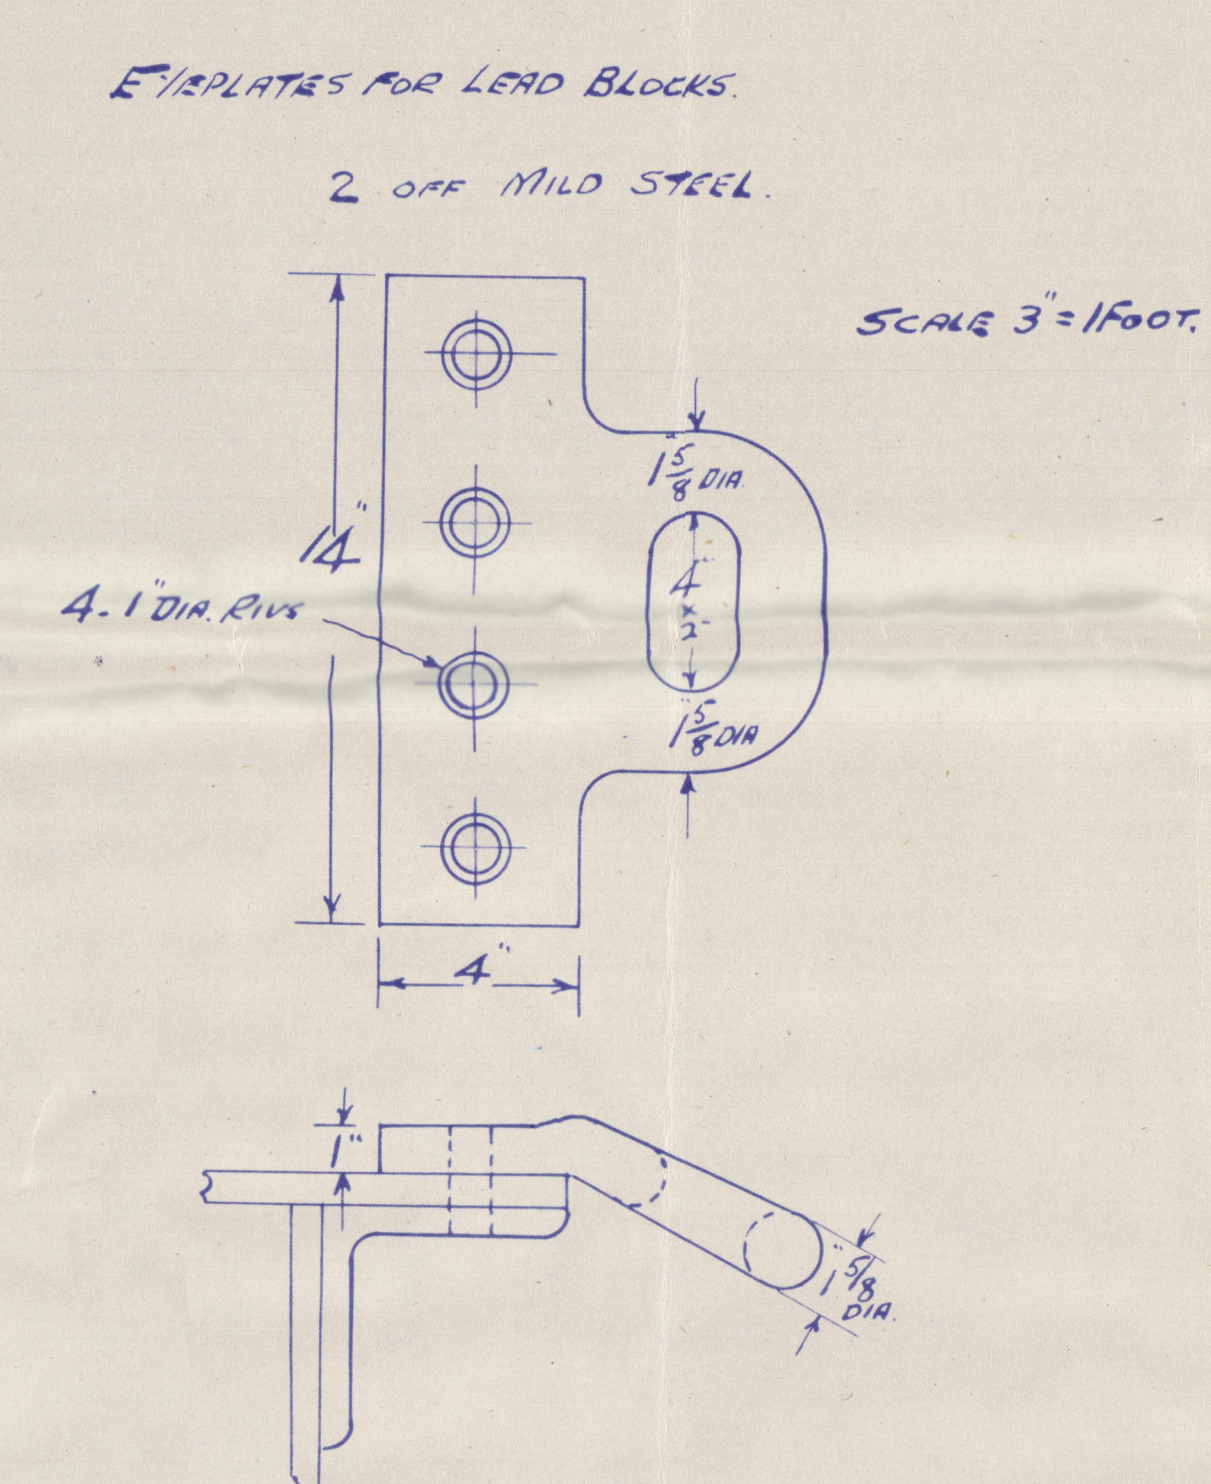
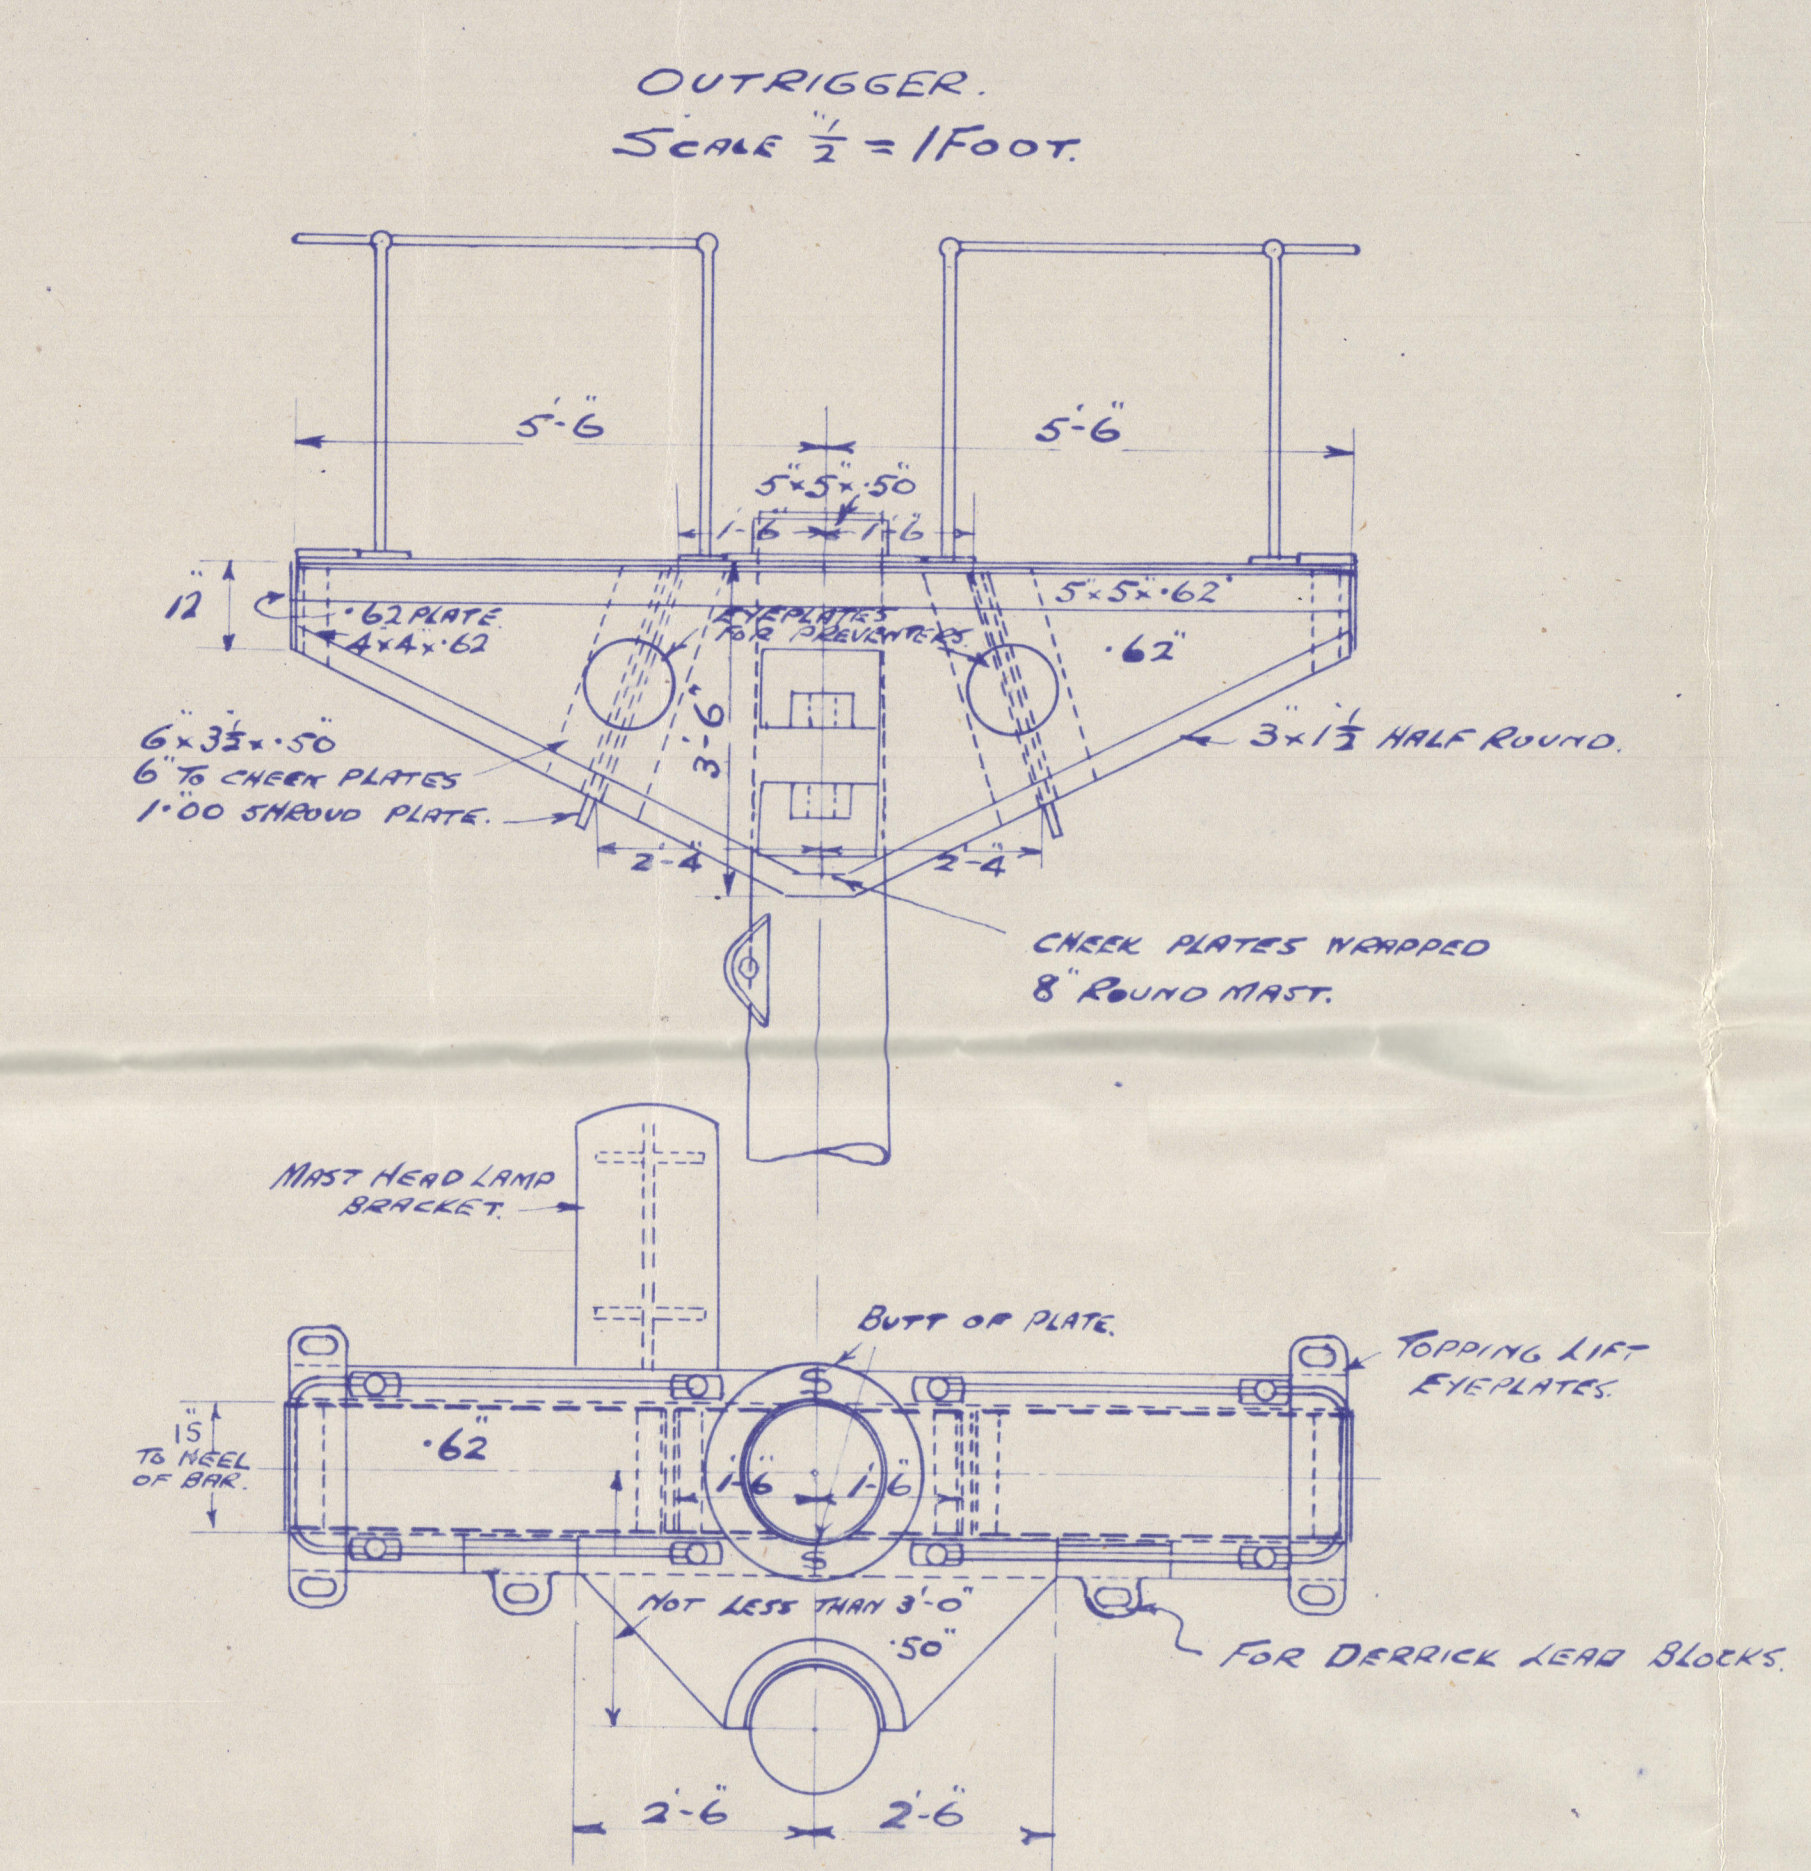
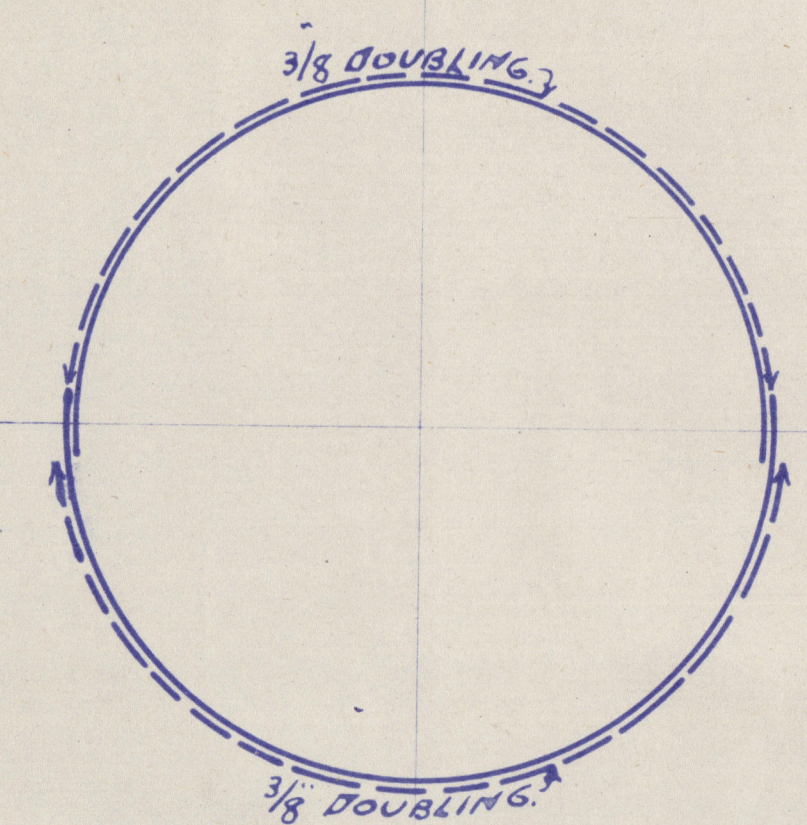
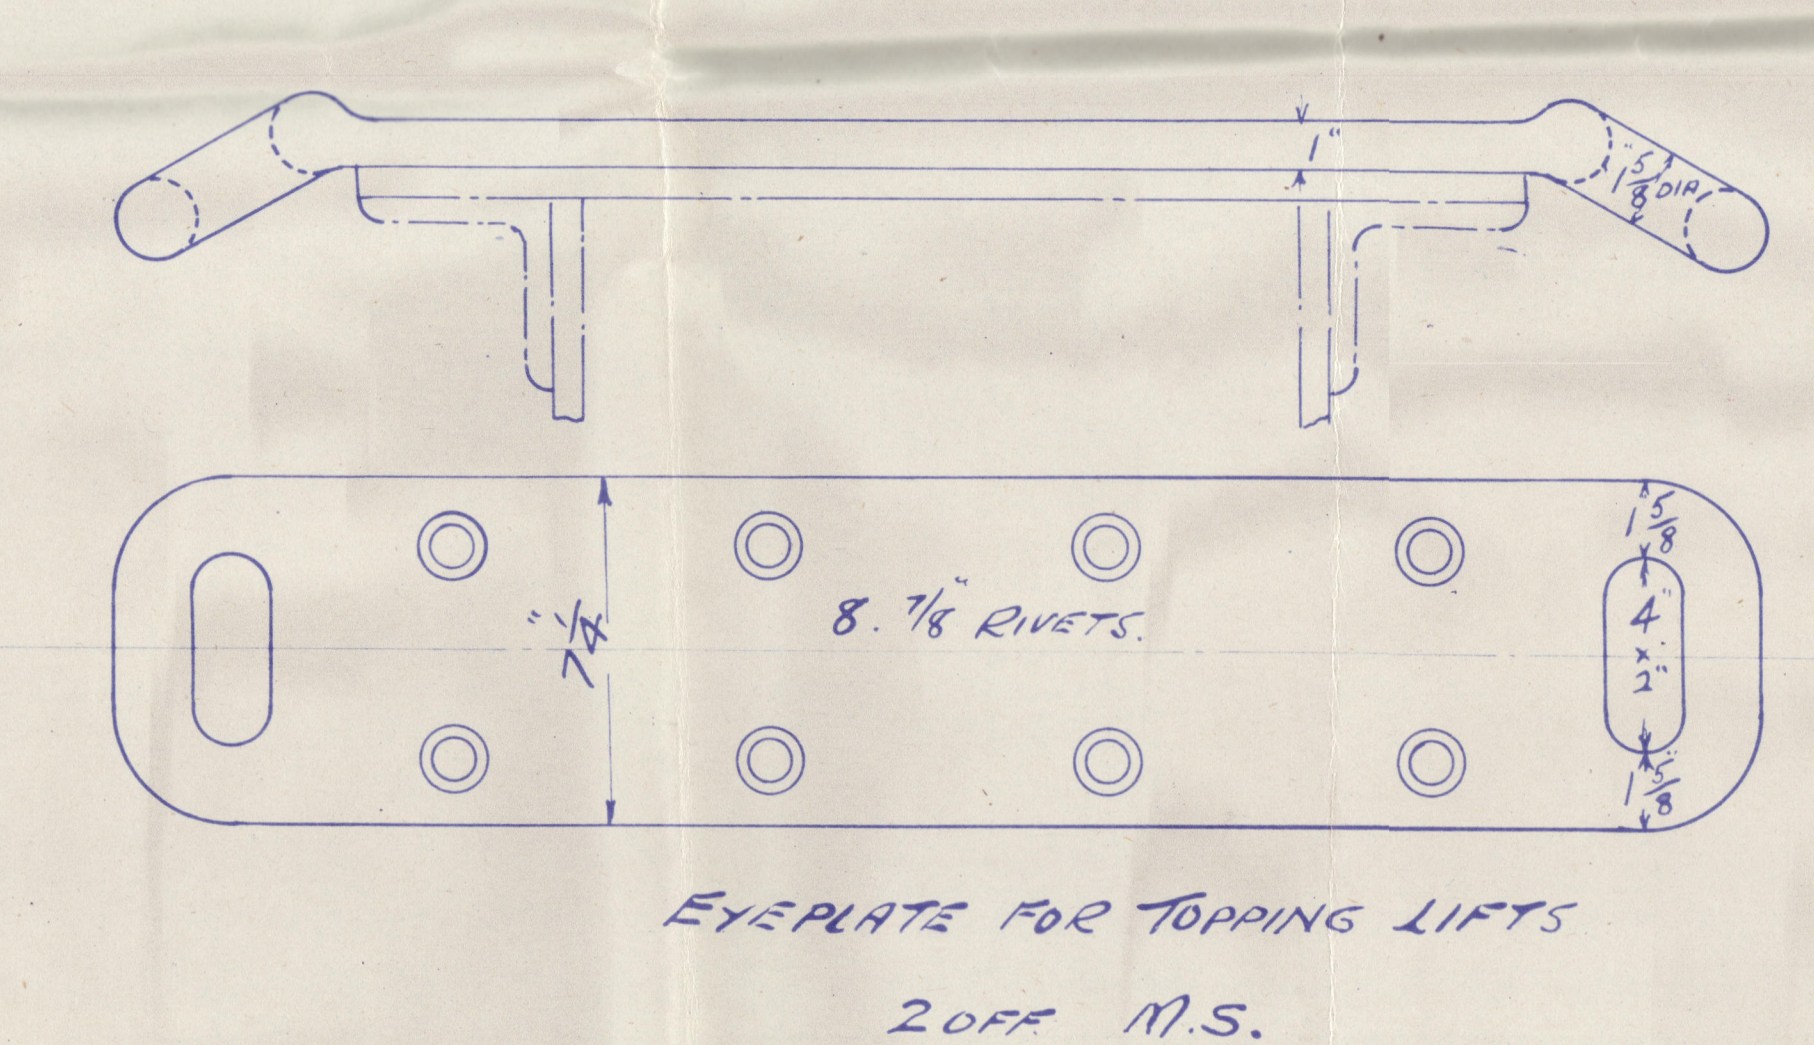
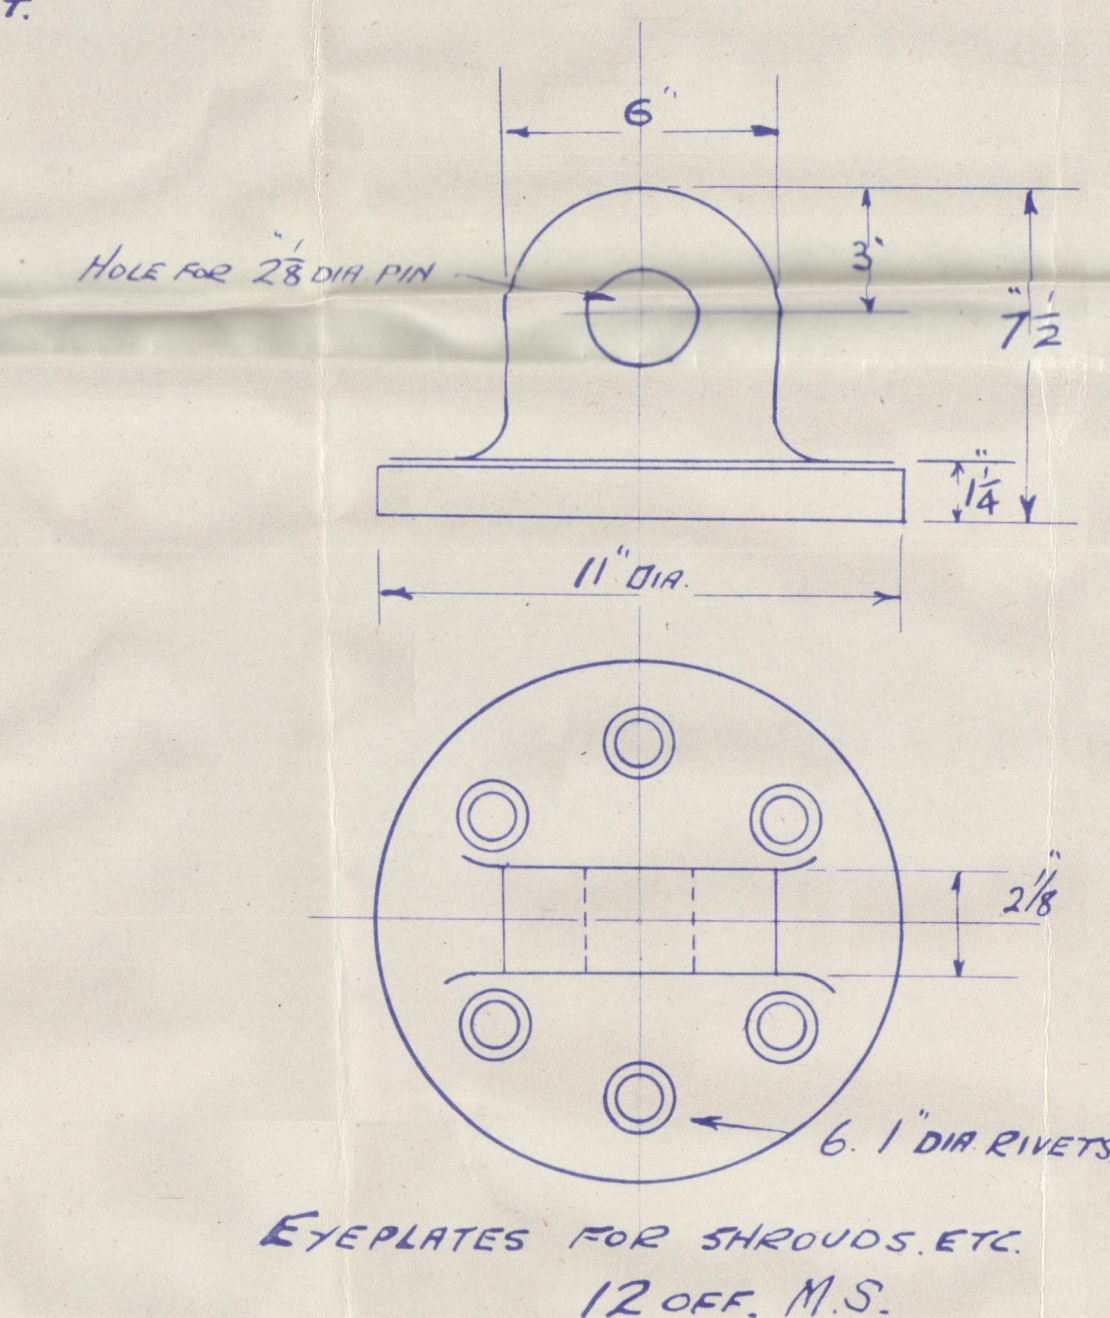
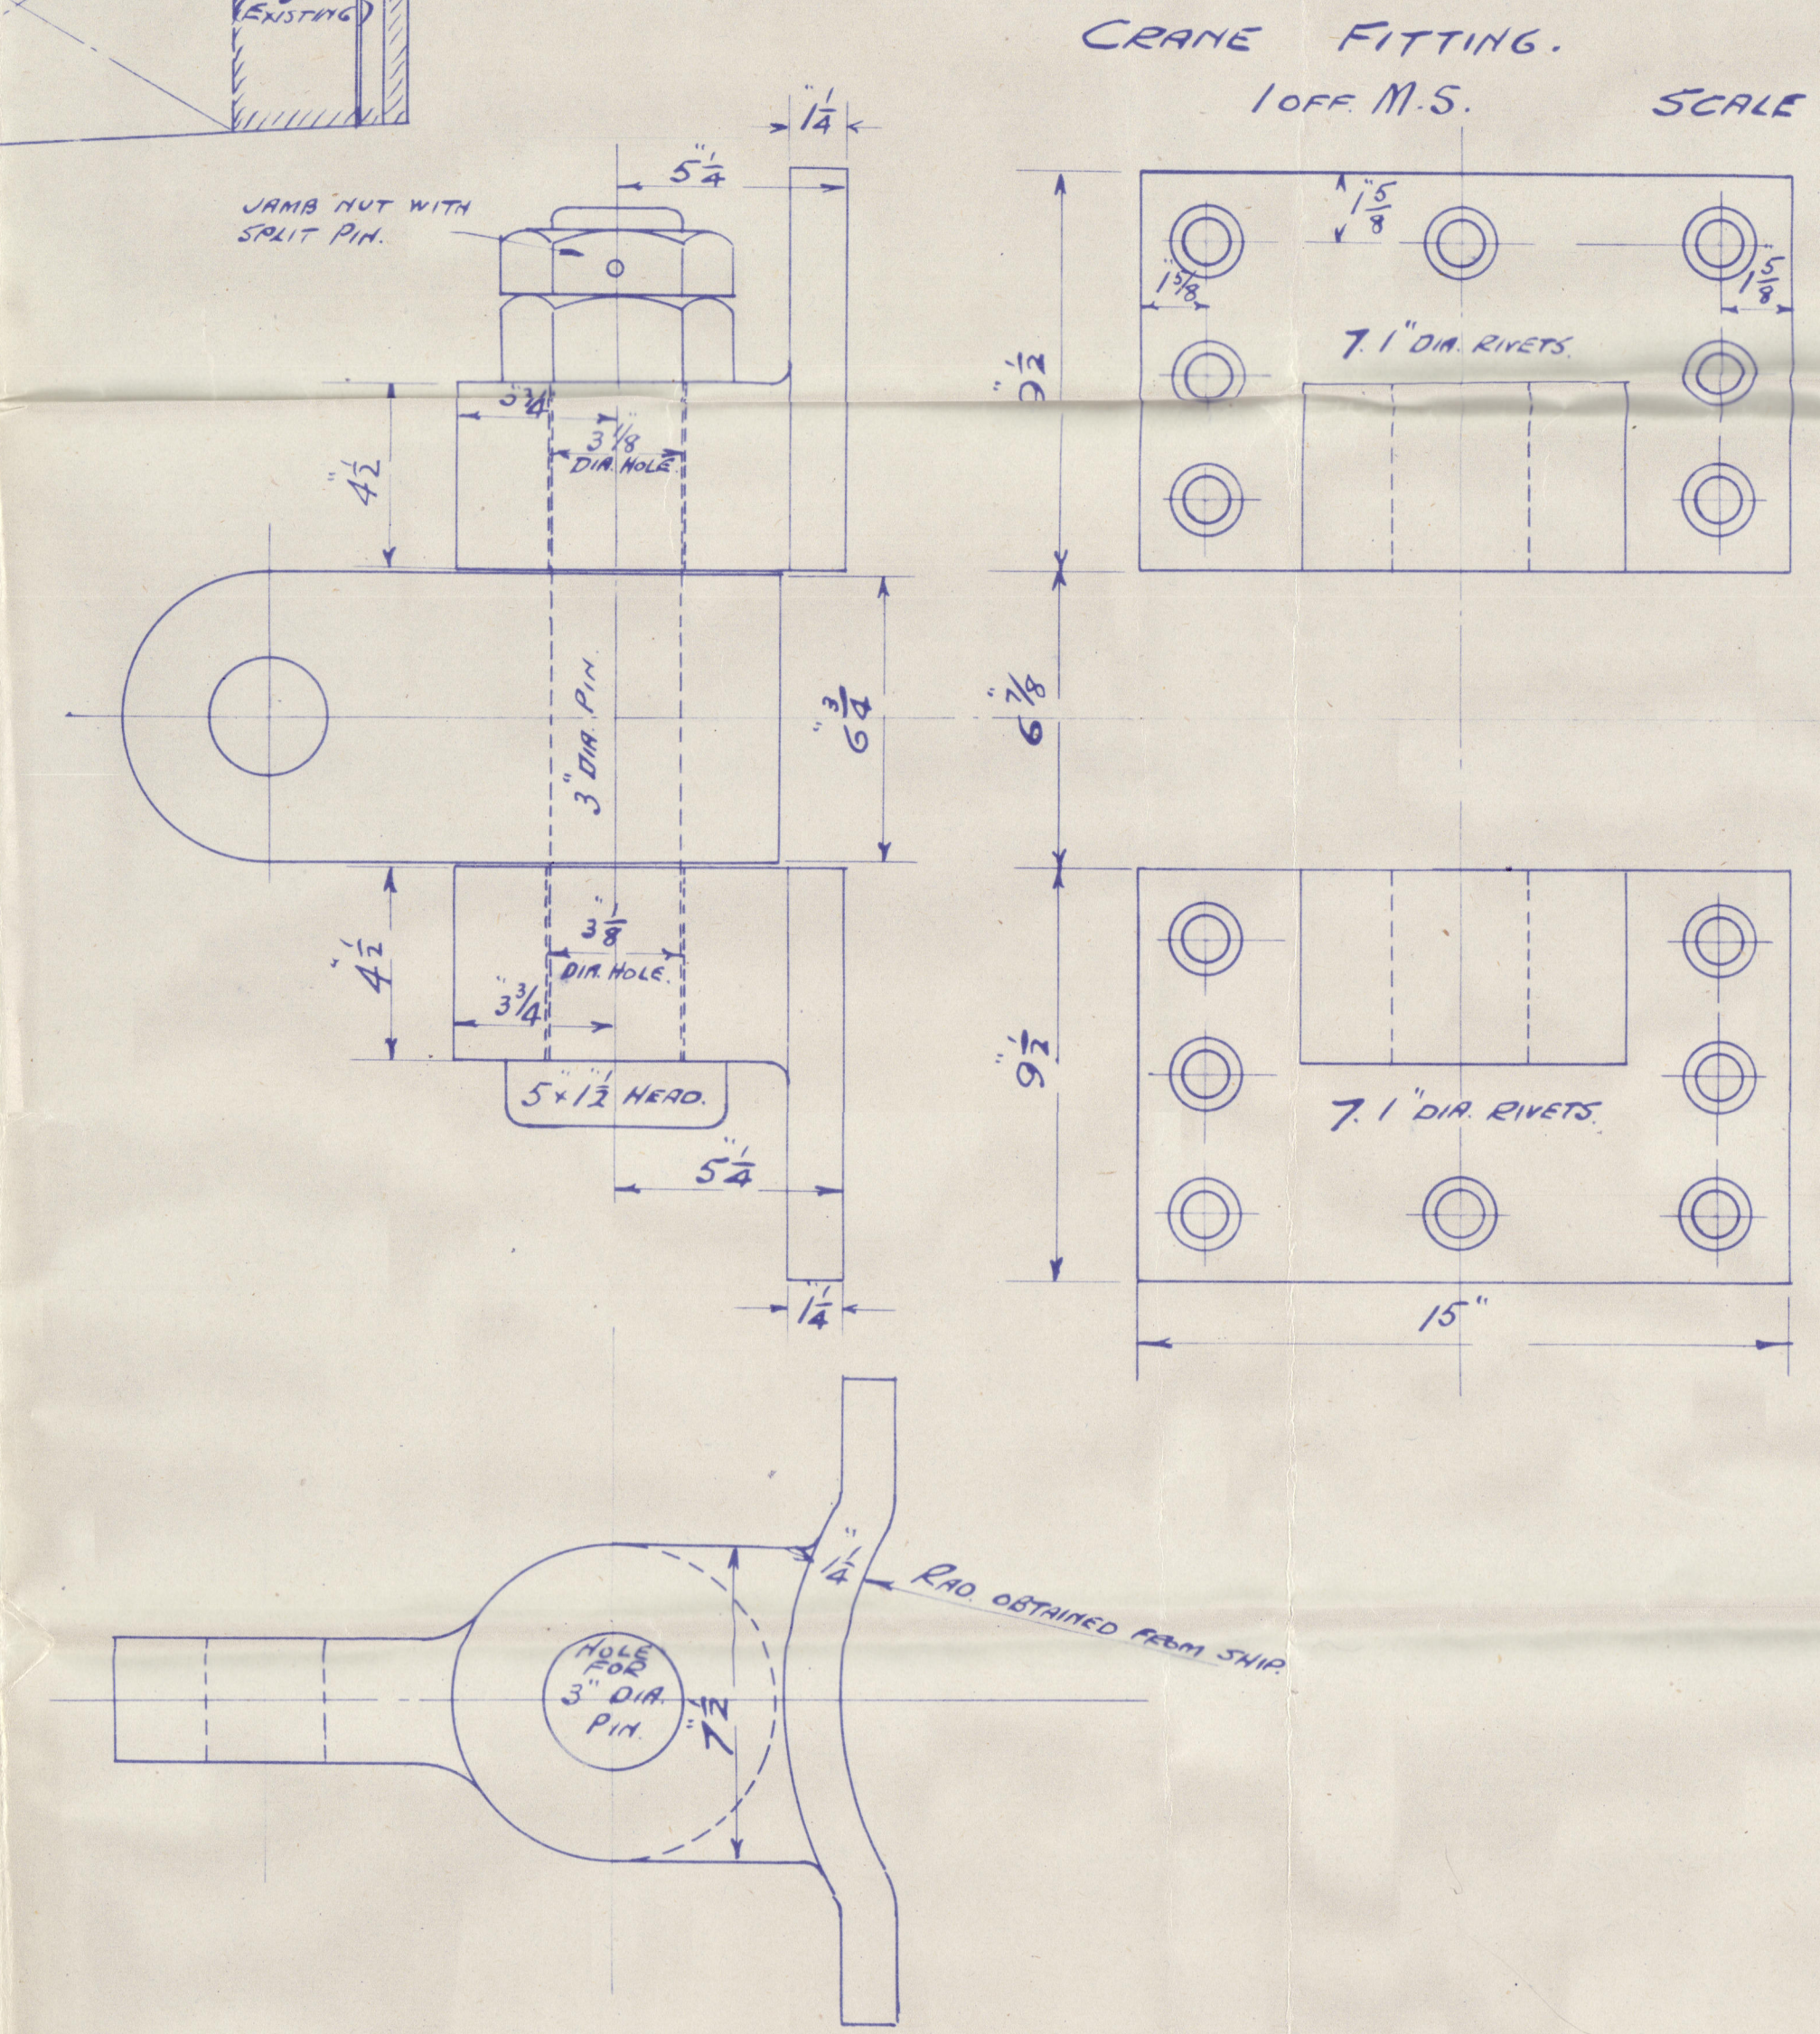


S.S. "LLANDILO."

[illegible]

PEDESTAL FOR HEEL FITTING
WITH STIFFENING UNDER.
SCALE $\frac{1}{2} = 1$ FOOT.

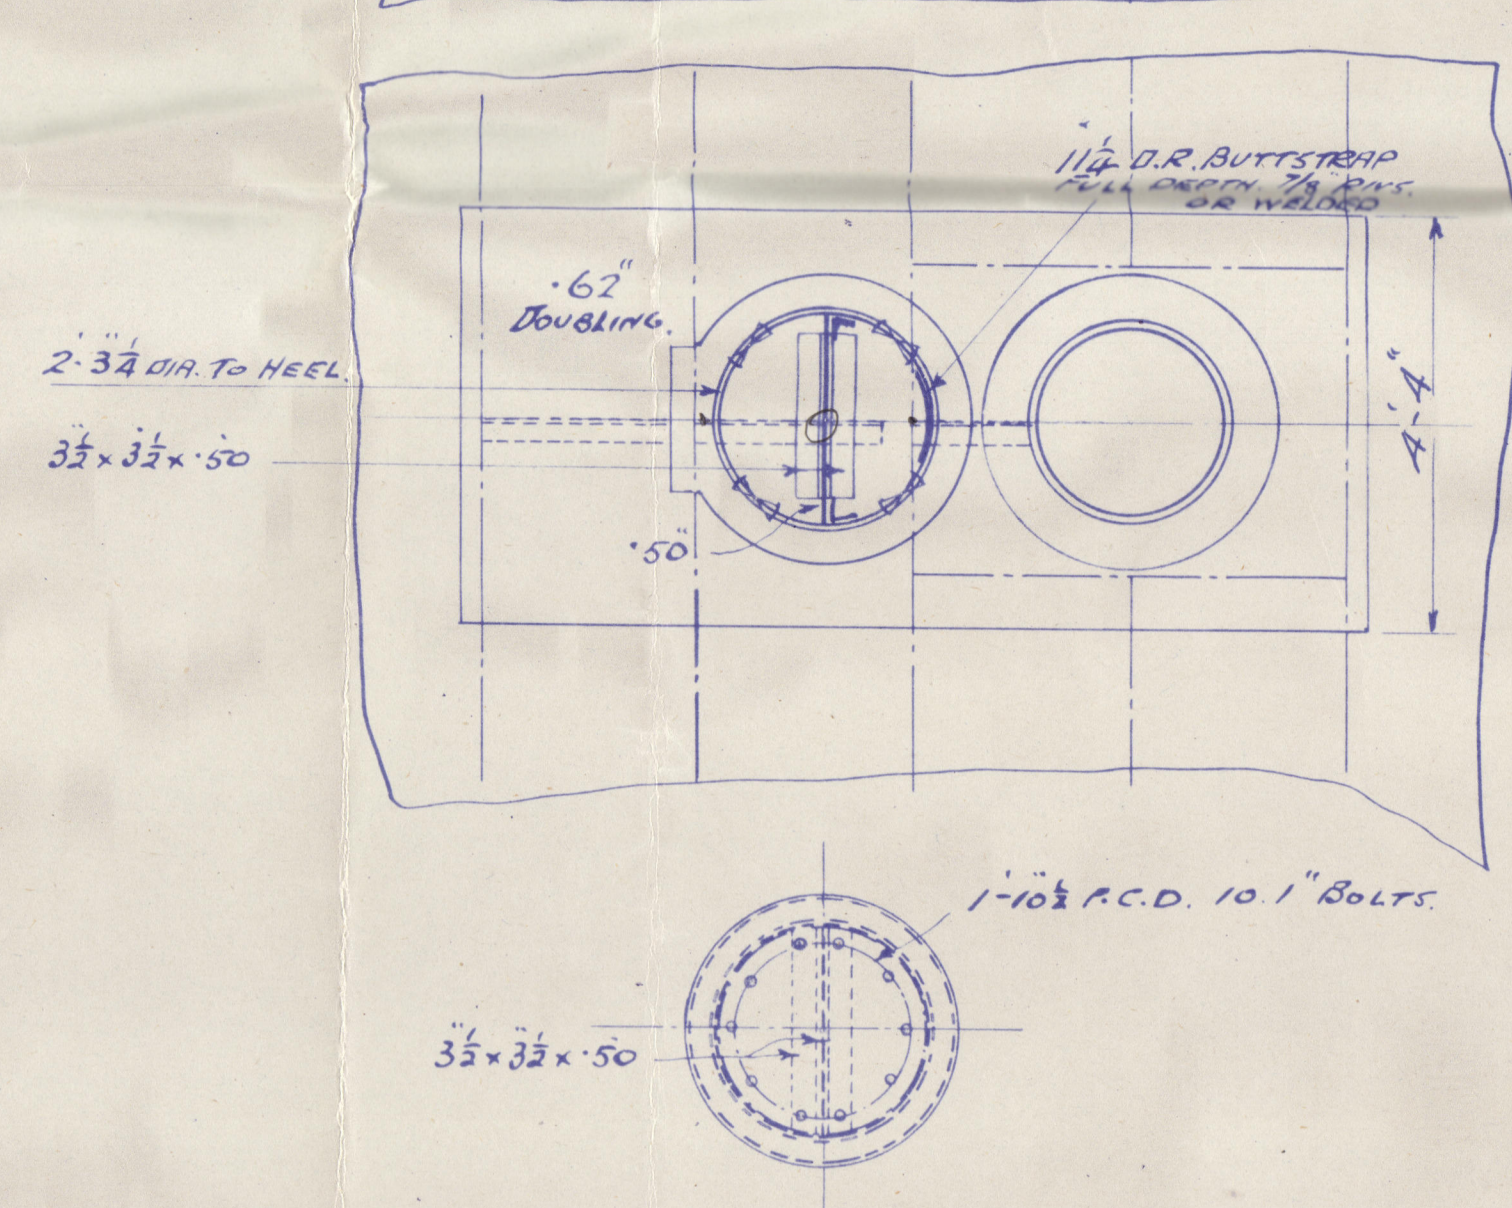

W.J.
21.5.42

9769.

W191-0026

"LLANDILO"

Fore mast plating
showing new doublings

Lon rept No. 110584.

25-ton derrick



© 2019

Lloyd's Register
Foundation