
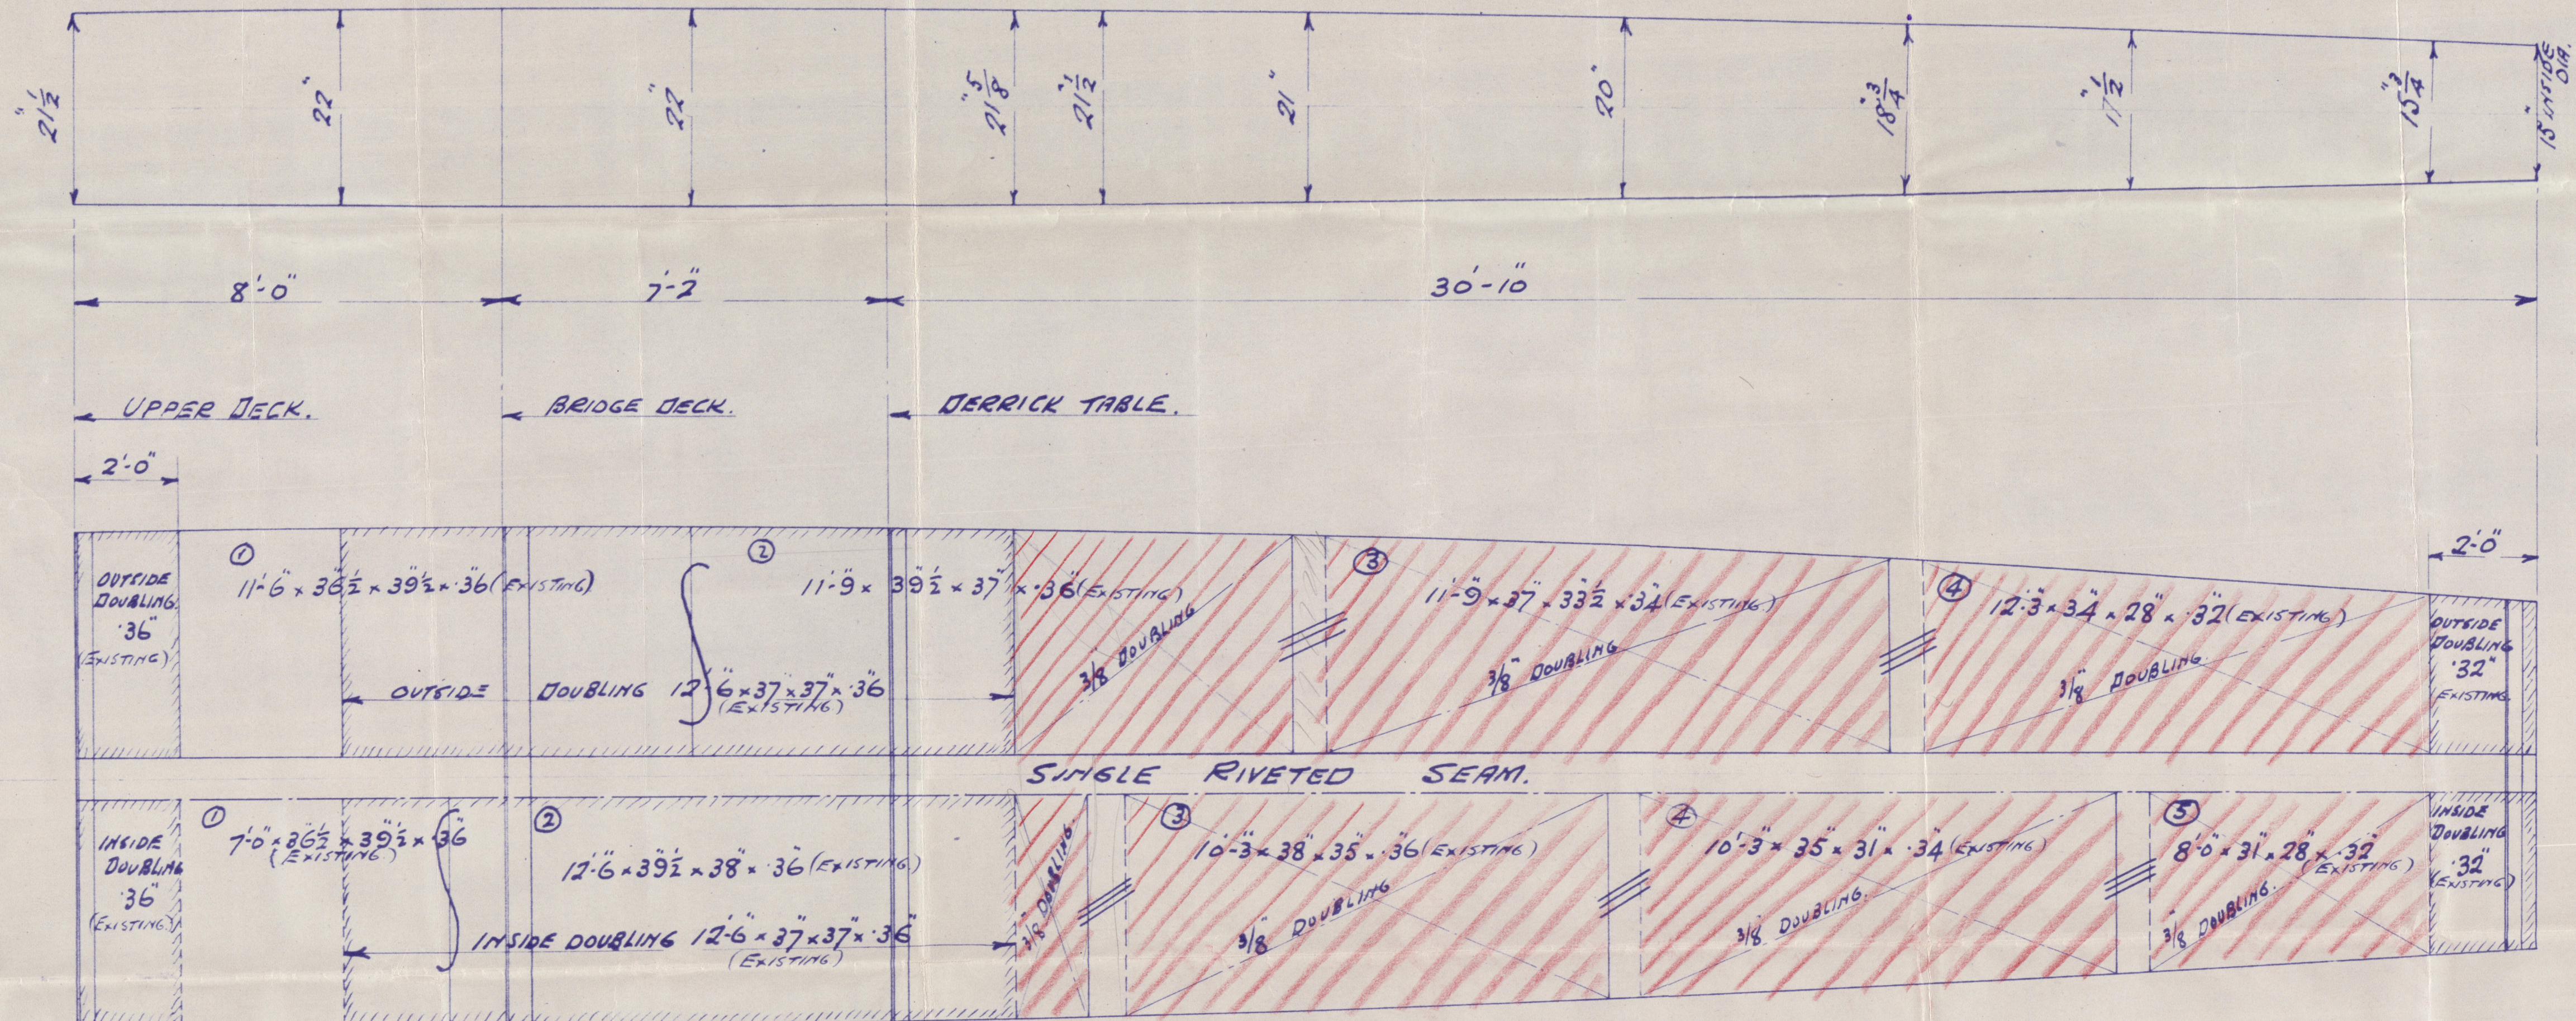


9757

## S.S. LLANDILO.

FORE MAST PLATING SHEWING NEW DOUBLINGS (AS PROPOSED.)

DOUBLINGS TO BE PLUG WELDED, WITH WELDED EDGES.

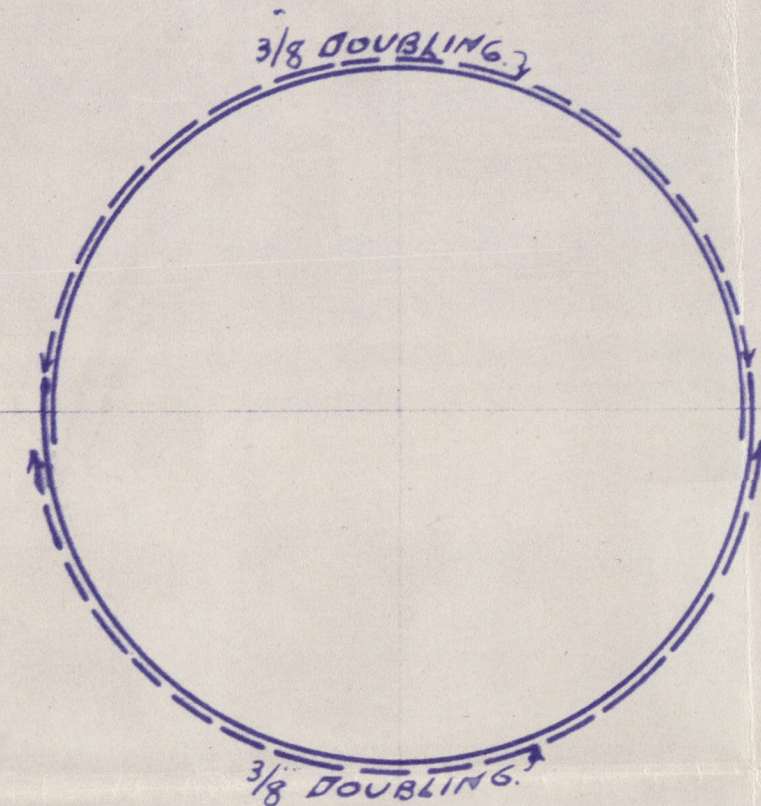

9757



14. S. 12


W191-0027



W191-0027

"LLANDILO

Lon rept No. 110584.

25 ton derrick on  
fore mast

proposed doubling



© 2019

Lloyd's Register  
Foundation