


SECTION, LOOKING AFT.  
STARBOARD SIDE SIMILAR

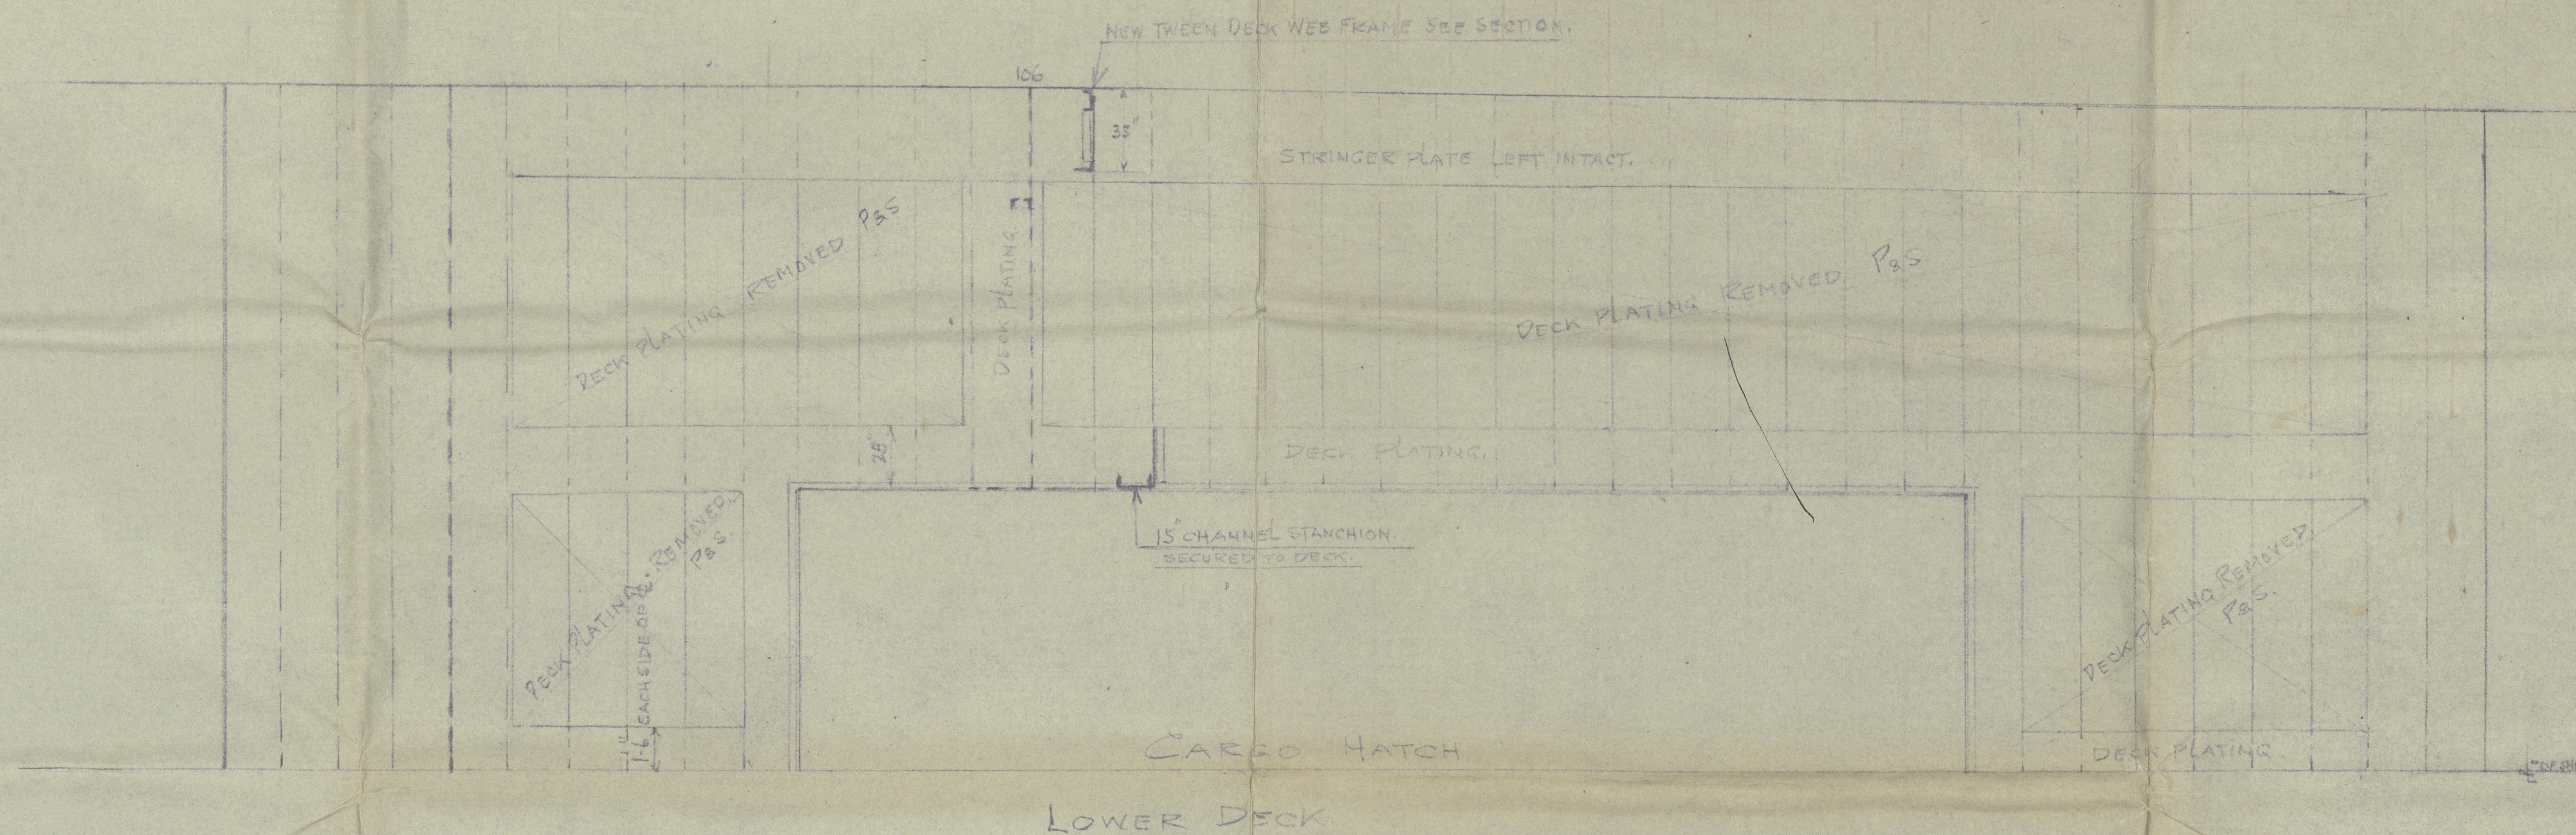

J.S.H.  
APPROVED  
APR-3 1933  
LLOYD'S REGISTER OF SHIPS  
NEW YORK CITY  
J. French  
\* GOMEY, BODIN & JOHANSEN \*  
Consulting Engineers  
and  
Ship Surveyors  
52 BRADWAY, NEW YORK CITY

CHARGE ALL LABOR AND MATERIAL TO W.O. 1259-1.

TODD DRYDOCK ENGINEERING & REPAIR CORP'N.  
BROOKLYN, N. Y.

ALTERATIONS TO "2"  
HOLD HATCHES & BHD 106.  
"AMERICAN EAGLE"  
© 2015

DRAWN APPROVED  
CHECKED DATE  
SCALE 1/4" = 1'-0" FOR 1259-1  
W197-0201

N.Y. Rpt.  
No 3430