

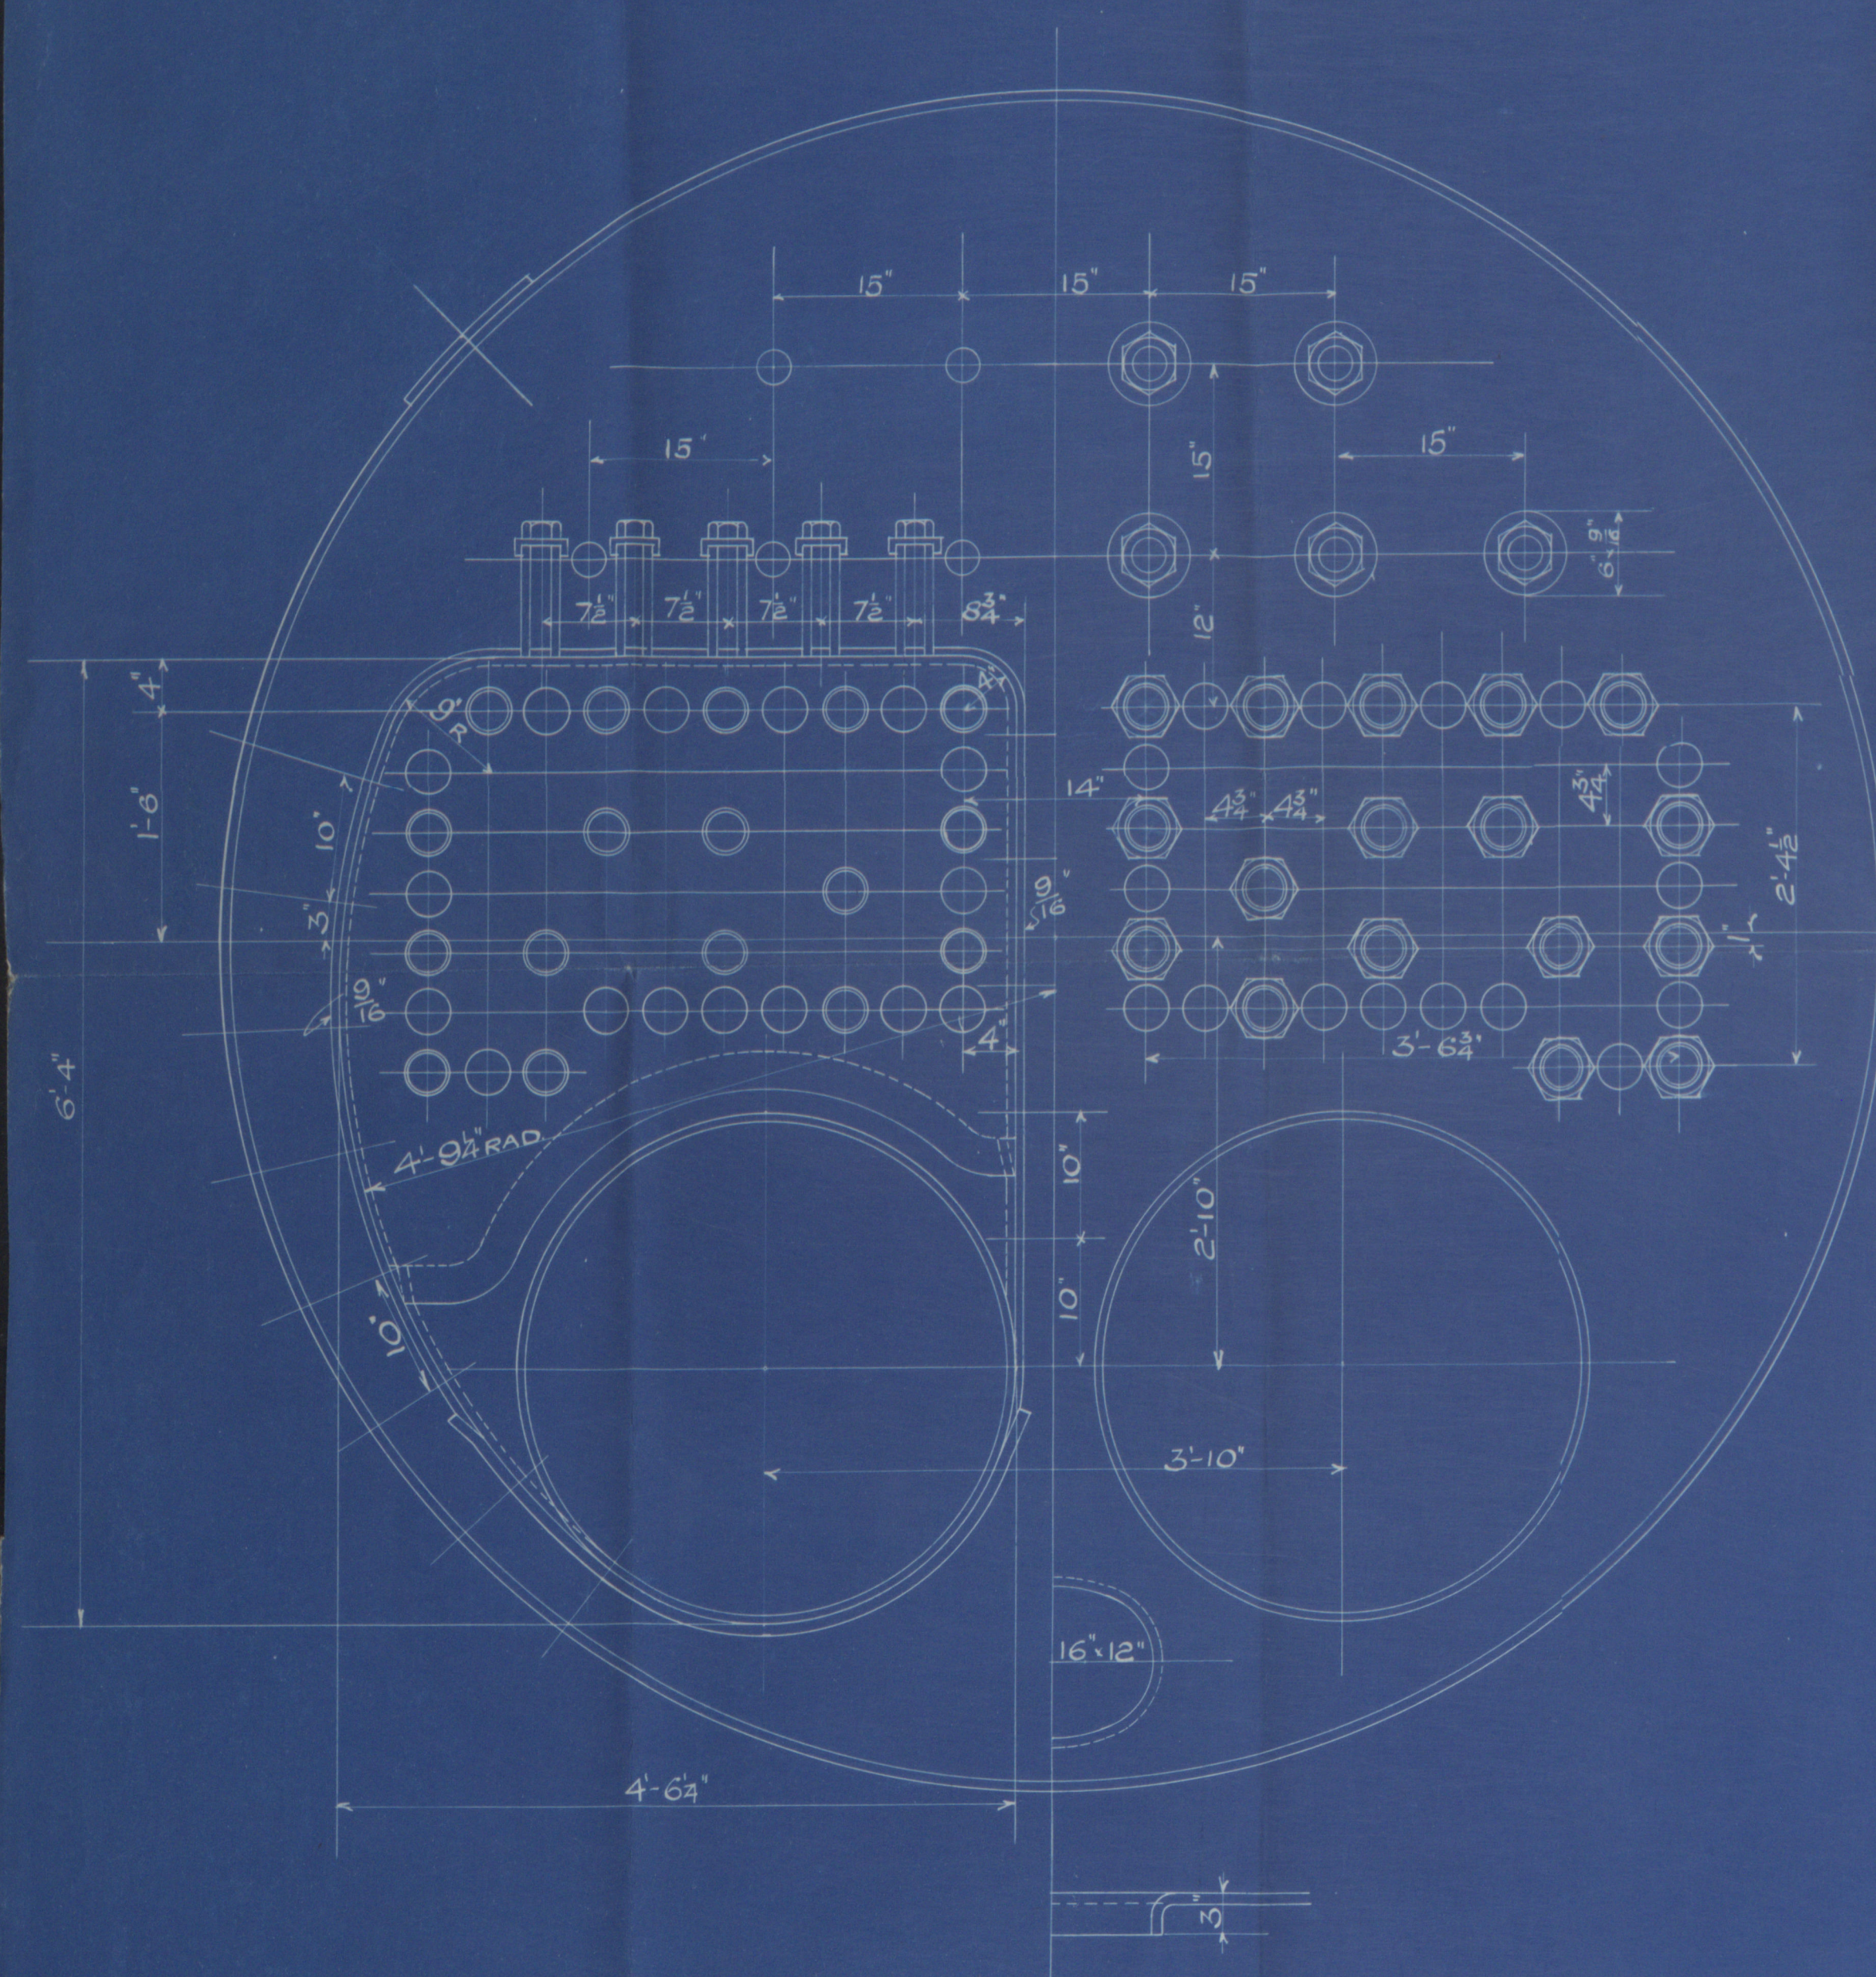
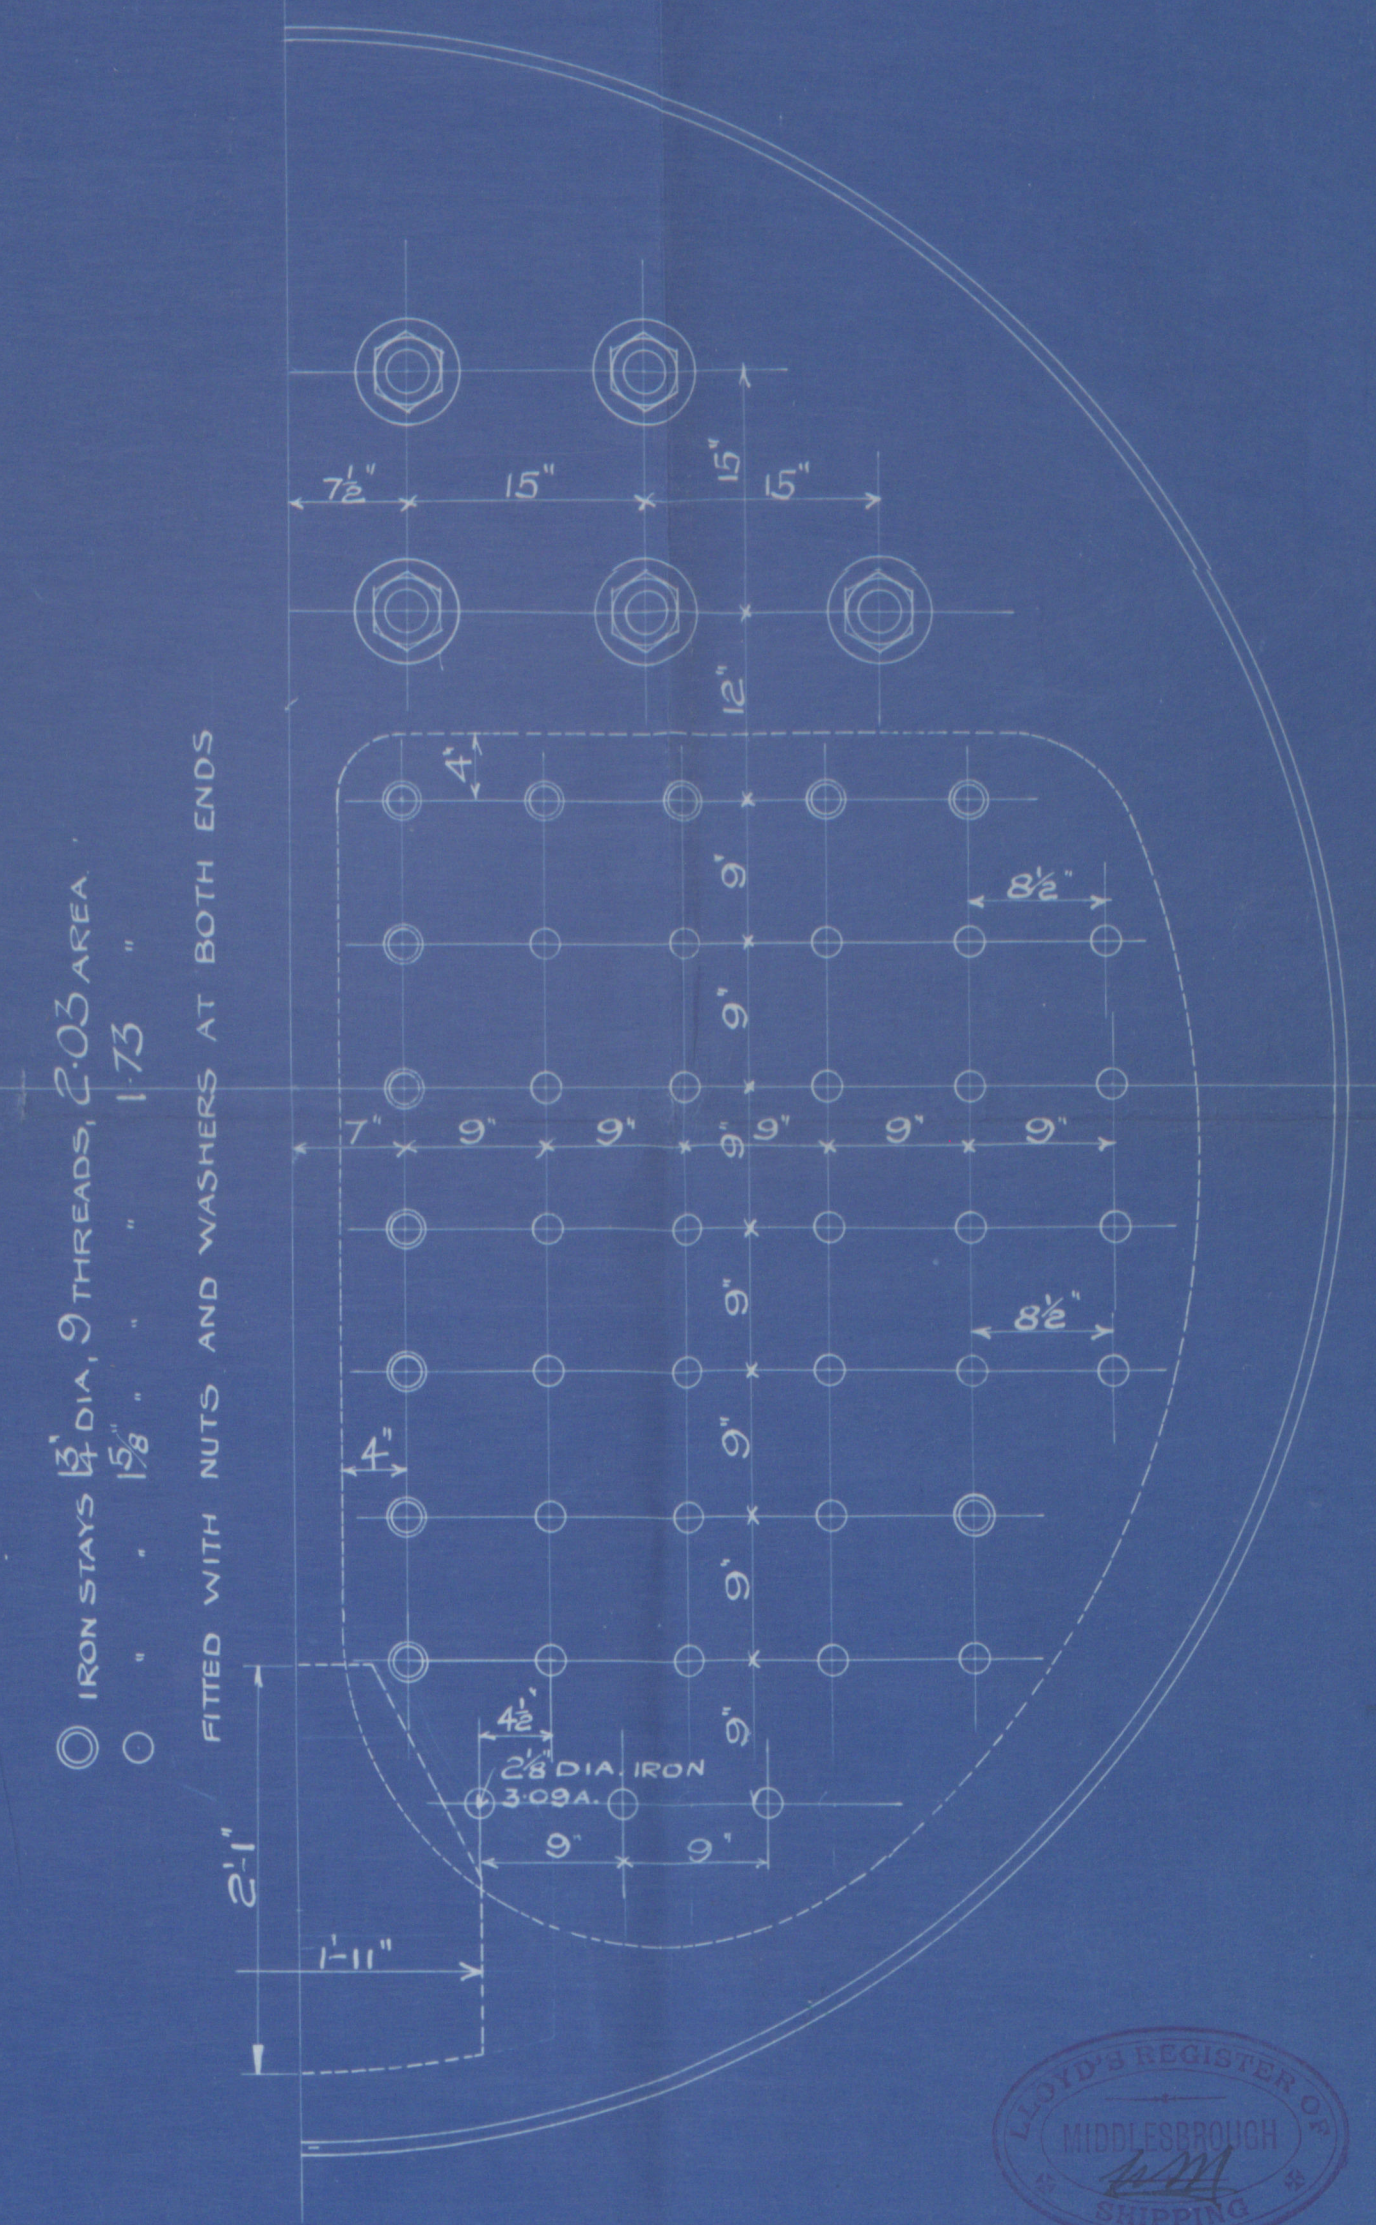


STEEL BOILER 11-0 DIA 10-0 LONG 120 LBS W.P. LLOYDS

4569

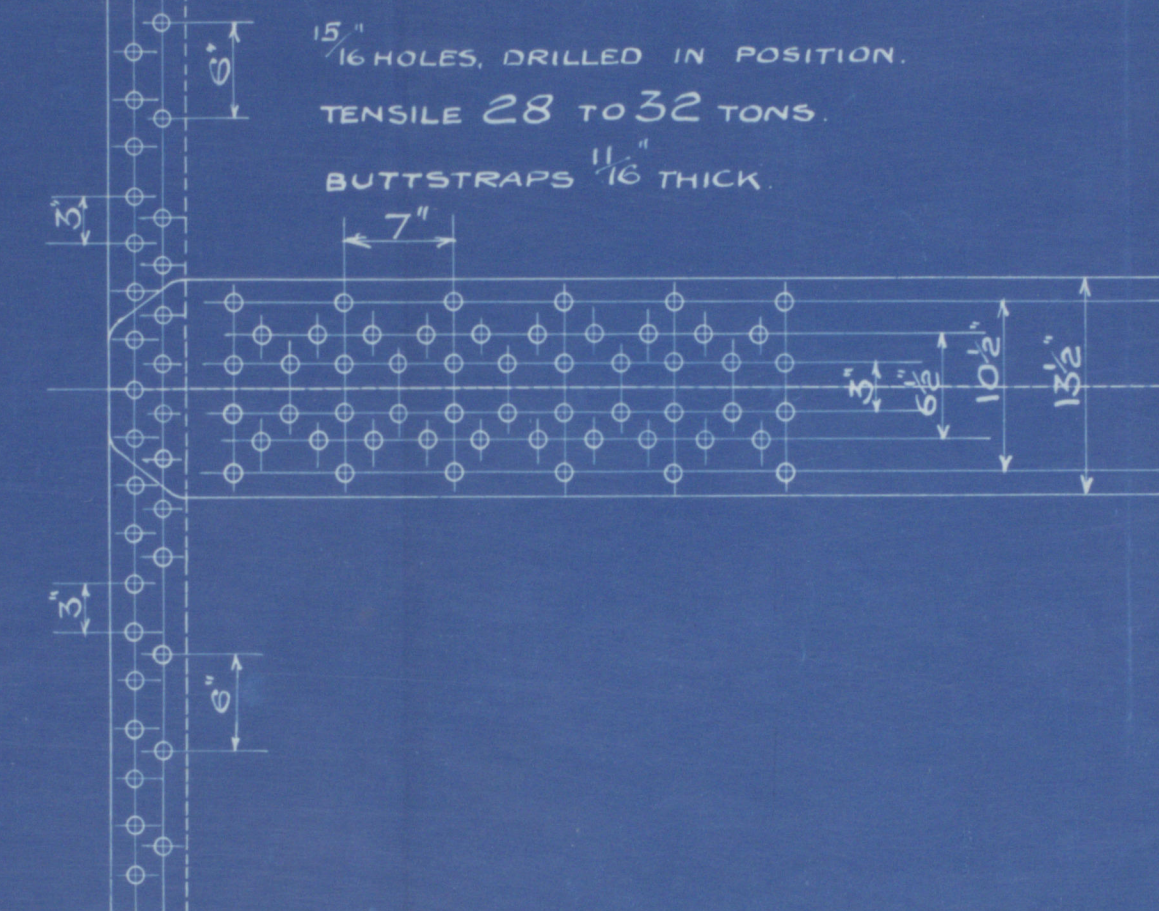

RILEY BROS. (BOILERMAKERS) LTD.
STOCKTON ON TEES.

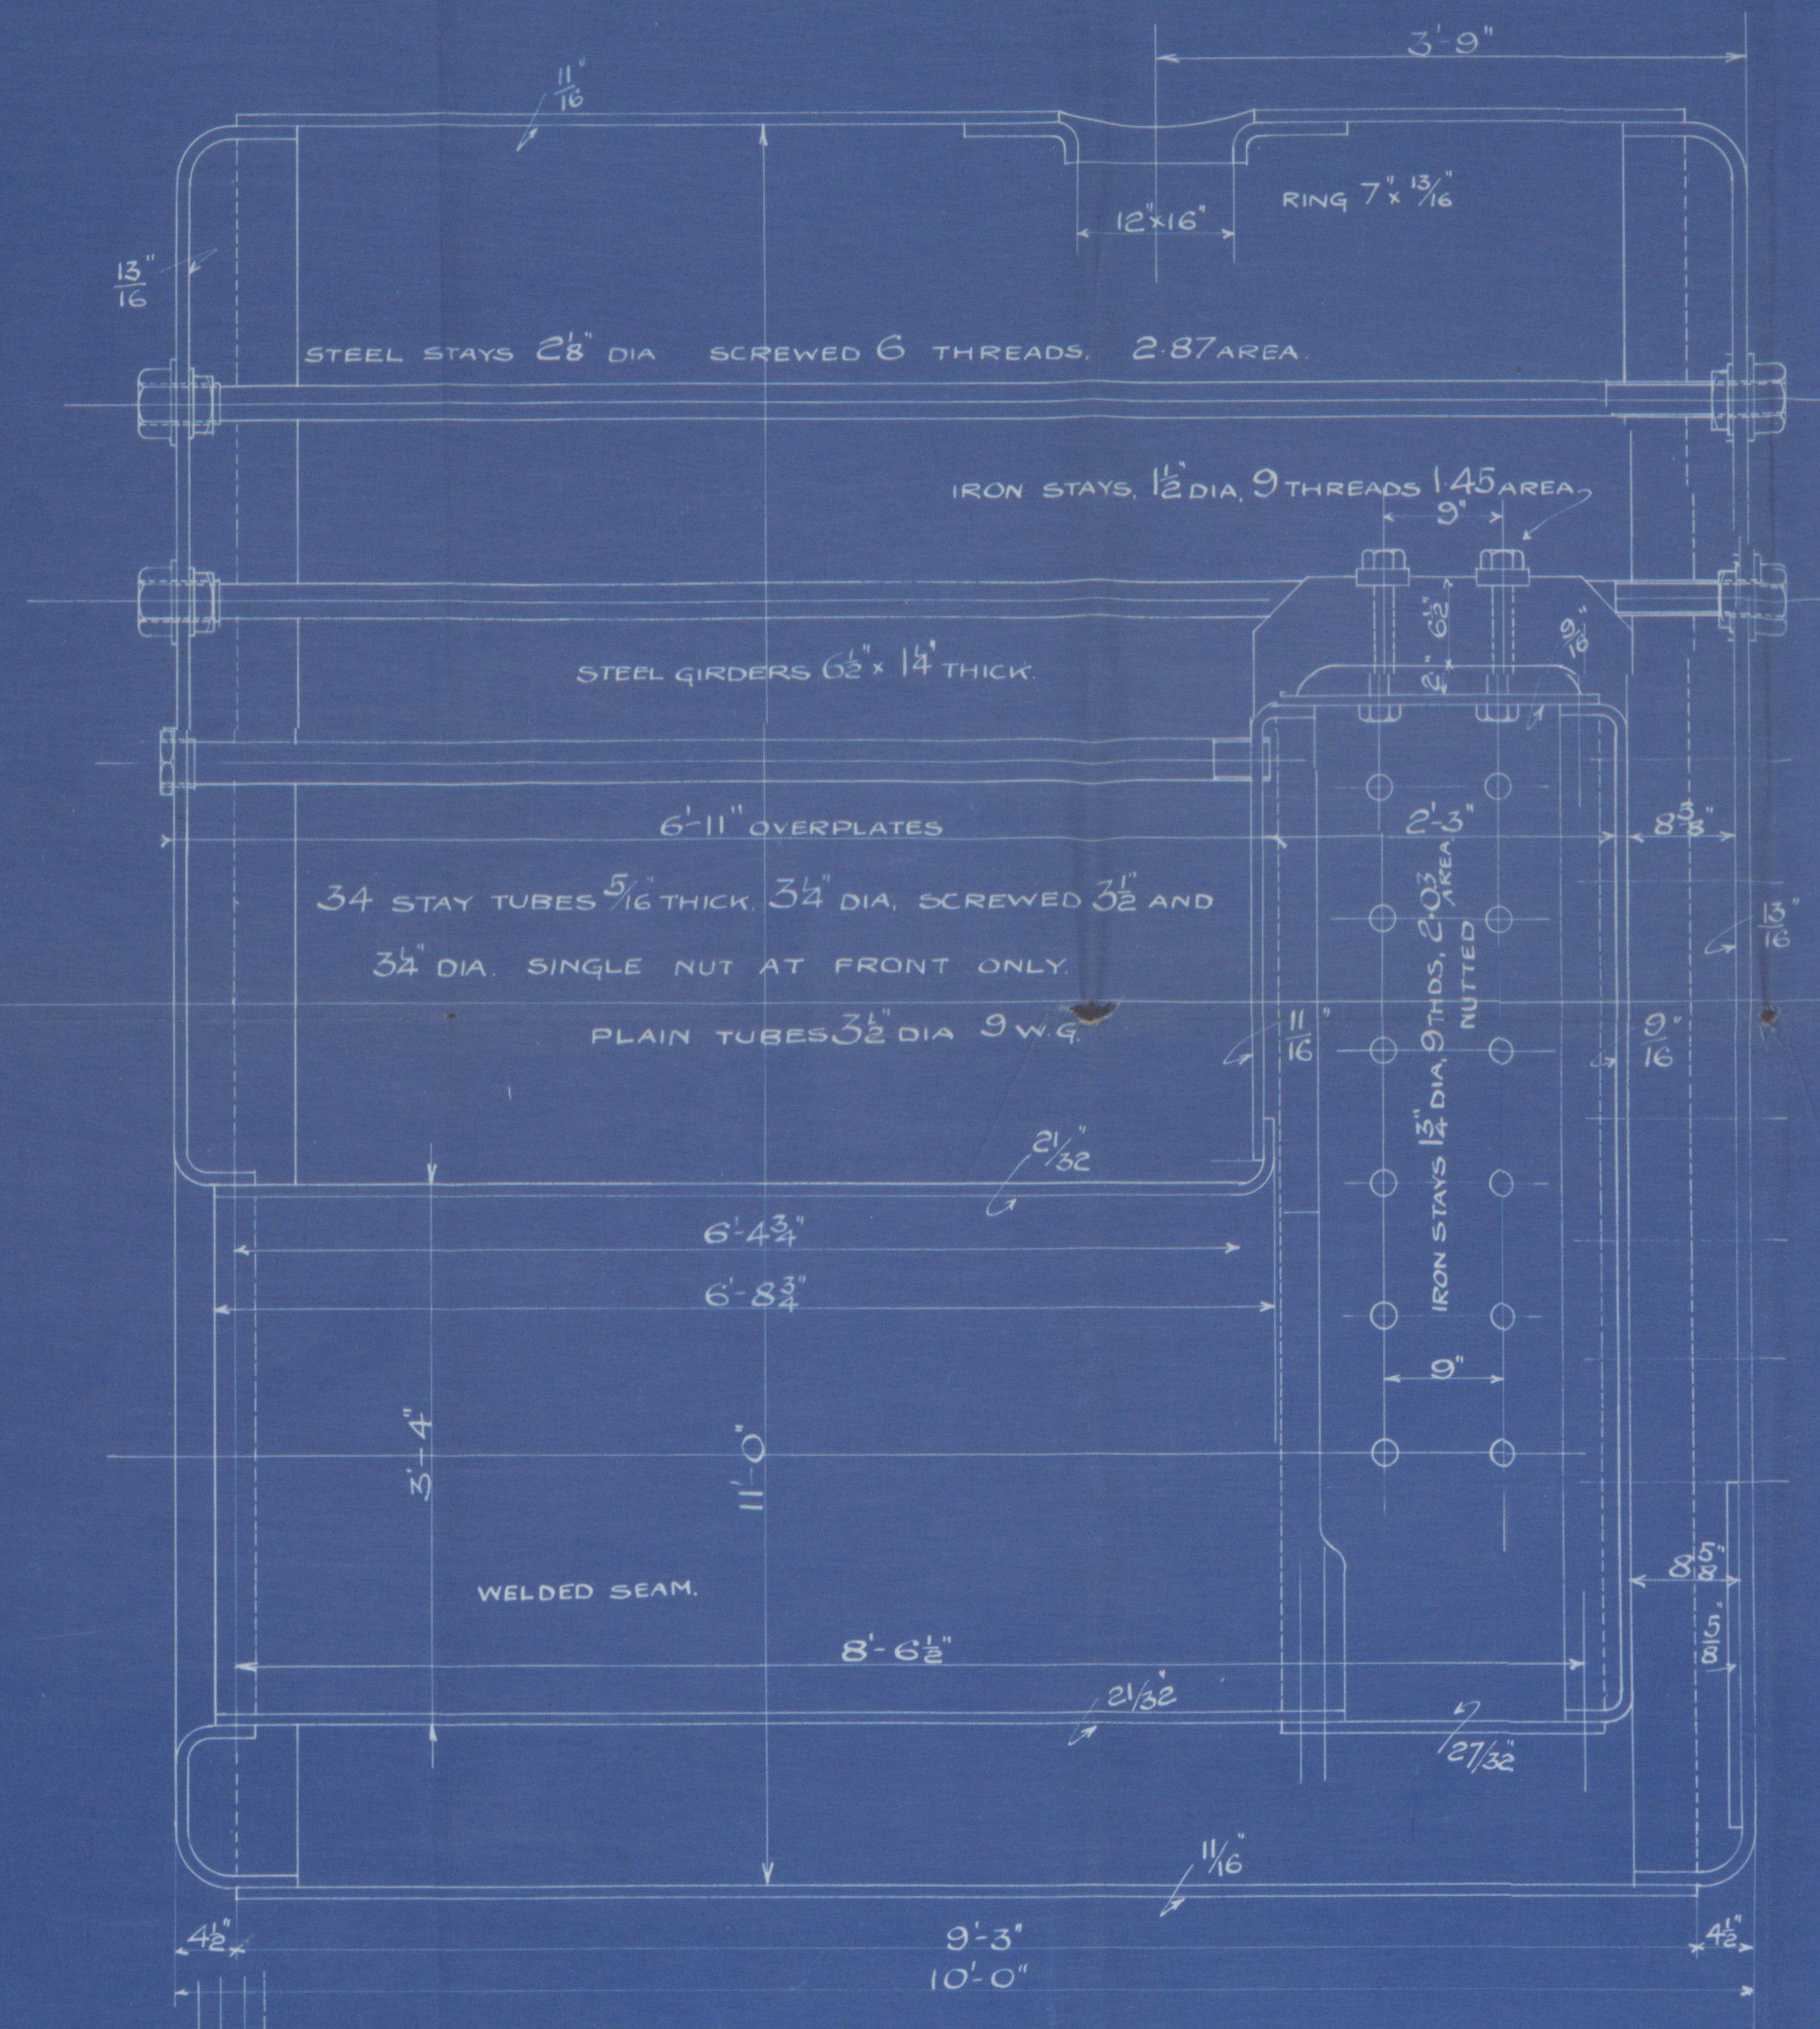

HEATING SURFACE 1050 $\frac{1}{2}$ $\frac{1}{2}$
GRATE AREA 5'-6" BAR 35.5 $\frac{1}{2}$ $\frac{1}{2}$

LLOYD'S REGISTER OF
SHIPPING
30.11.12
Duplicate of No 4524

Messrs Riley Bros Lim^d

Boiler No. 4569

for

Messrs J. L. Thompson & Sons Ltd

S.S. No. ~~500~~
503

Working Press 120 lb

No.	5220
LLOYD'S TEST	
240	lbs.
8-1-14-WM	

Ind. Rpt.
No.
8263

Batsford

Sld. Rpt. 26017

See

Nellie

Sld. 25955.

Nellie

Duplicate of No. 4524

W200-0144

Lloyd's Register
Foundation