


PRINCIPAL DIMENSIONS:-

LENGTH B.P.	388	5
BREADTH EXT.	54	2
" MLD.	53	10
DEPTH MLD.	28	6 1/2

DEPTHS TO LENGTH---10-62.

NUMERALS:-
BREADTH MLD----33.83
DEPTH MLD----28.54
82.37 = FRAME No
LENGTH = 388.41
31993 = LONGIT. No

$B \times D \times L = 31993.33$
SHELTER DK. } 388.41 { 2330.46
ERECTION } $\times 8 \times .75$ {
CASING $6883 \times 7.75 \times .5$ 266.74
SALOON $26 \times 7.75 \times .5$ 100.75
EQUIPMENT No = 34691.25

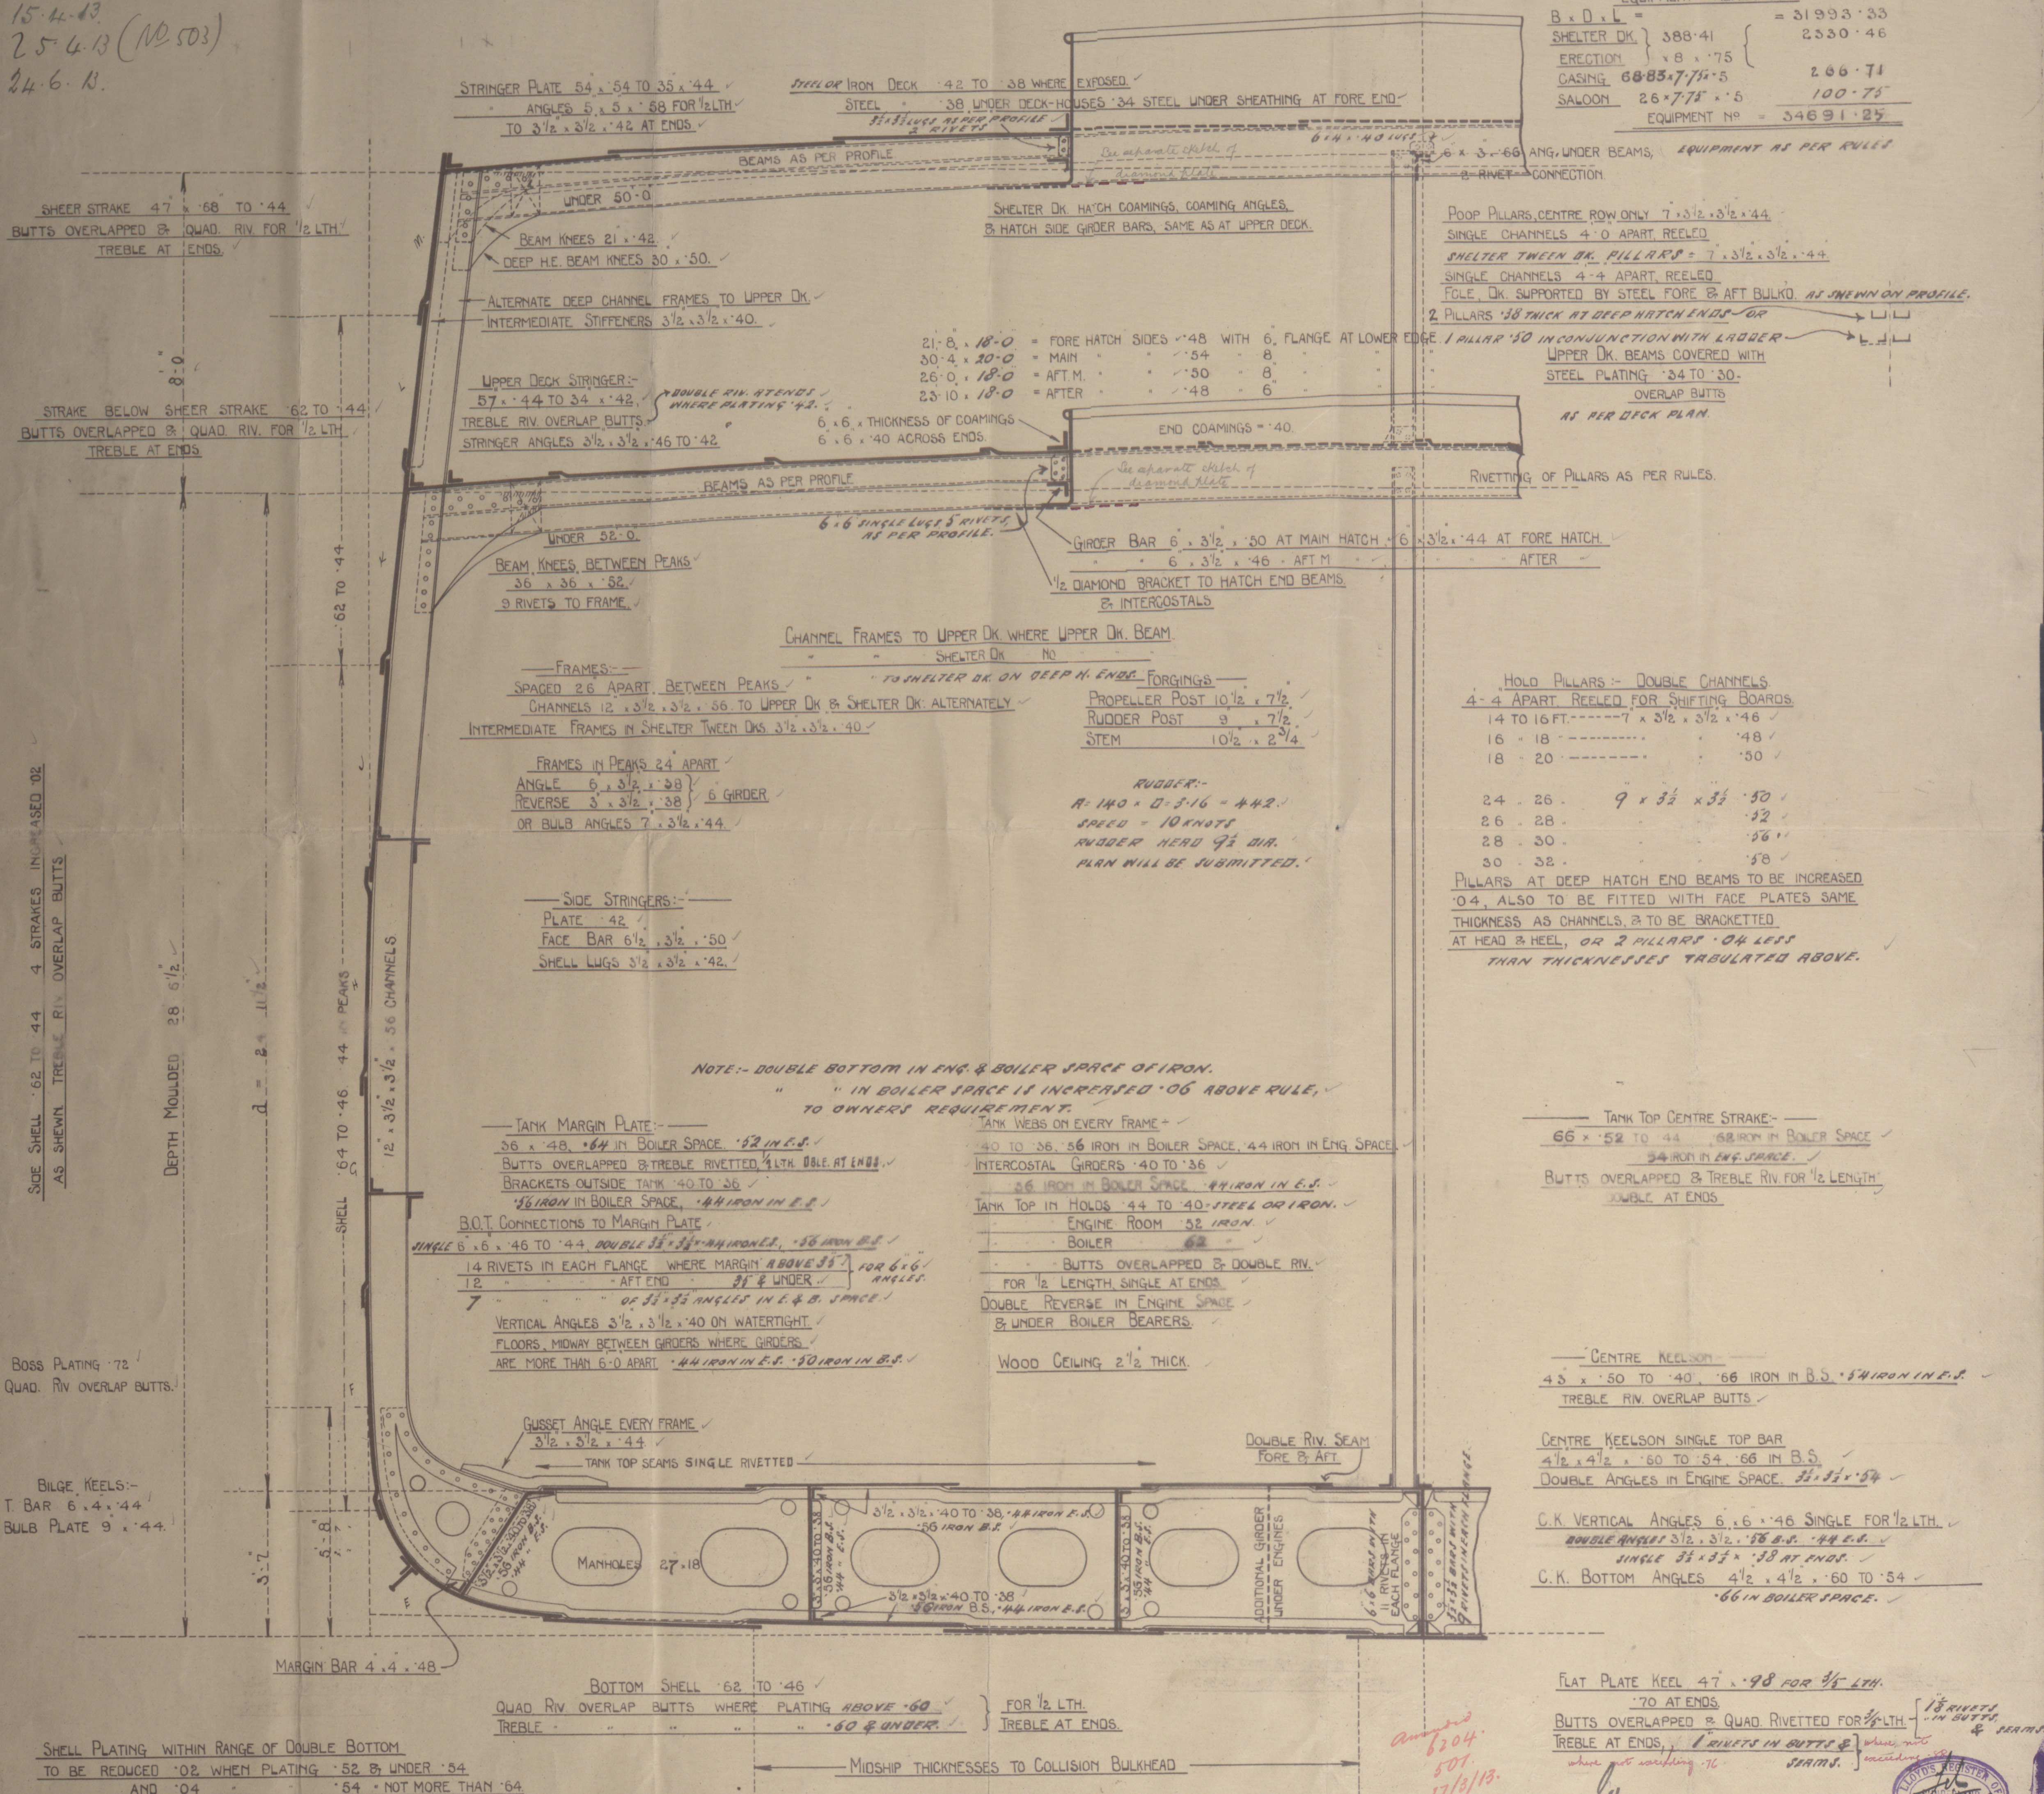

Amended
6204.
501.
27/3/13

14.13



SUNDERLAND

MESS^{RS} J. L. THOMPSON & SONS

AMENDED MIDSHIP SECTION

No. 50143

501 S.S. "MOTTISFONT"

SLO. REPORT No 25755

N.N. NELLIE


Nellie



503

S.S. "BATSFORD"

SLO. RPT No 26017

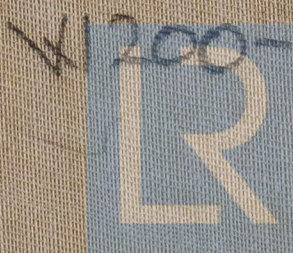

W1200-014619

Lloyd's Register
Foundation