

S. S. N^{os} 501. & 3


- SHELTER OR WHERE EXPOSED IRON, OR STEEL OF IRON THICKNESS

" " UNDER DARKHOUSES & SHEATHING STEEL OF RULE

POSITION OF BUTTS ARE APPROXIMATE

APPROXIMATE.

See amended
plan of deck
in way of opening

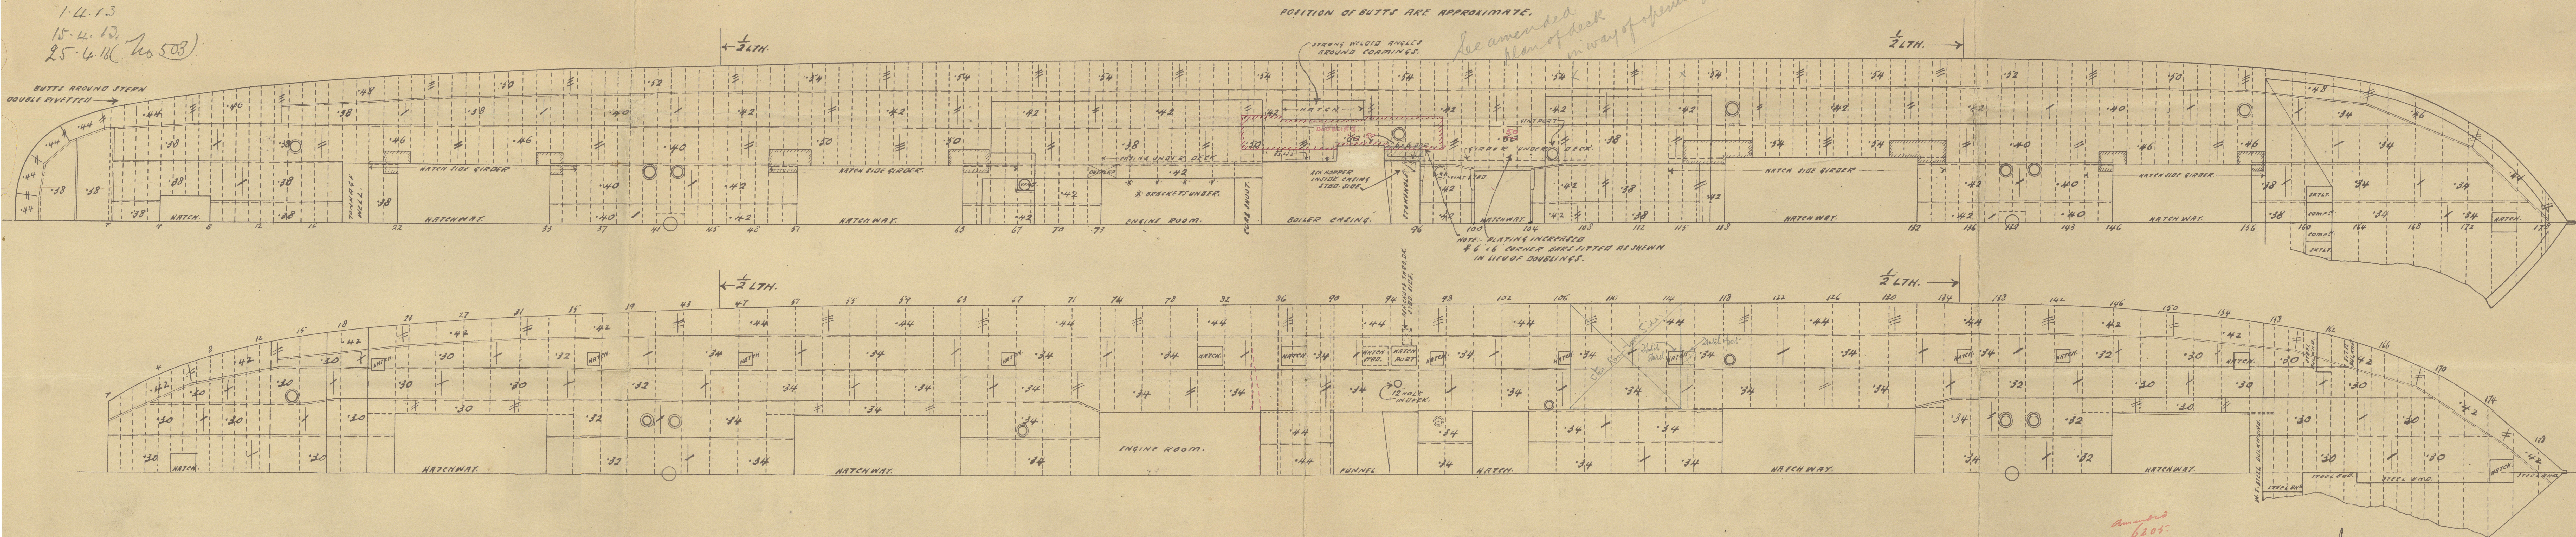

Amended
6205.
507.
27/3/13

fu
1.4.13



© 2019
Lloyd's Register
Foundation
x200-0147

SUNDERLAND

MESS^{rs} J L THOMPSON & SONS

AMENDED DECK PLAN


No. 501 + 3

501

SS MOTTISFONT

Lo. Report No 25955

N N ^{NE} NELLIE

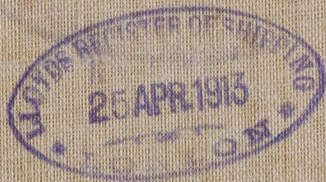

503

SS BATSFORD

SLD RPT No 26017

W200-0147



© 2019

Lloyd's Register
Foundation