


201549

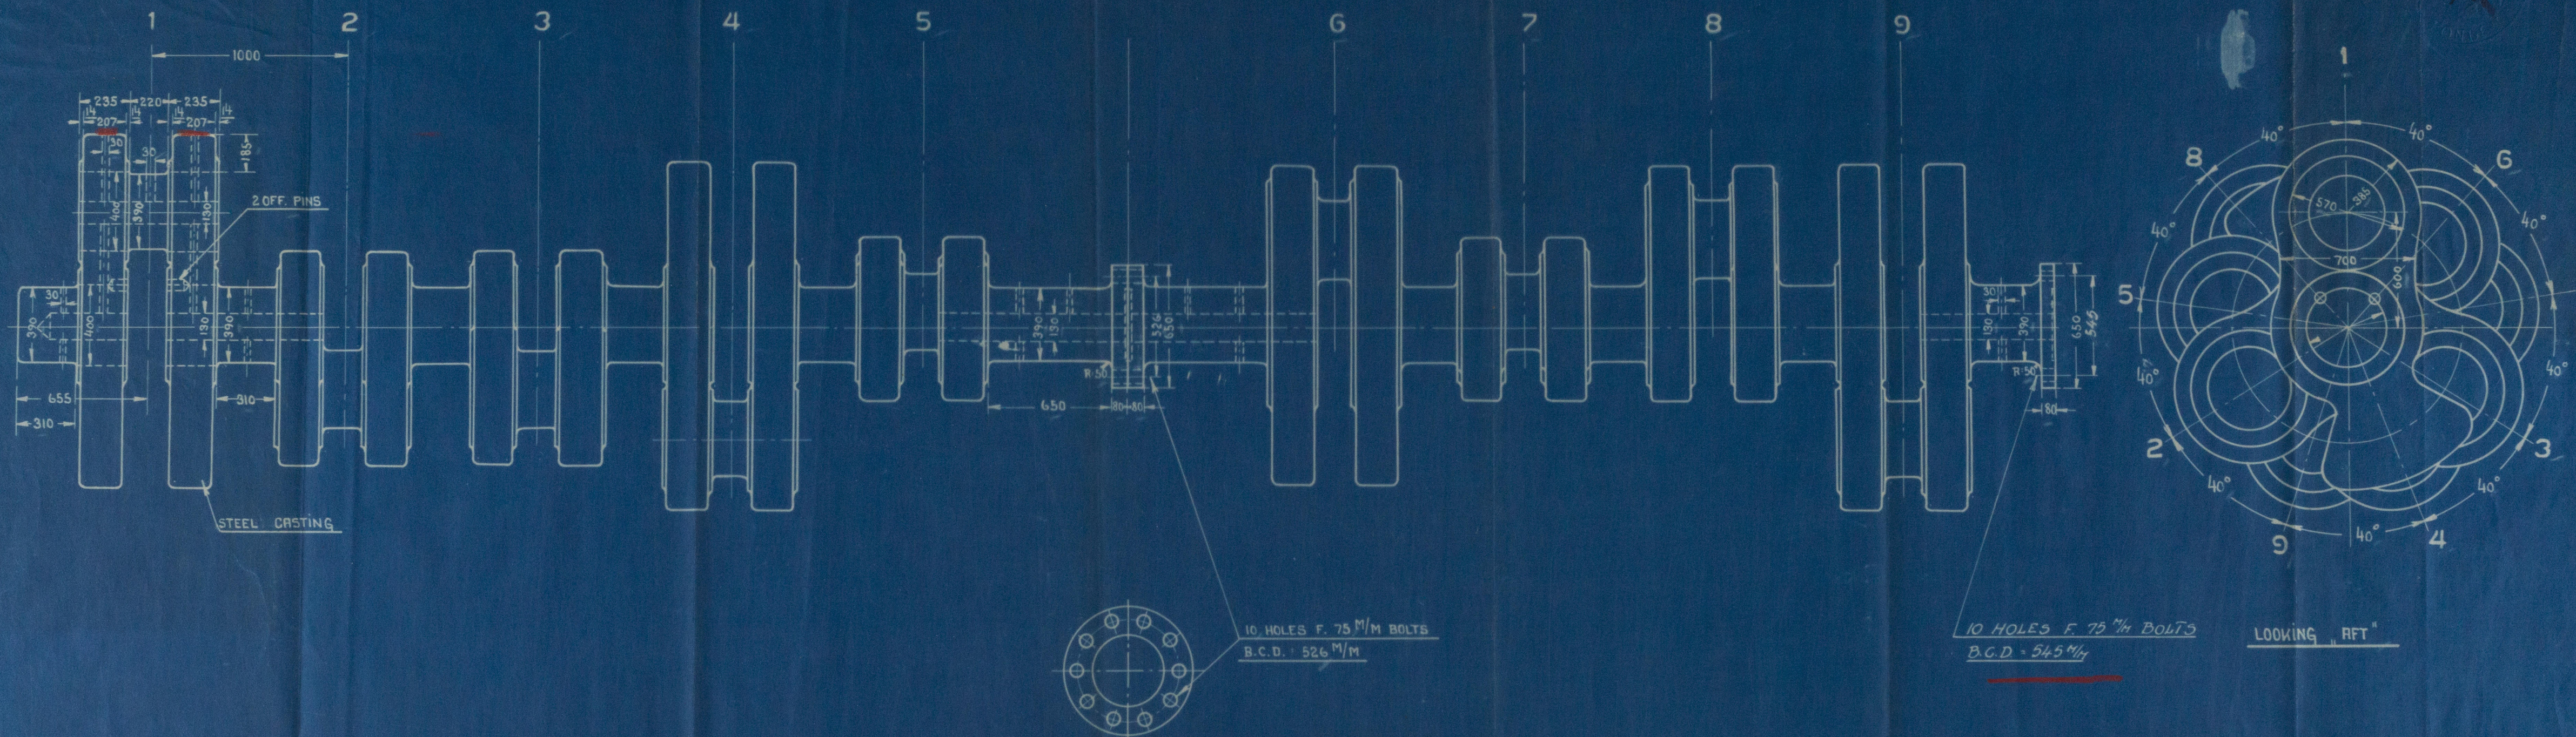

CRANK SHAFT FOR YARD NO

Odense 45-46

MAIN ENGINE

9 CYLINDER 2 S.C.D.A. DIESEL ENGINE WITH SOLID INJECTION

CYL. DIAM. 450 M/M STROKE 1200 M/M

THIS DRAWING AND THE DESIGN SHOWN
THEREIN, IS THE PROPERTY
OF BURMEISTER & WAIN LIMITED, AND
IS ONLY ALLOWED TO BE USED BY
EXPRESS PERMISSION AND LICENSE FROM
BURMEISTER & WAIN LIMITED
COPENHAGEN

AKTIESELSKABET
BURMEISTER & WAIN MASKIN- OG SKIBSBYGGERI

18/4/51





Amended plan of
CRANK SHAFT for 9 Cyl.
2 S.C.D.A. Main Diesel oil engine
to be constructed by

AKTIESELSKABET
BURMEISTER & WAIN'S MASKIN- OG SKIBSBYGGERI

Copenhagen
for the Screw Motor Vessel's

Yard No 45 & 46
being built by

Odense Skalskibsvarft
ved A. P. Møller,
Odense.

"Peter Mærsk" of Copenhagen.
Cpr. Rpt. No 8743.

"Anna Mærsk" of Copenhagen.
Cpr. Rpt. No 8779.

Lloyd's Register
Foundation

W208-0137