


# PROFILE & DECK PLAN.

S.S. No. 360.

SCALE 1/8"=1 FOOT.

TO CLASS 100 A1 AT LLOYD'S.

RULE DIM. 401' 54" SUMMER L.W.L. x 32' 73" MLD. x 30'-0" MLD TO UPPER DECK.

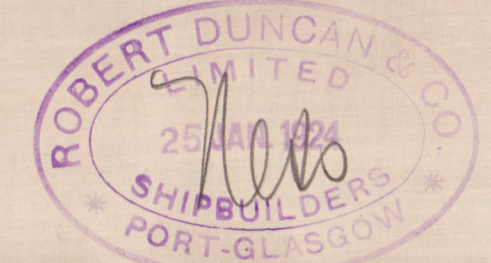


Freeboard Particulars

Length On Load Water Line	401' 54"
Sheer Per °	132
HT	66
1/16" Len. For °	72.6
1/16" HT	36.5
1/4" For °	36.38
1/4" HT	17.6
Tonnage Coeff. Uncorrected	76


Length Of Erection

POOP	37' 9"
BRIDGE	119' 0"
FORECASTLE	40' 0"


Substitute with masts masts  
moulding etc to Gunways Relief

 


POOP DECK (Unclassified)

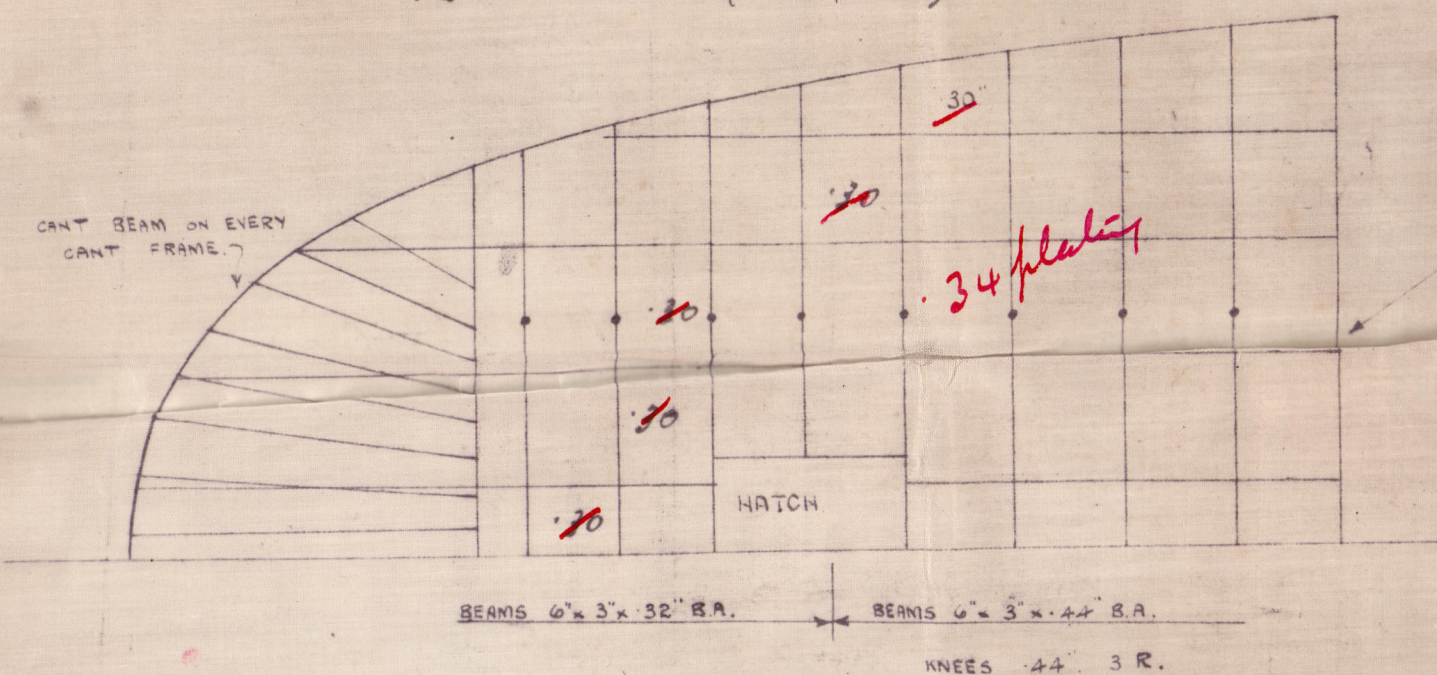


BRIDGE DECK.

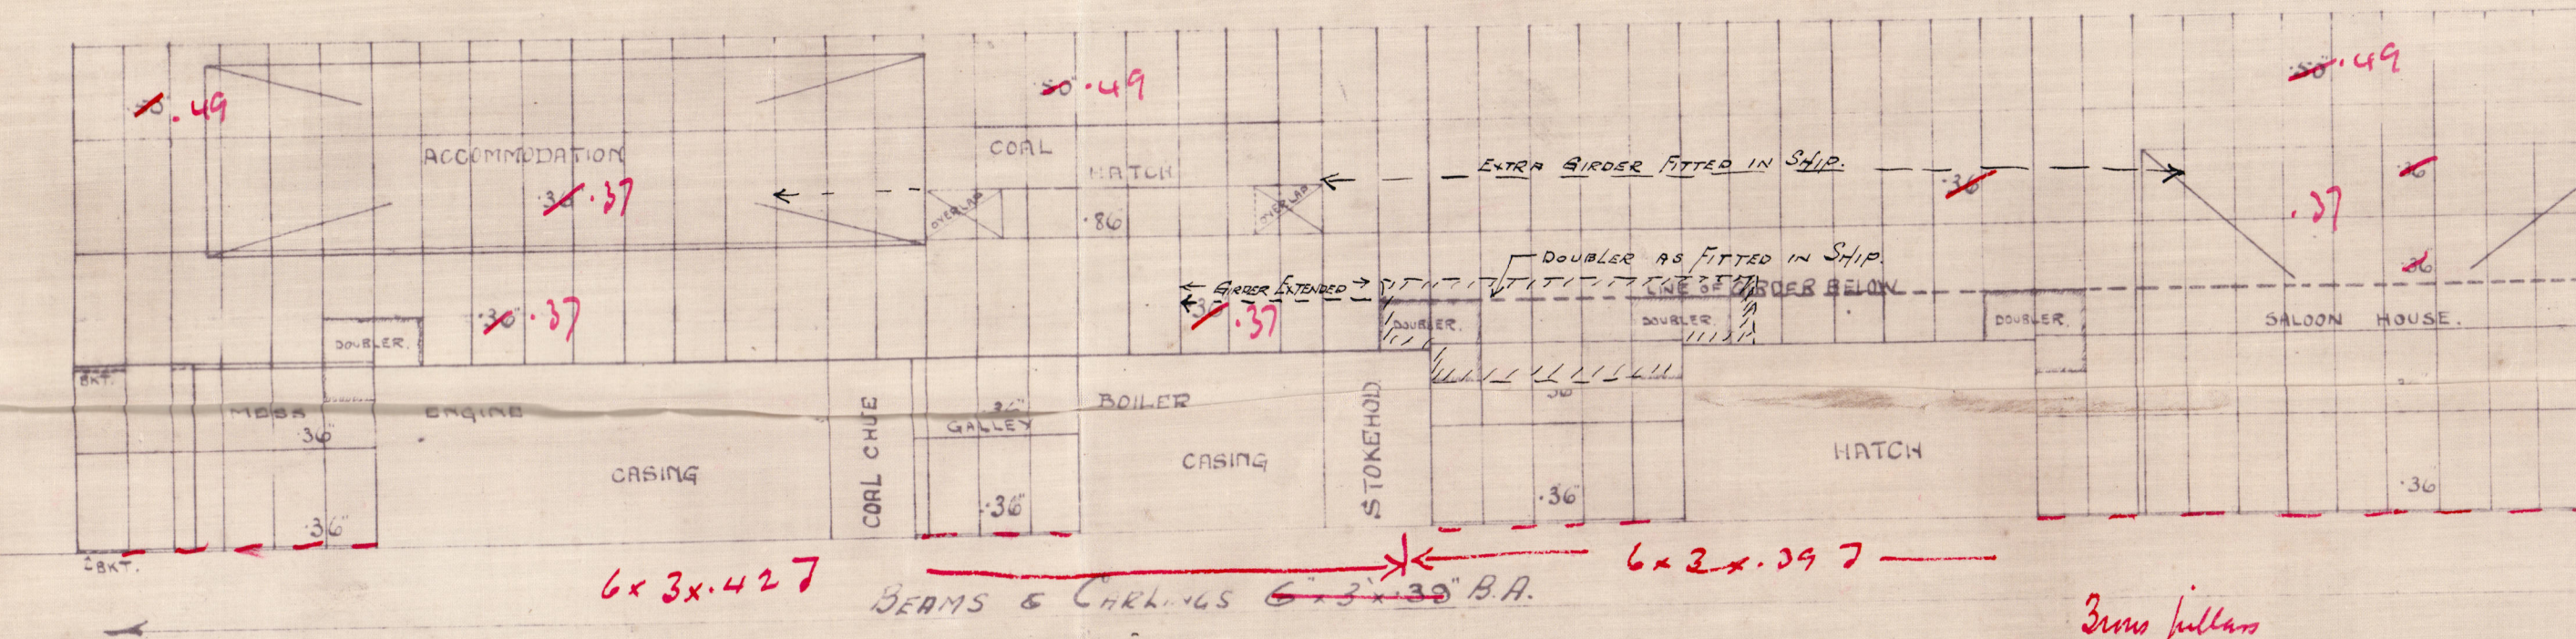

FORECASTLE DECK

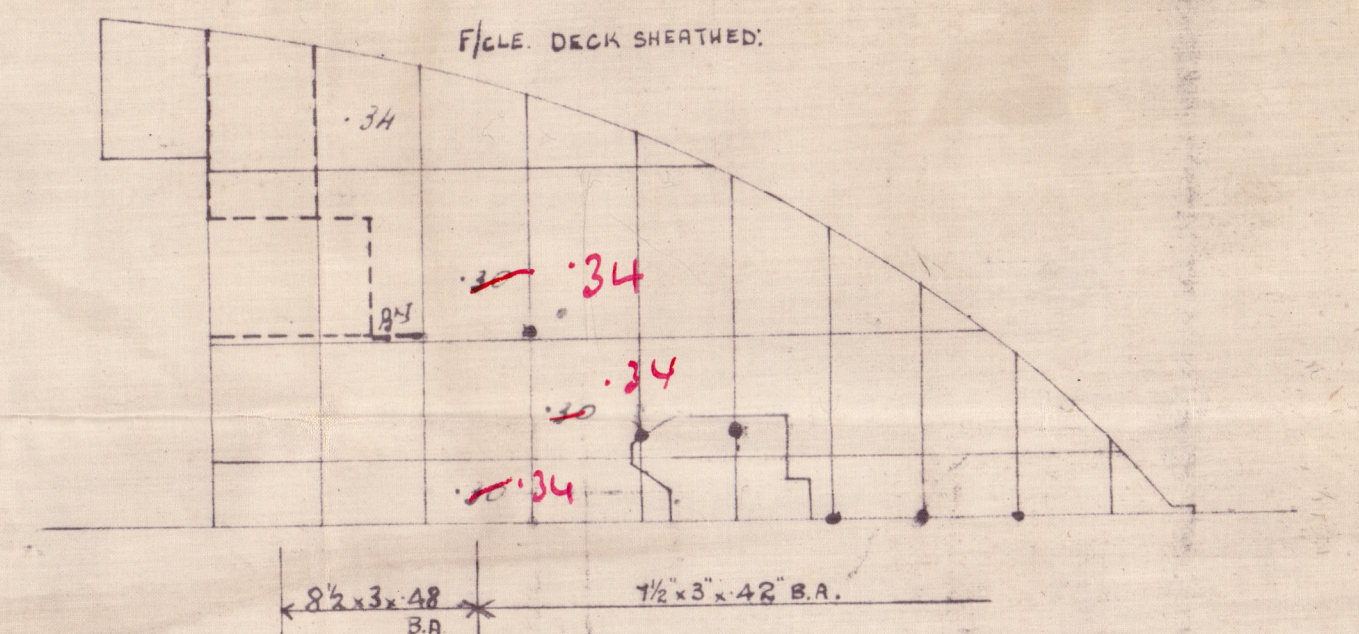

UPPER DECK.

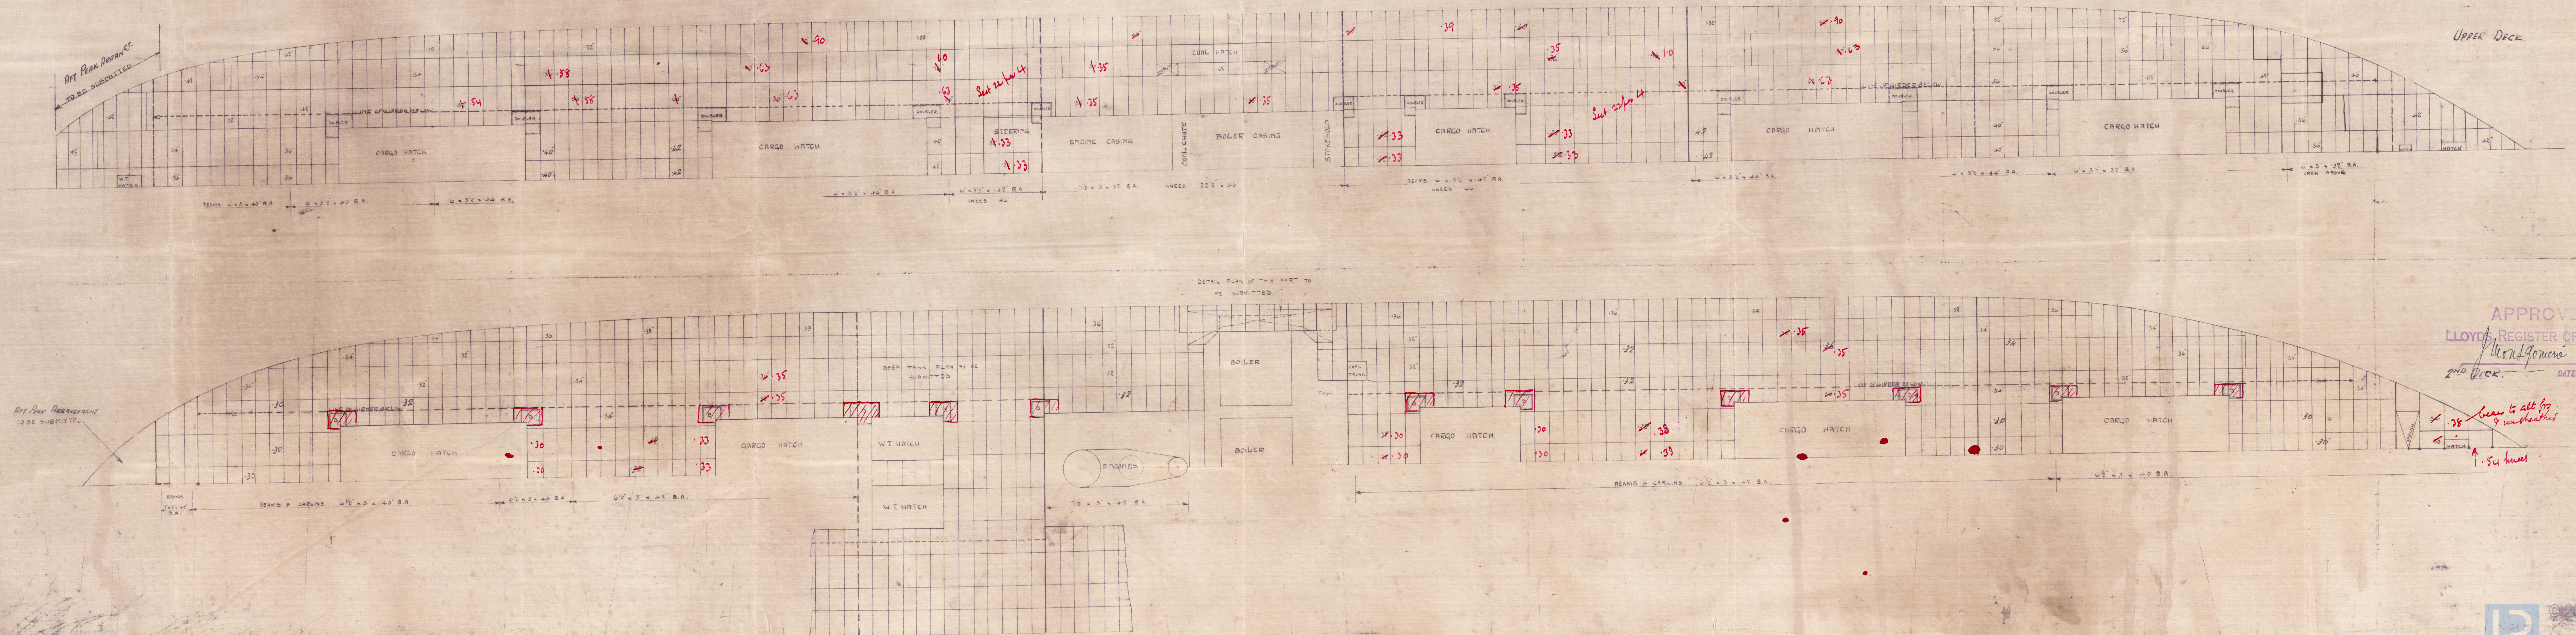

APPROVED  
LLOYD'S REGISTER OF SHIPPING  
18th Dec. 1914  
DATE 18.12.14



Lloyds  
360

W216-0040



© 2021

Lloyd's Register  
Foundation



R. Duncan & Co, Ltd.

No. 360.

Plan of Profile & Works.

S. S. "Luciston".

York Rep. No. 18323.

n.n. "Sheaf Mount".



© 2021

Lloyd's Register  
Foundation

60216-0040