


Bb. side on Bb. side

CRANE PLANT
UNITED SHIPYARDS, INC.
FOOT OF TWENTY-SEVENTH STREET
BROOKLYN, N. Y.

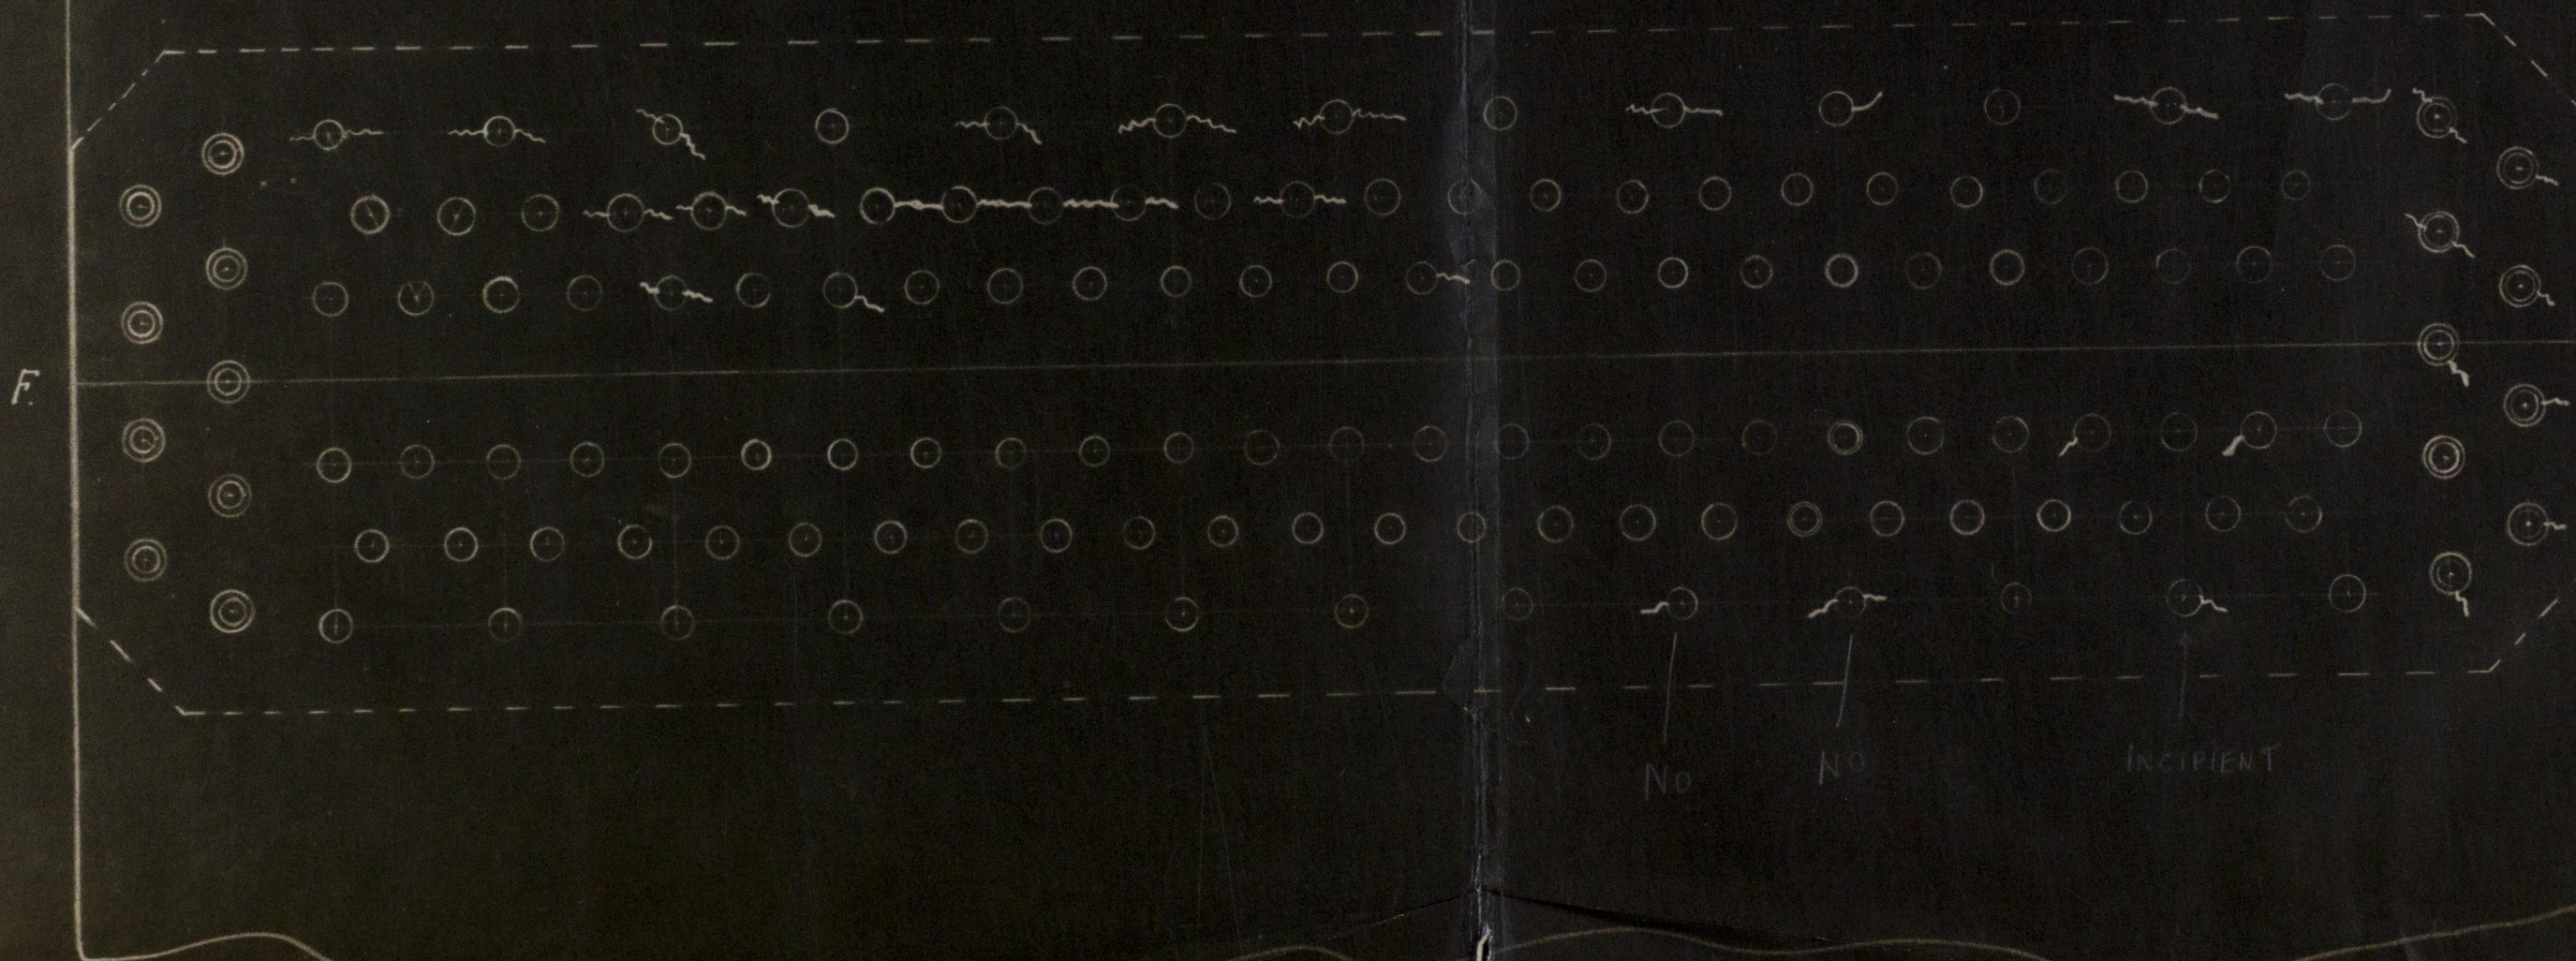

SKETCH N° 2

J S H.

S. Thode Fagelund

No No INCIPIENT



© 1920
Blod's Register
STRAE
Foundation

Thode Fagelund
R 1/2 Rpt 37220

Sketch # 2

J.S.H.

W222-0113



© 2020

Lloyd's Register
Foundation