
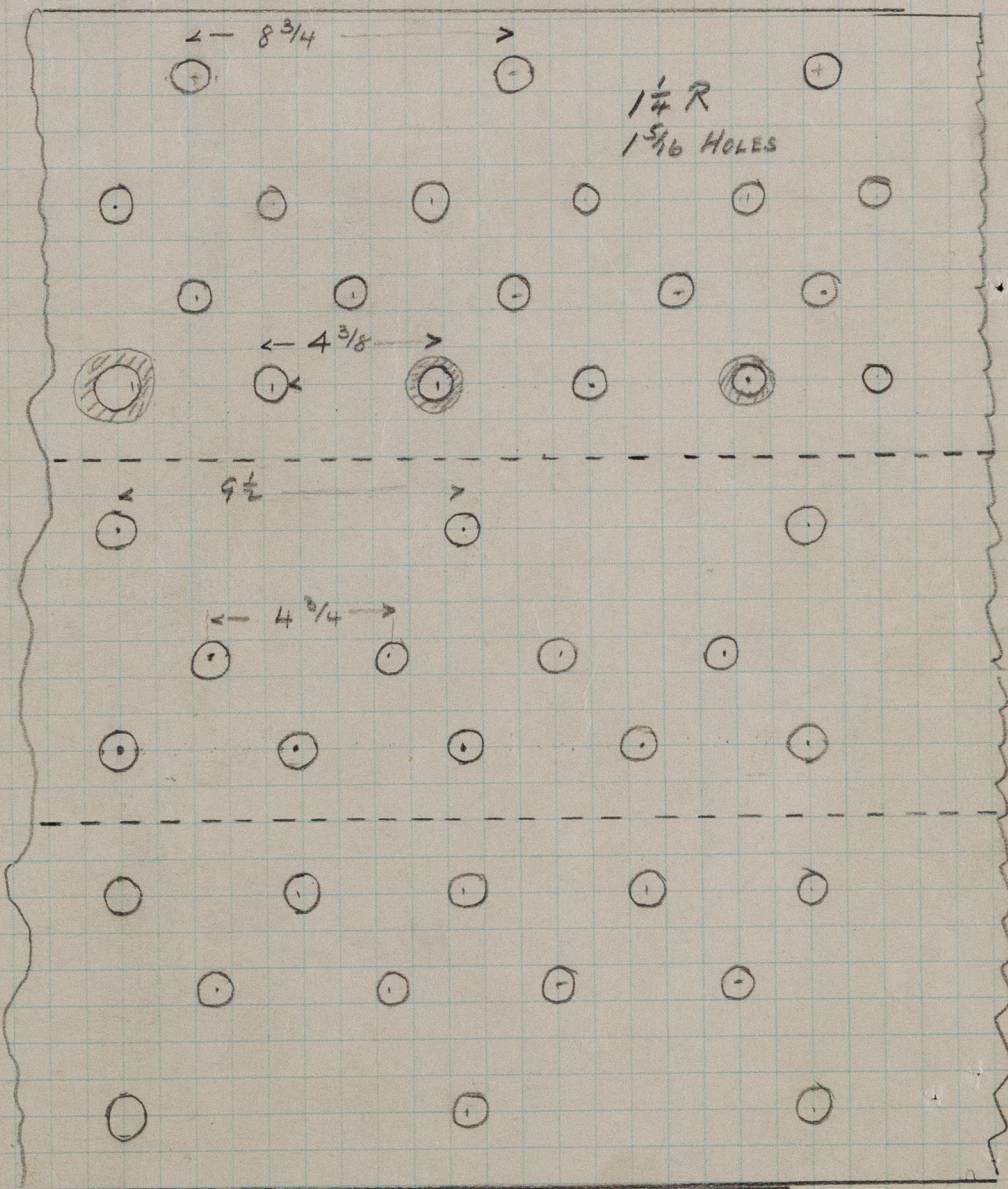


PORT MAIN BOILER
NEW PORT BUTT STRAP

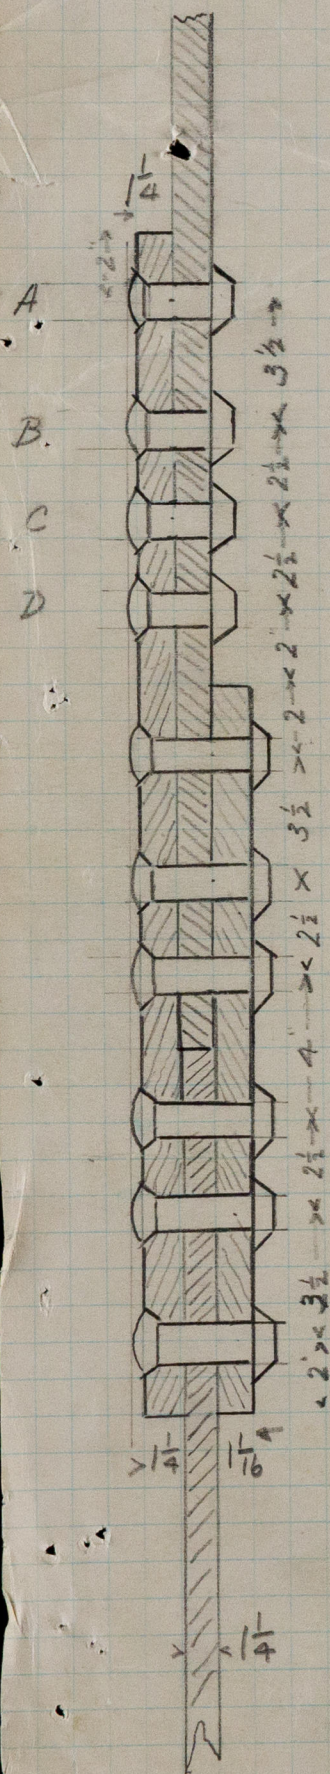

HOLES IN OUTER BUTT STRAP MARKED THUS
REINFORCED BY ELECTRIC WELDING

SKETCH N° 3

N.Y. Rpt 37220

© 2020

J.S.H.

W222-0115