
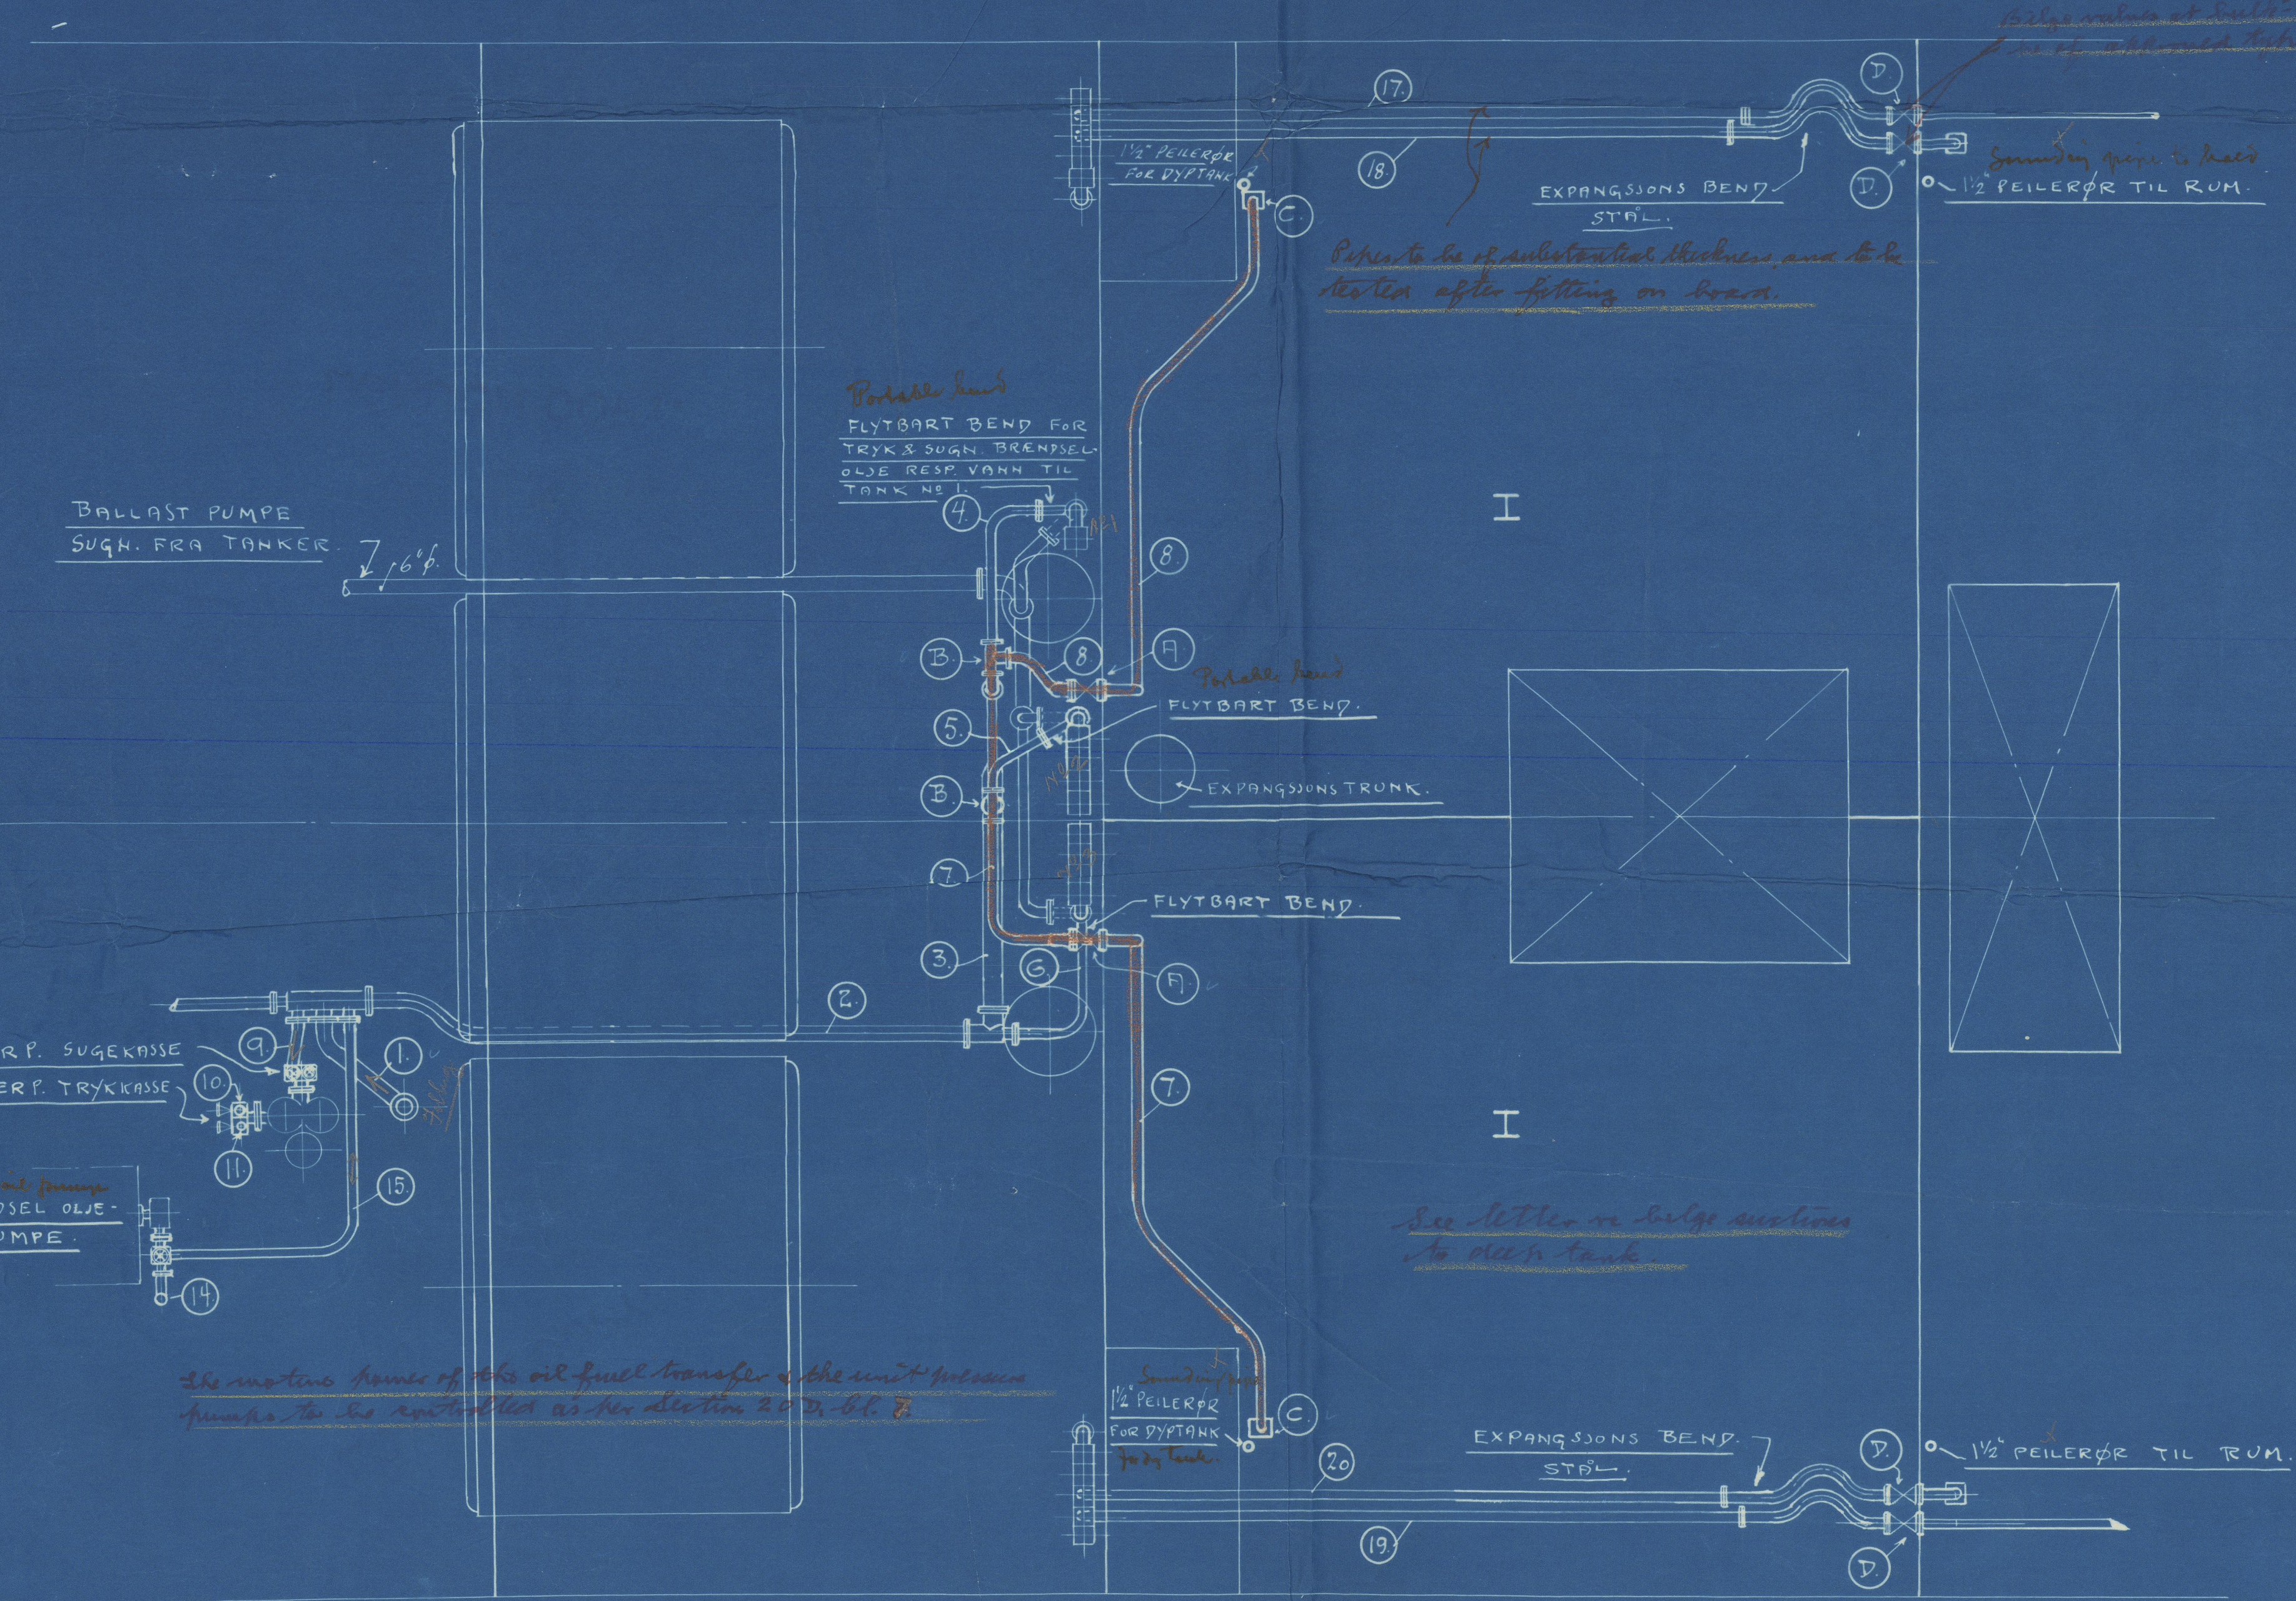


LONDON COPY.

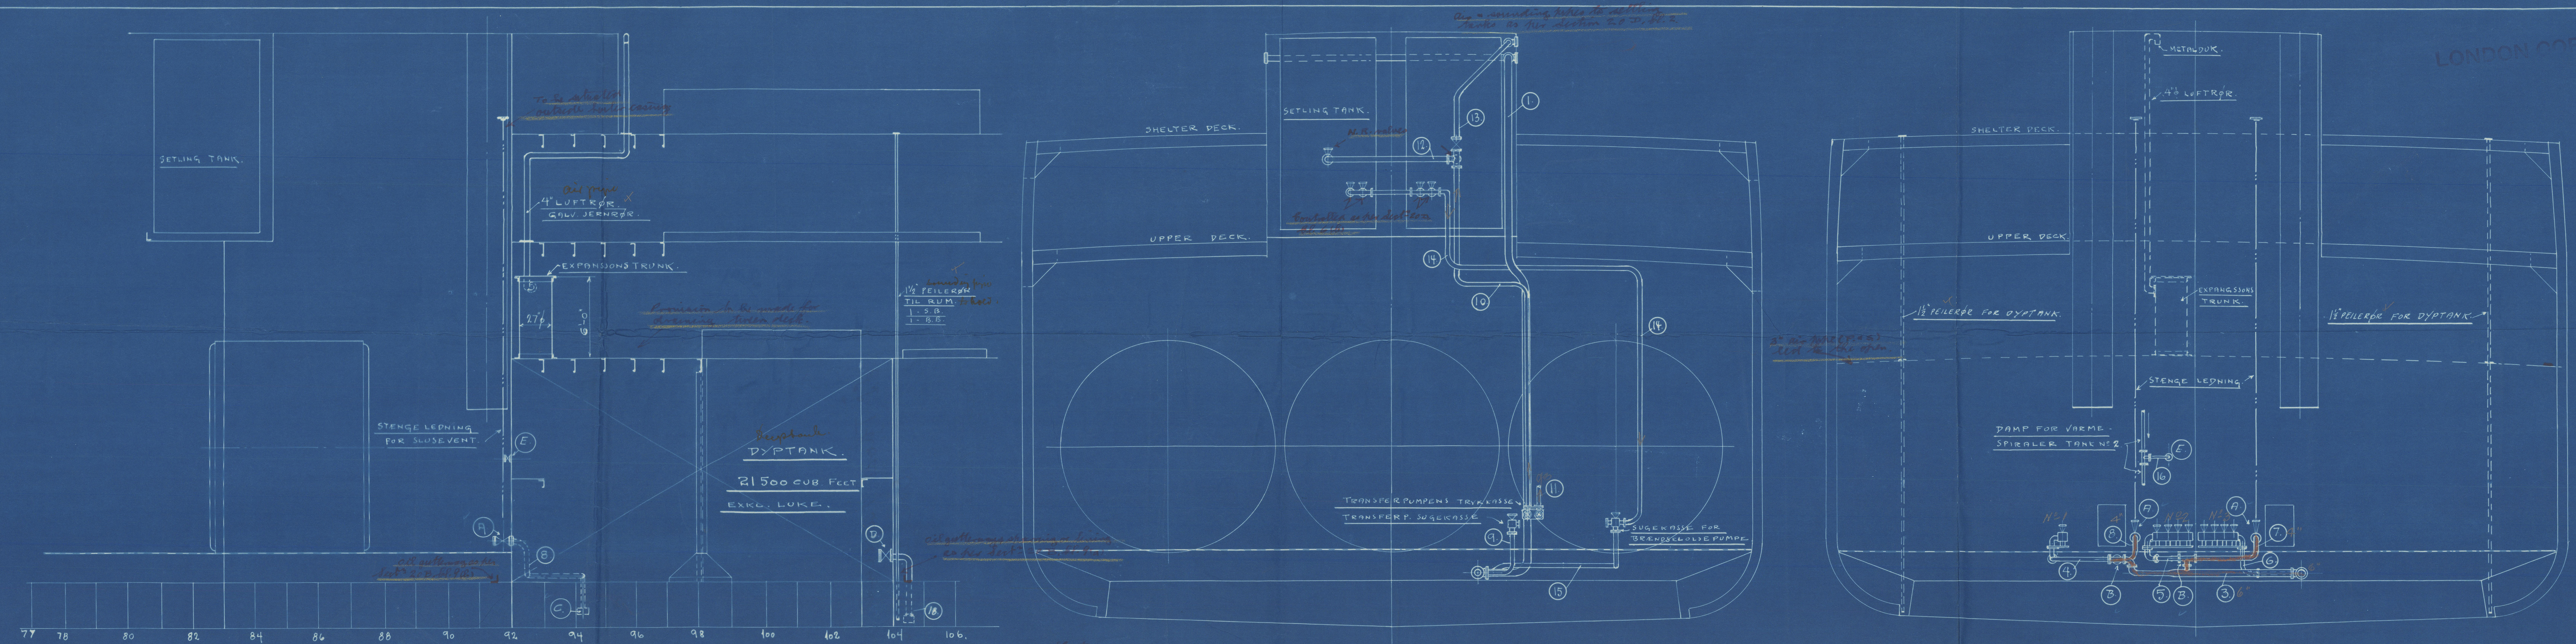

RØRLISTE.

Nº	BENEVNELSE.	INN. DIA.	MATERIAL.
1.	BRENDEL OLJE. FILLINGSRØR FRA DEK.	6"	STÅL.
2.	TRYK OG SUGLEDNING TANKER & DYPTANK	6"	STØPEJERN.
3.	TANK NØ 1-2 TANK.	6"	"
4.	" " " " NØ 1.	4"	STÅL.
5.	" " " " NØ 2.	4"	"
6.	" " " " NØ 3.	4"	"
7.	" " " " DYPTANK. S.B.	4"	"
8.	" " " " " B.B.	4"	"
9.	TRANSFER PUMPE SUG FRA & DYPTANK	3"	"
10.	TRYK TIL & TIL DEK.	3"	"
11.	" " " " OVERBORD.	2"	"
12.	" " " " SETLING TANKER.	3"	"
13.	" " " " DEK.	3"	"
14.	SETLINGTANK TIL BRENDEL OLJE PUMPE. TANKER & DYPTANK	3"	"
15.	SETLINGTANK TIL TANKER OG DYPTANK.	3"	"
16.	UTDAMPNING AV DYPTANK.	1 1/2"	"
17.	LENSERØR RUM NØ 1 B.B.	3 1/2"	STØPEJERN.
18.	" " " " 2 "	3 1/2"	STÅL.
19.	" " " " 1 S.B.	3 1/2"	STØPEJERN.
20.	" " " " 2 S.B.	3 1/2"	STÅL.
21.			

ARMATURLISTE.

MERKE.	TEGN. NØ.	ANTAL	BENEVNELSE.	DIMEN. SION.	MATERIAL.
A.		2.	SLUSEVENTIL.	4"	STØPEJERN.
B.		2	GRENRØR.	4"	"
C.		2	SILER.	4"	"
D.		4	TILBØKESLØG VENTIL.	3 1/2"	"
E.		1	VENTIL.	1 1/2"	METAL.

The remaining requirements of section 81 of the regulations are to be supplied with an 18-3-35.

18-3-35

1					
ANTAL	ORDRE	1/2 HODE FAGLUND			18-3-35
SETT.	NE.	ANVENDT FOR:	ANMERKNING.		DATO.
ARRANGEMENT AV RØR TIL DYPTANK FOR BRENDEL OLJE.					
SKALA: 1/4" = 1'-0" ENG.					
NYLANDS VERKSTED.					
OSLO 18-3-35.					
TEGNET.	TRACET.	EFTERSET.			
P. Hain	P. Hain		Z. 2050.		

S. J. Thode Fajelund

Osl. ref. No. 4524.

Deep tank in No 3 hold

W222-0155



© 2020

Lloyd's Register
Foundation