


# S.S. "TILBOET"

## TANK TOP

OIL TANKS

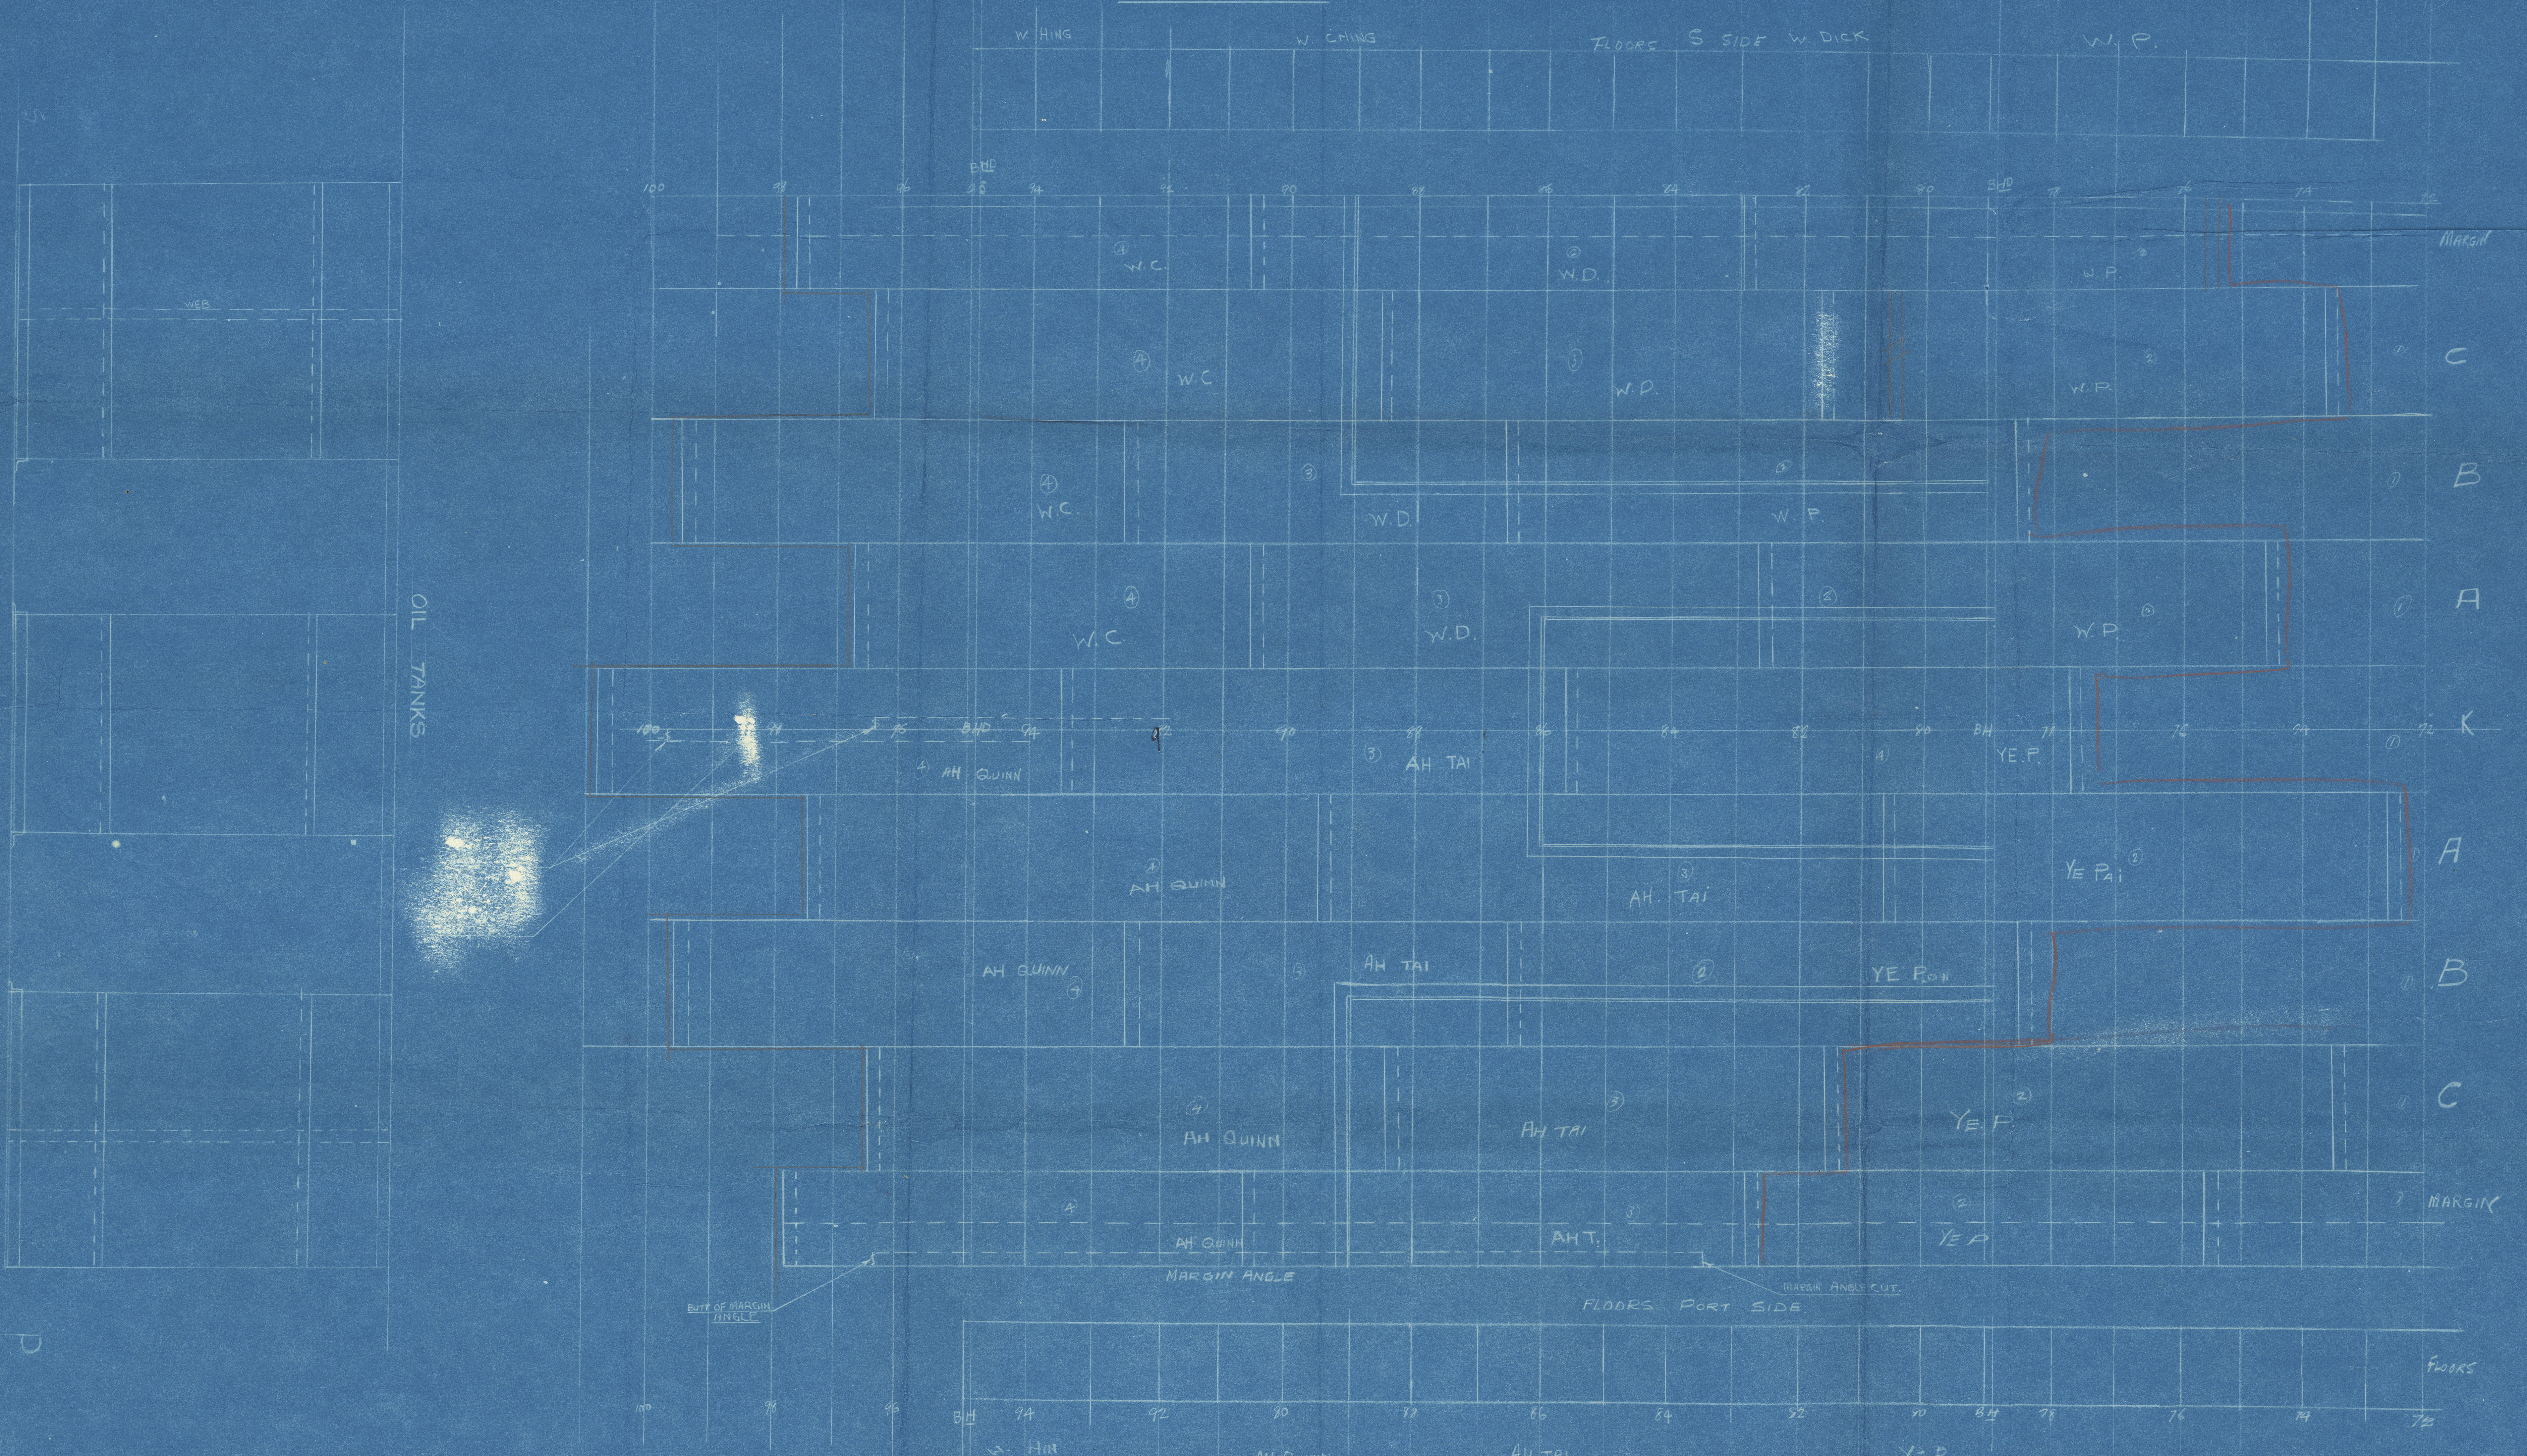

DRAWING No. 13693


W12-0165



Hong Kong Rep. No. 6136.

---

W223-0165

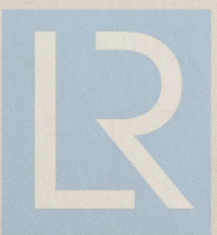

© 2019

Lloyd's Register  
Foundation