


14-3-05

STEEL BOILER 9'-6" DIAM BY 9'-6" LONG LLOYDS SURVEY 100 W.P.

SCALE 1/4" = 1 FT.

No 3511 for Messrs Craig Taylor & Co. J.S. No 109-

RILEY BROS (BOILERMAKERS) LIMITED
No. 15/3/05
STOCKTON
9.1.11

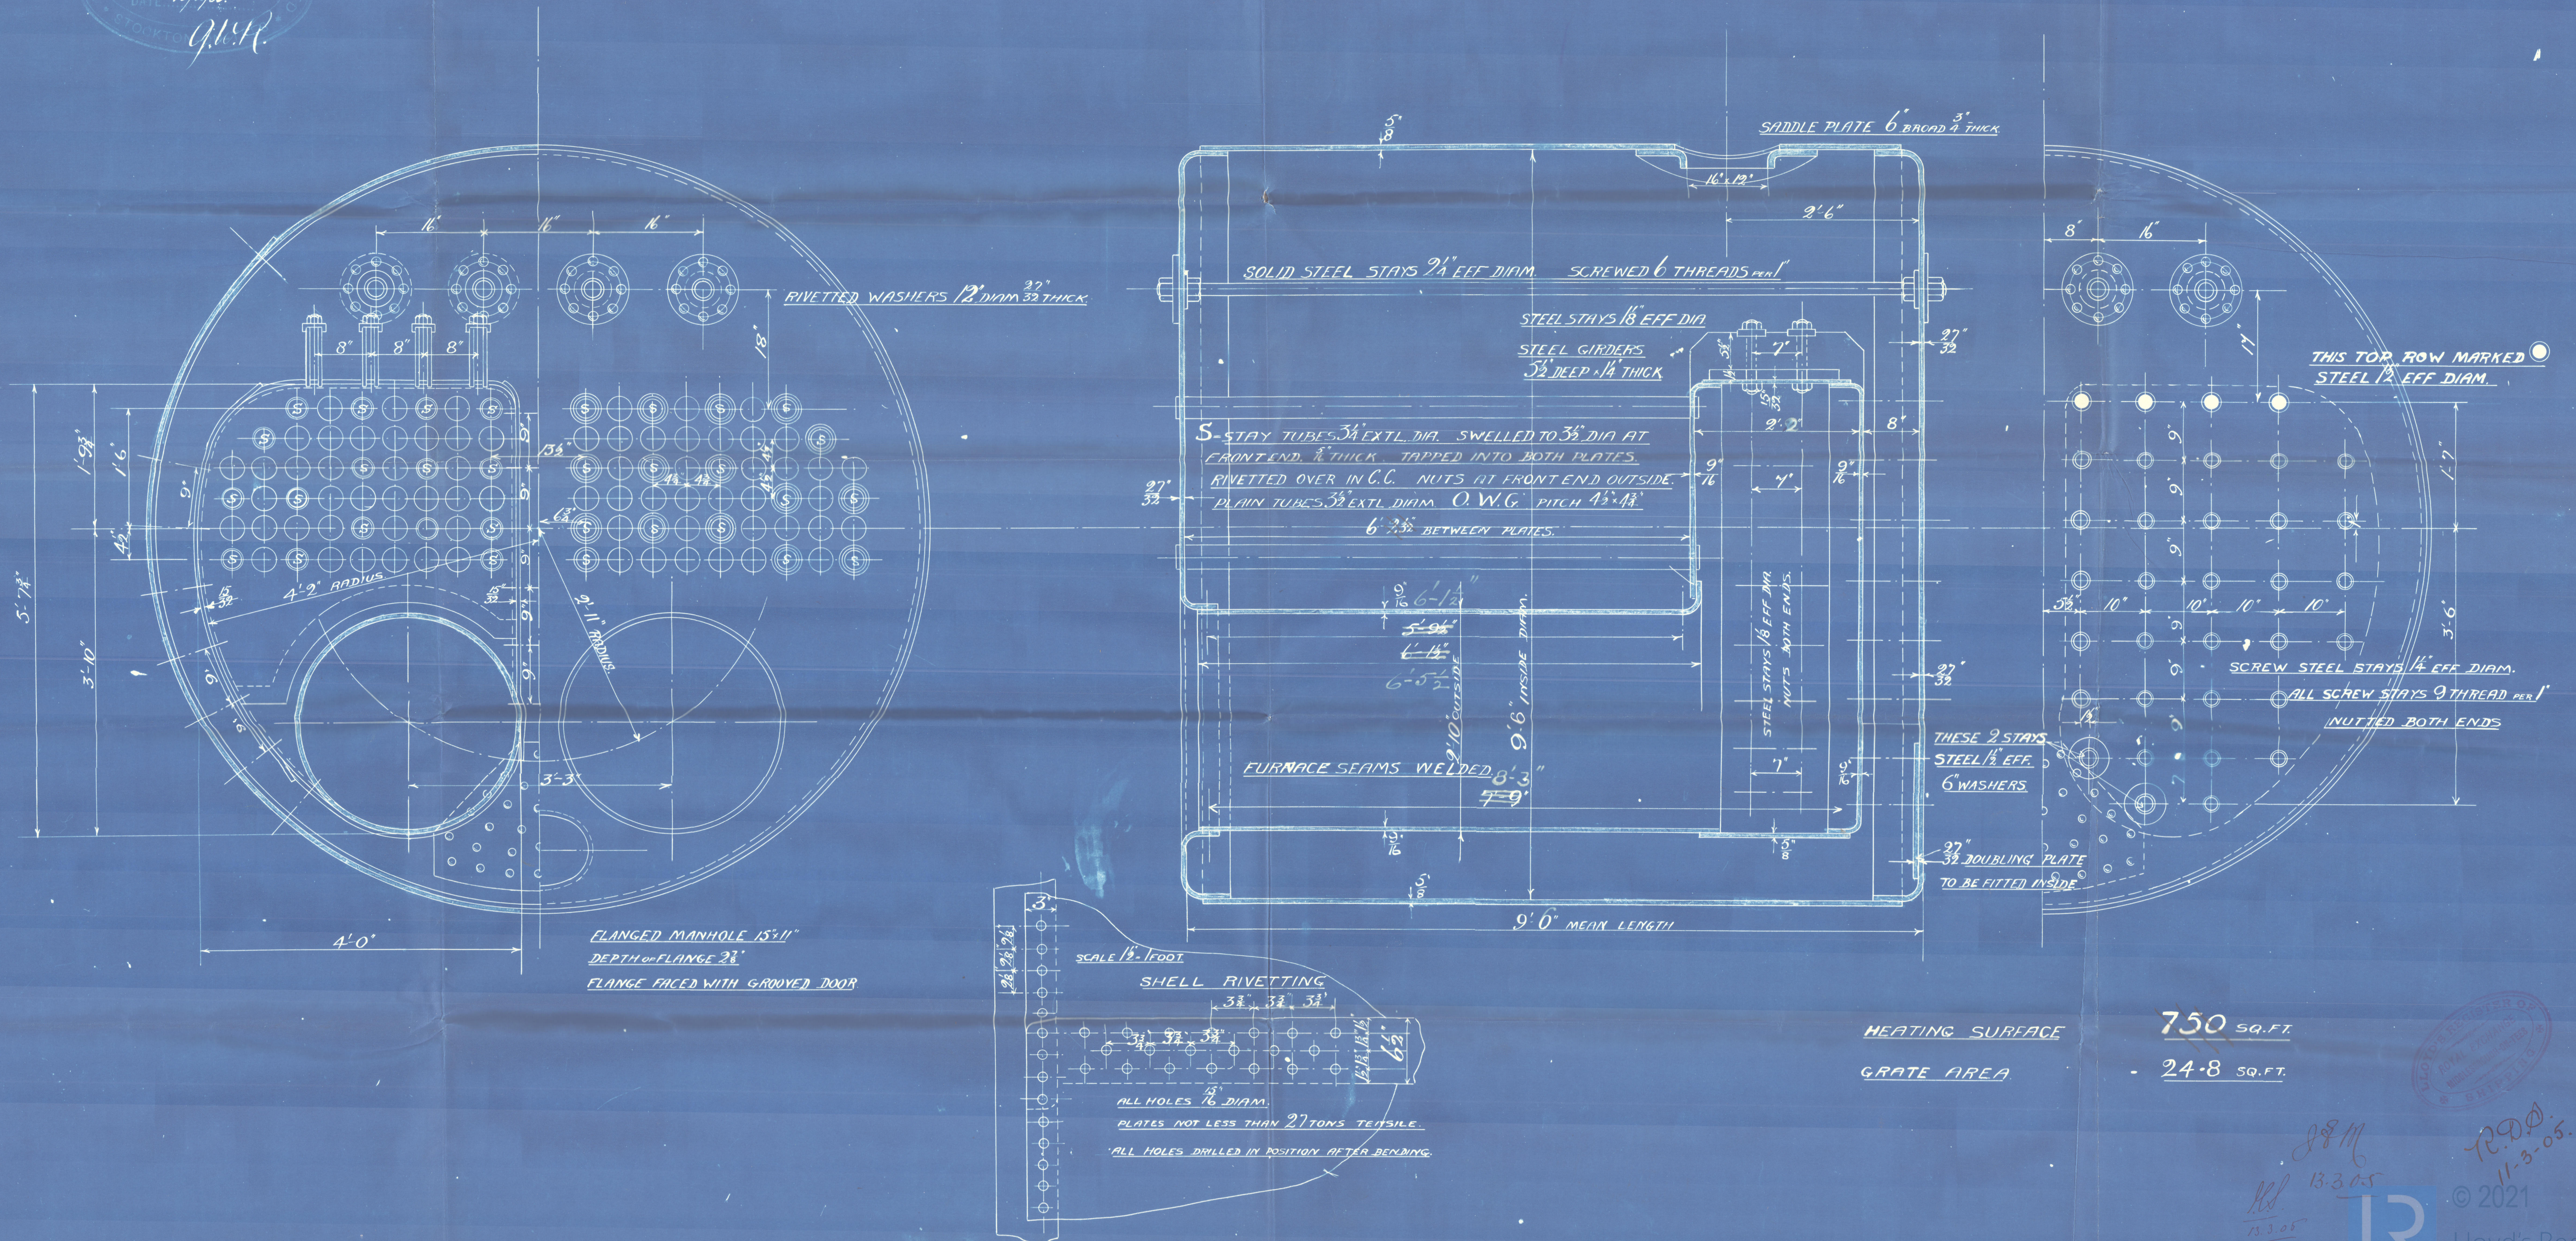

750 SQ. FT.
24.8 SQ. FT.

13.3.05
11-3-05
R.D.D.
© 2021 Lloyd's Register Foundation


Wesley Brown & Co

No 3511

For Gray Taylor & Co

SS No 109

W.P. 100 lbs

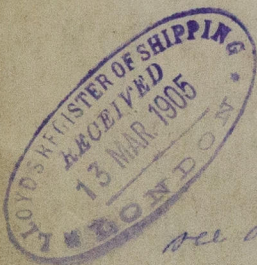

see amended plan

S.S. Ballochmyle

N.N. "Aghios Spyridon"

Mdb. 4173.

No.	3457
LLOYD'S TEST	
200	
G.T.M.	
30-5-05	

20 plates

As per amended plan

Aghios Spyridon

LR

© 2021

Lloyd's Register
W232-0076
Foundation