


16.11.34

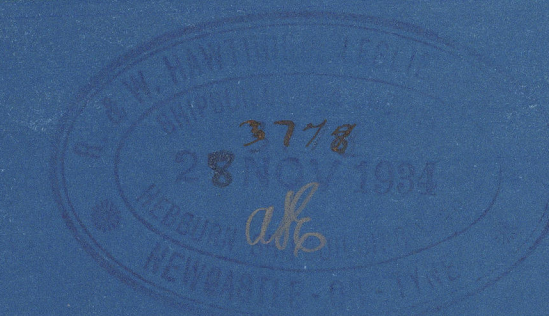

N° 595


PROFILE & DECKS

SCALE 1/8" = 1 FOOT


PRELIMINARY

FOR PILLARS, GIRDERS & C.L.B.D.
SEE SEPARATE PLAN

See later plan



 


UPPER DECK

 

Plan approved for deck construction only

SECOND DECK

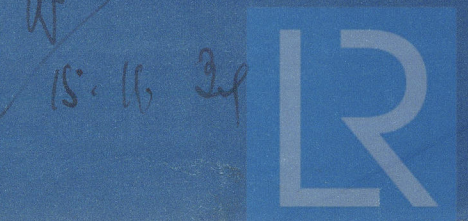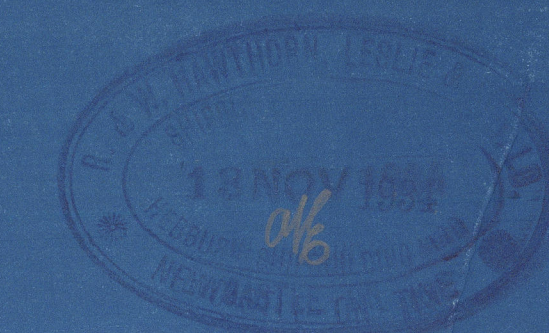 

10240-0619

59855


Profile

Harbour Leslie

(2)

15/11/54

See later

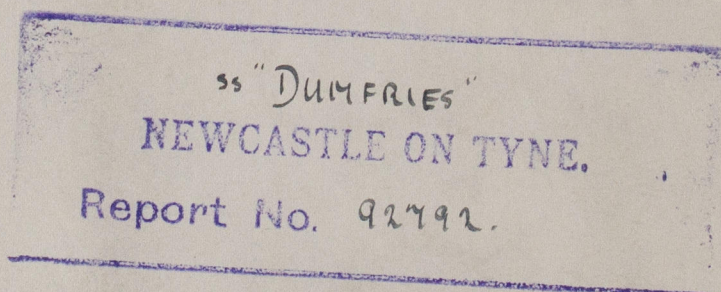

W240-0019



© 2020

Lloyd's Register
Foundation