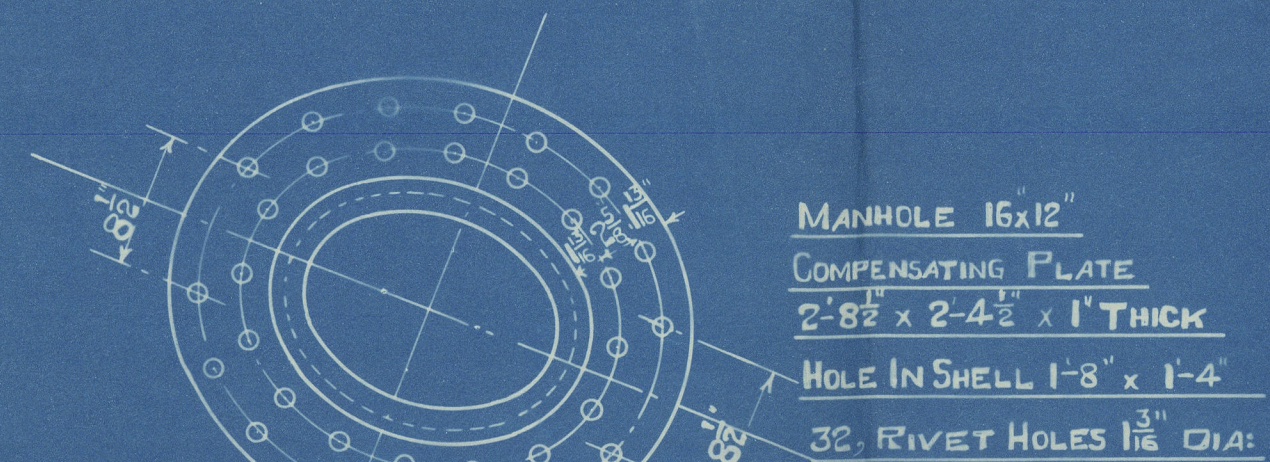


SCALE :- 1 INCH = 1 FOOT.

$$\underline{\text{SHELL W.P.}} = \frac{(26-2) \times 29 \times 85.6}{2.75 \times 142.375} = \underline{152 \text{ LBS./sq"}}$$


4, LIFTERS THUS.

ONE OFF.

NOTE:- ALL STAYS SCREWED THROUGH BOTH PLATES & FITTED WITH NUTS AT BOTH ENDS.

ALL HOLES DRILLED IN PLACE AFTER PLATES ARE BENT.

CONTRACT ~~2662-2698~~ 270

ss "DUMFRIES"
NEWCASTLE ON TYNE.

Report No. 92792.

The North Eastern Marine Eng. Co. Ltd

Contract N^o 2815

Donkey Boiler

W.P. 150 lbs./sq"

R. W. Hawthorn, Leslie & Co. Ltd.
Yard N^o 595

Mark on Boiler

N^o 639

LLOYD'S TEST

275 lbs./sq"

W.P. 150 lbs./sq"

H.C.F.

294.85

W240-0023



© 2020

Lloyd's Register
Approved 11.1.35
Foundation

BTP 2-63



© 2020

Lloyd's Register
Foundation