

Matafale

SHIP NO 800
MIDSHIP SECTION

HKG.8211 TWIN SCREW MOTOR VESSEL

DIMNS:-110'-0" B.P. \times 25'-6" \times 11'-6" MLO.





SCALE 1/2" = ONE FOOT

CLASS :- * 100 A.I. LLOYDS


NOTE :- VESSEL WILL BE BUILT FROM STOCK MATERIALS AND SCANTLING IN BLUE INDICATES NEAREST STOCK SIZE WHICH WILL BE USED IN CONSTRUCTION OF VESSEL

NUMERALS:- $L \times D = \frac{110.8}{40} \times \frac{12.86}{11.5} = 1.265$
 $L(B+D) = \frac{110.8}{40} (25.5 + 11.5) = 4070$
 $\frac{L}{D} = \frac{110.8}{11.5} = 9.579.72$
 $d = 11.5 - 1.17 = 10.33$ IN HOLD
 FORECASTLE = 31'-10" = 35% SUPERSTRUCTURE

EQUIPMENT NUMBER:- $1(B+D) = 4135$
 4070
 FORECASTLE $\frac{3}{4} (31.5 \times 7.5) = 179.162.5$
 UPPER DECK HOUSE $\frac{1}{2} (41.5 \times 7.5) = 144.173 + (5.2 \times 7.5 \times \frac{3}{4} = 29.2)$
 BRIDGE DECK HOUSE $\frac{3}{4} (25.0 \times 7.5) = 44.160.7$
 CAPTAINS HOUSE $\frac{1}{2} (9.75 \times 7.5) = 37$
 $= 4574 = \text{LETTER } d$
 4078

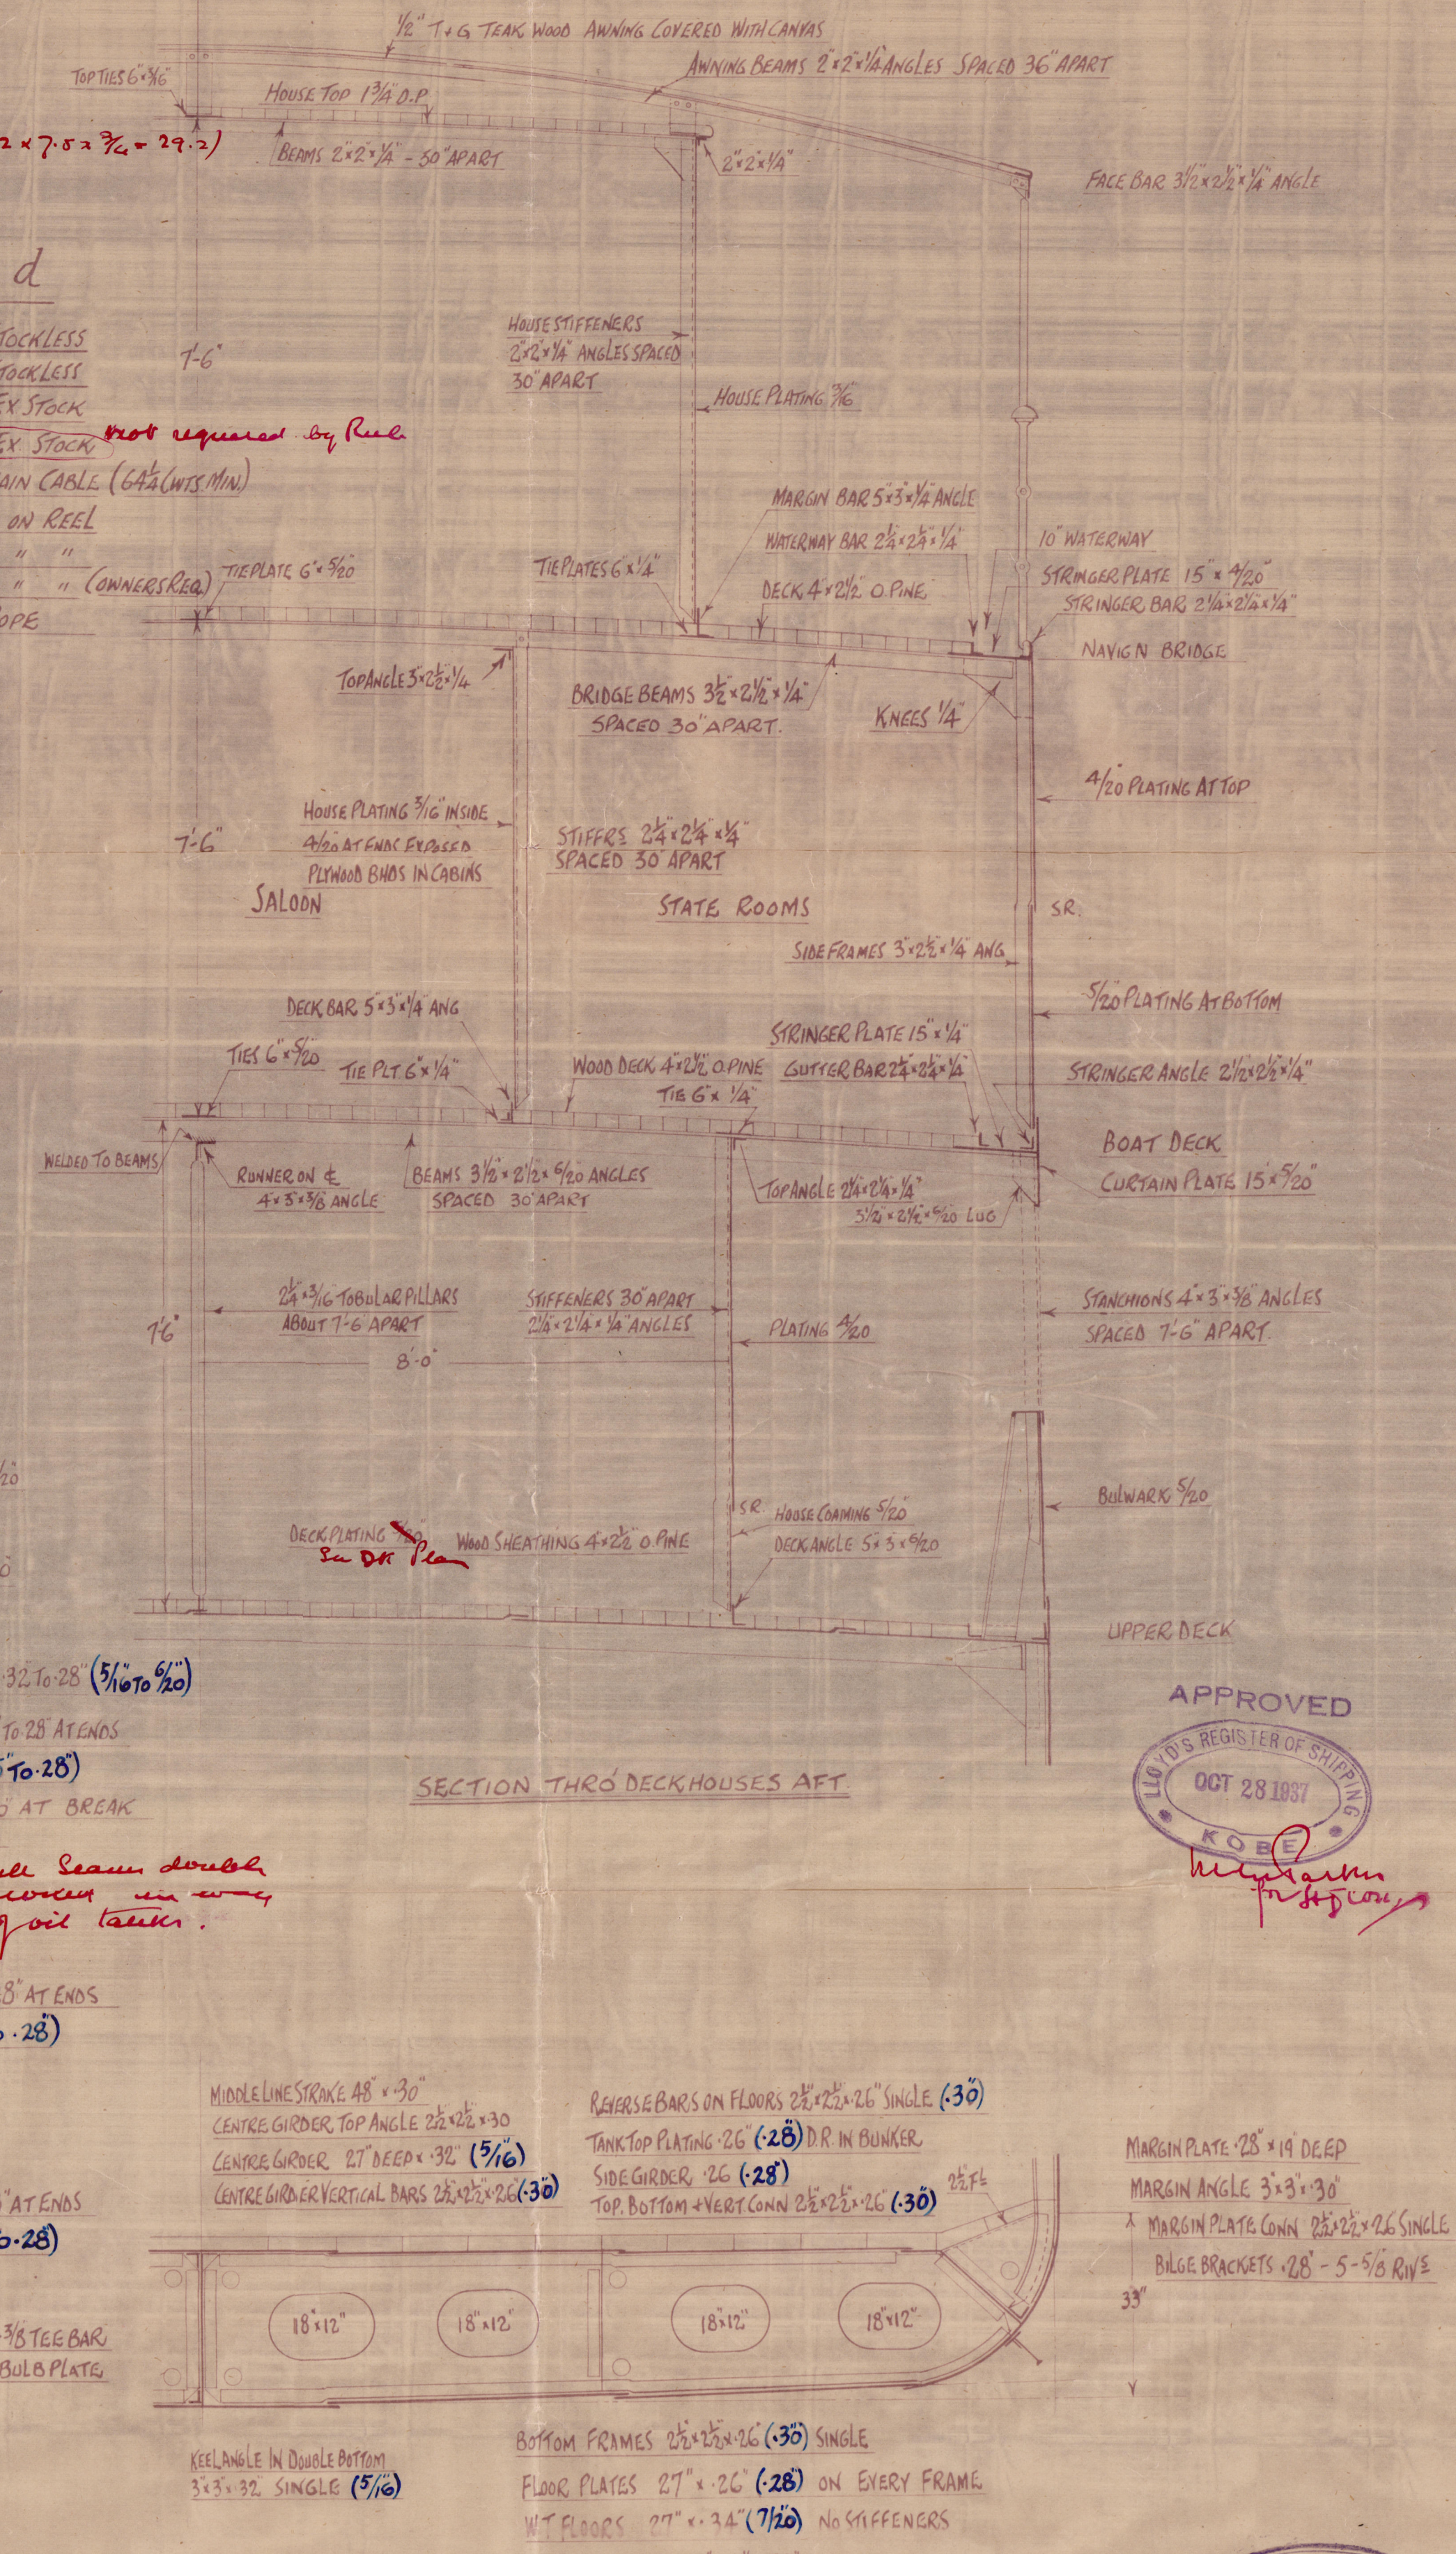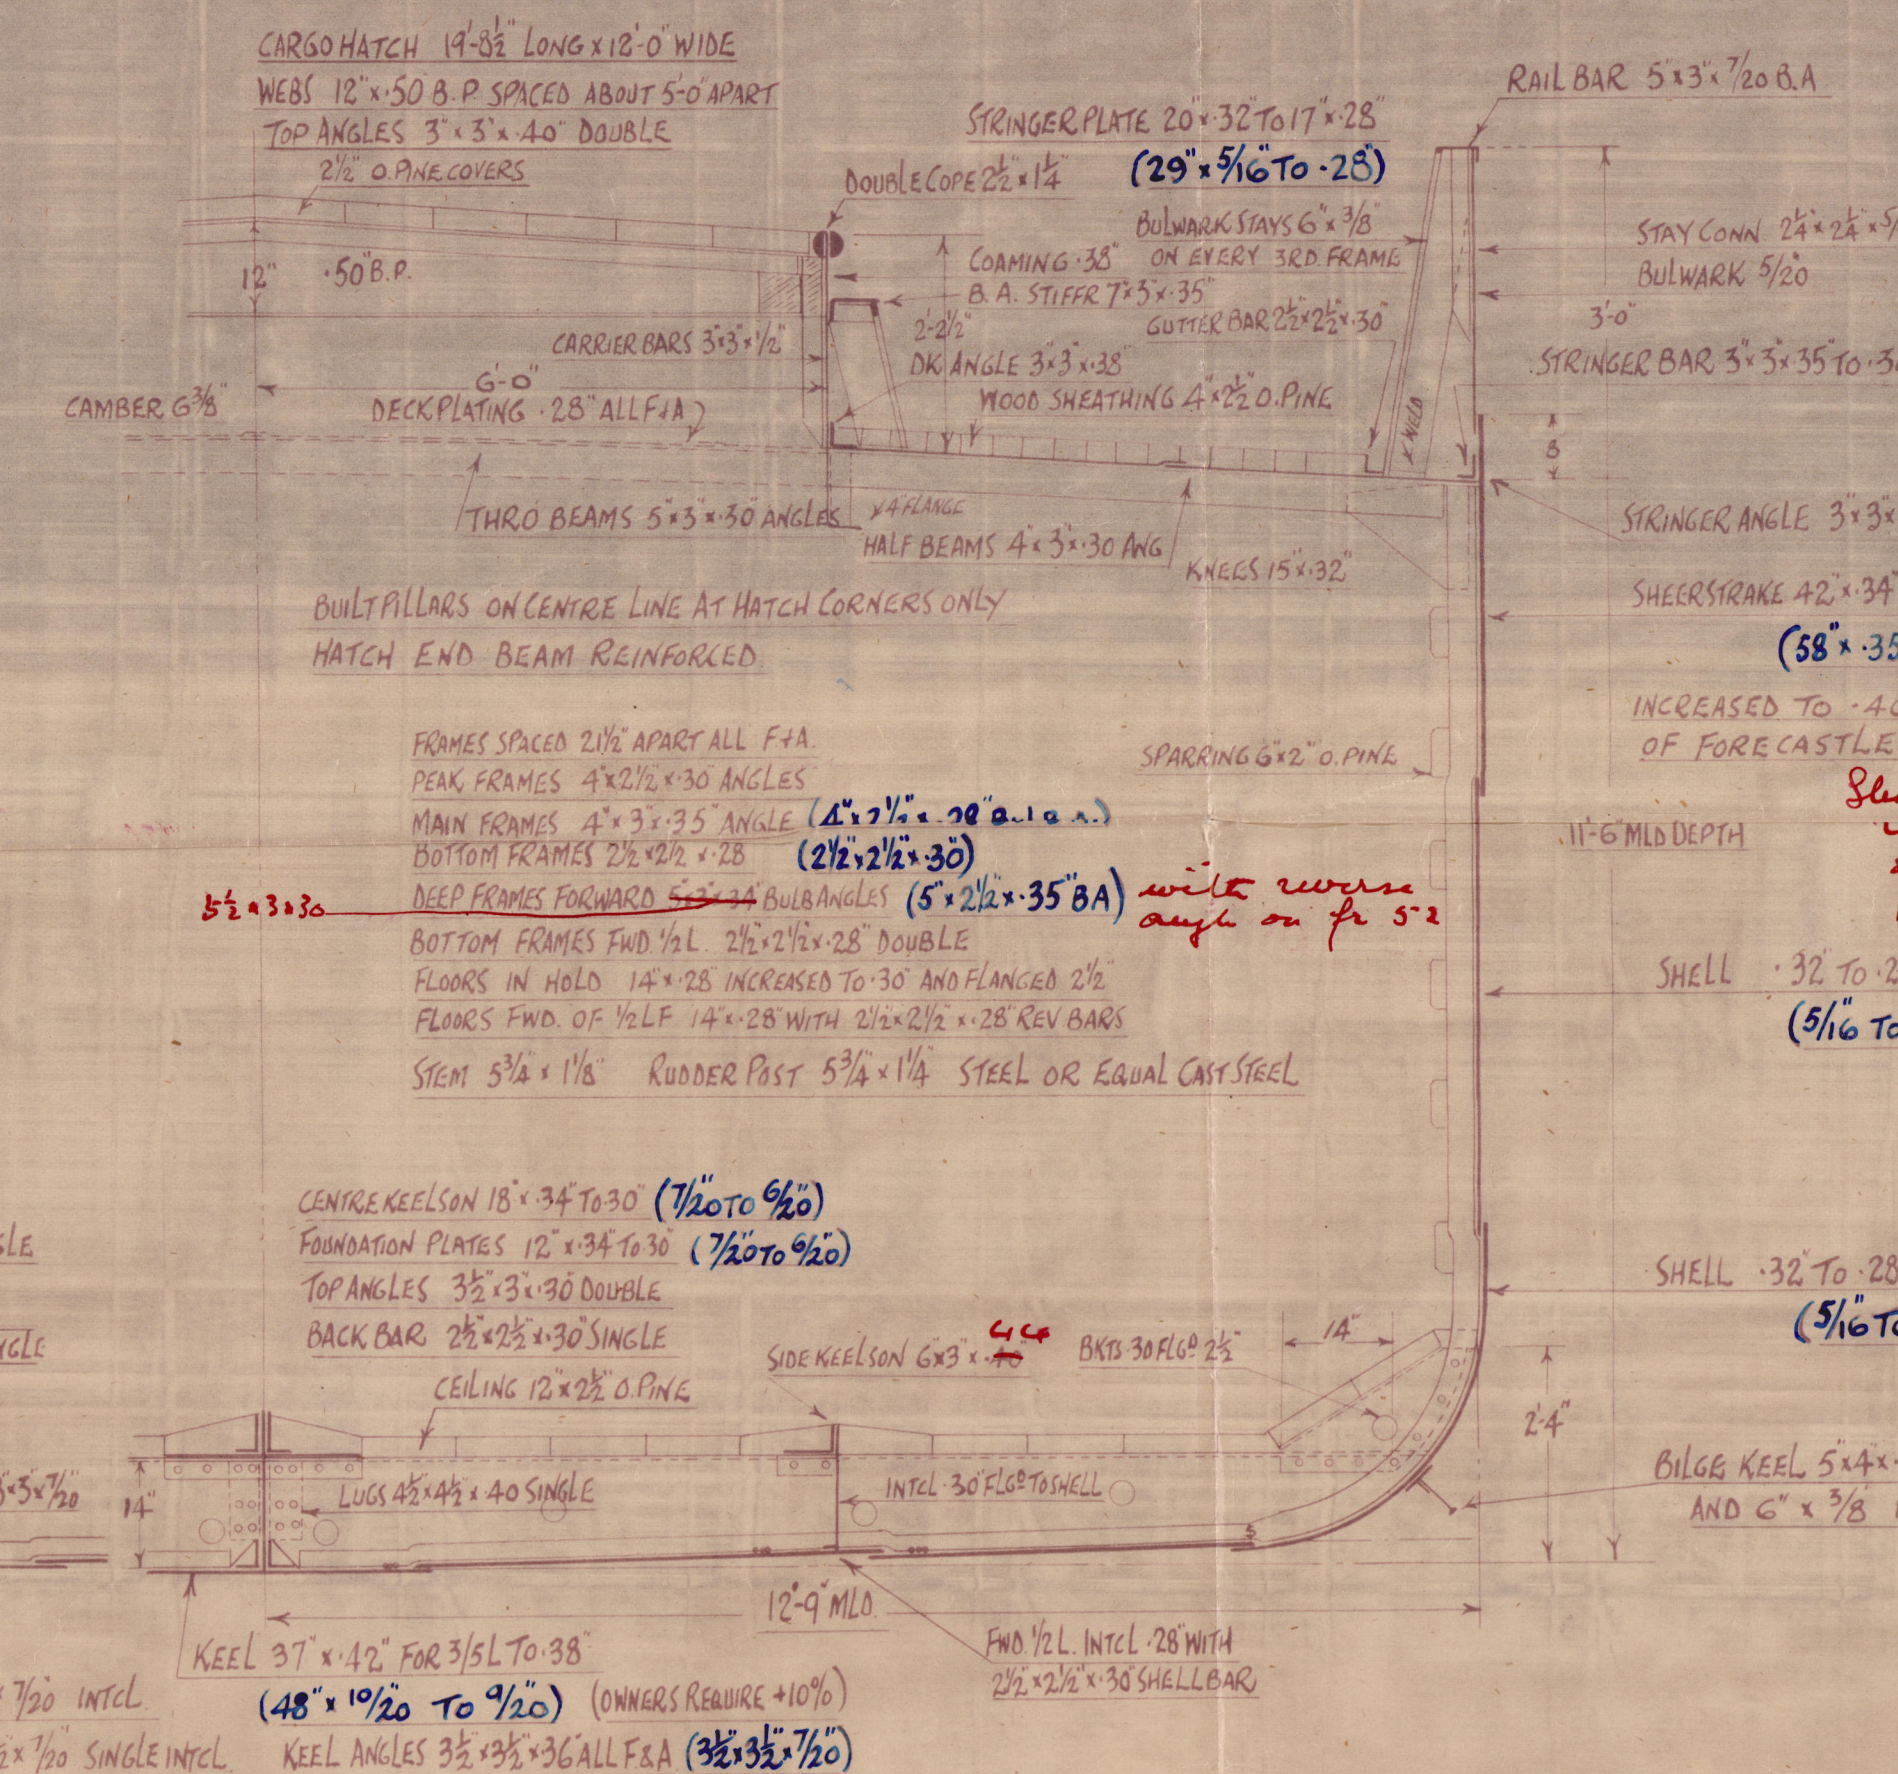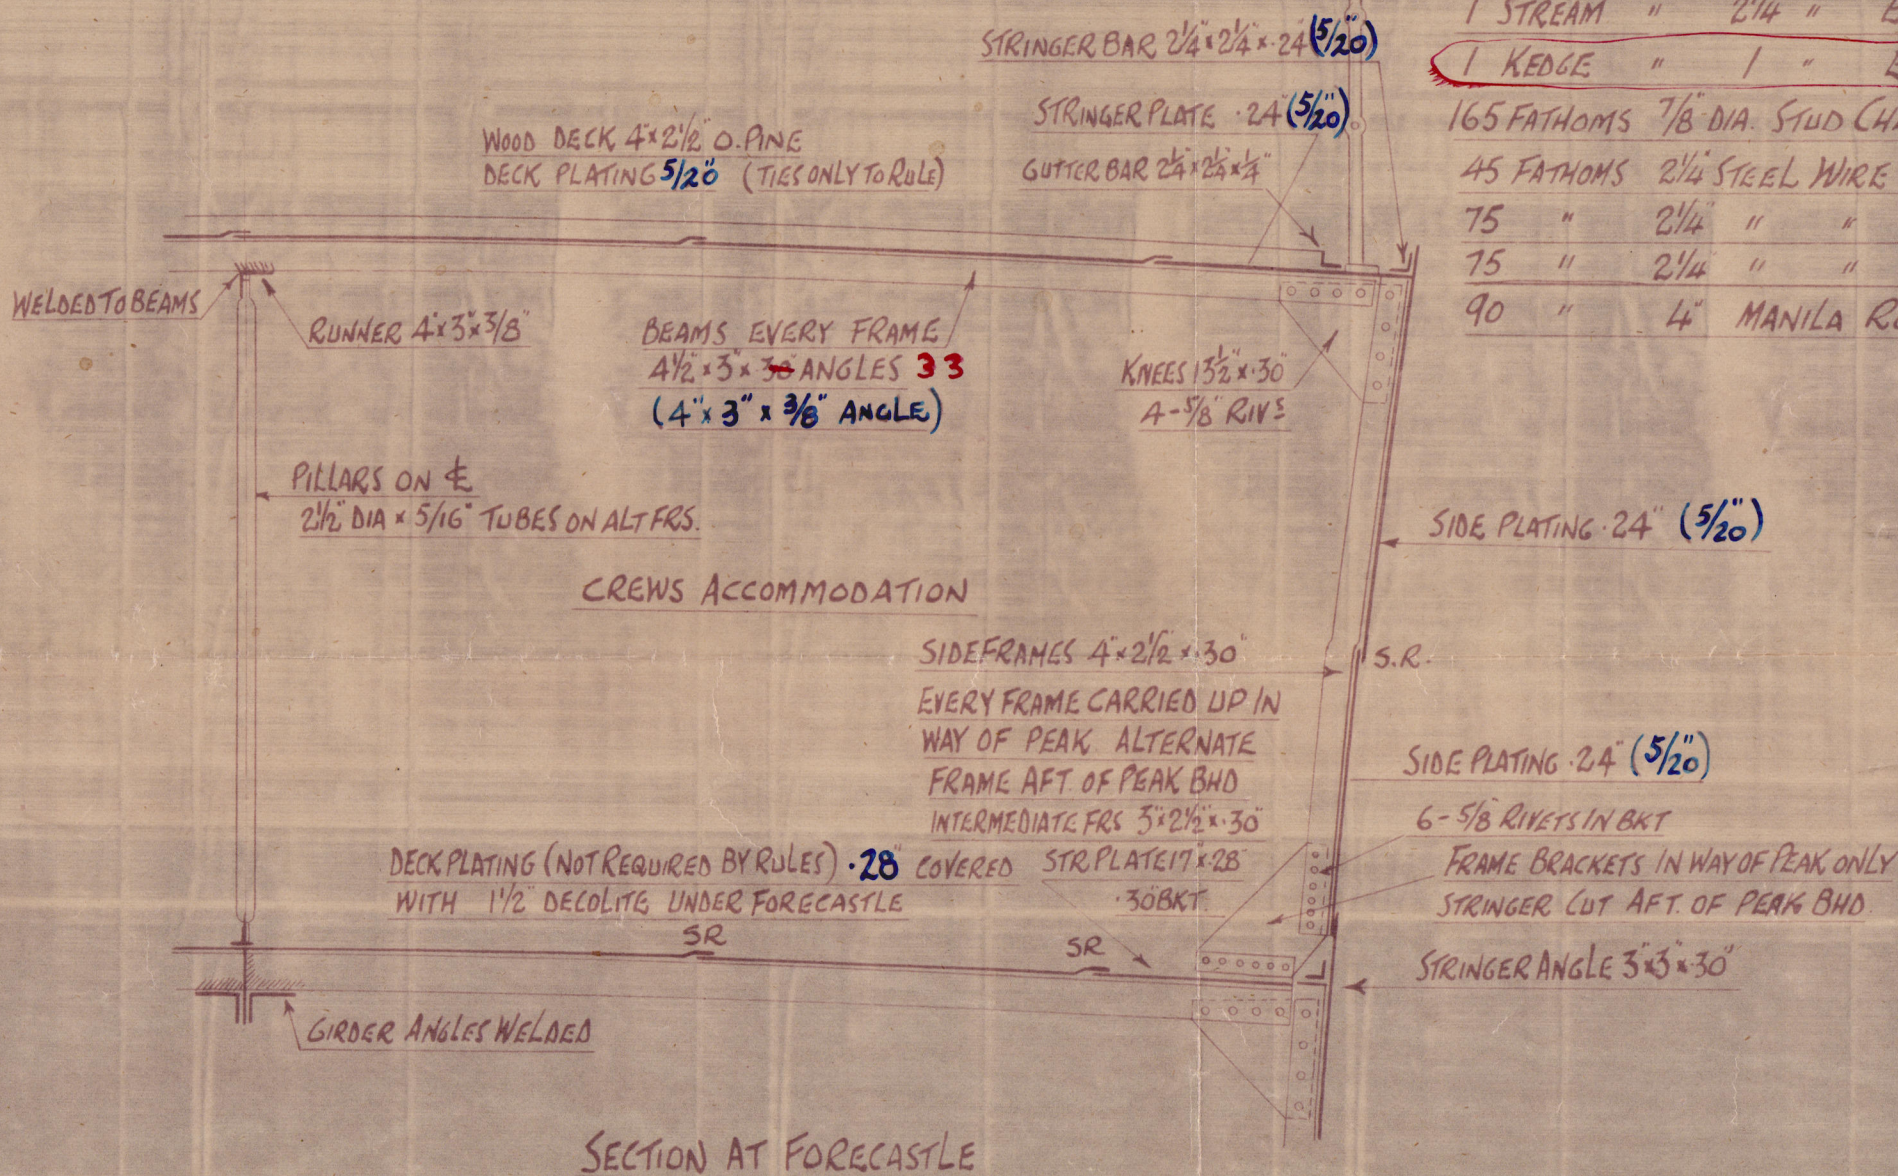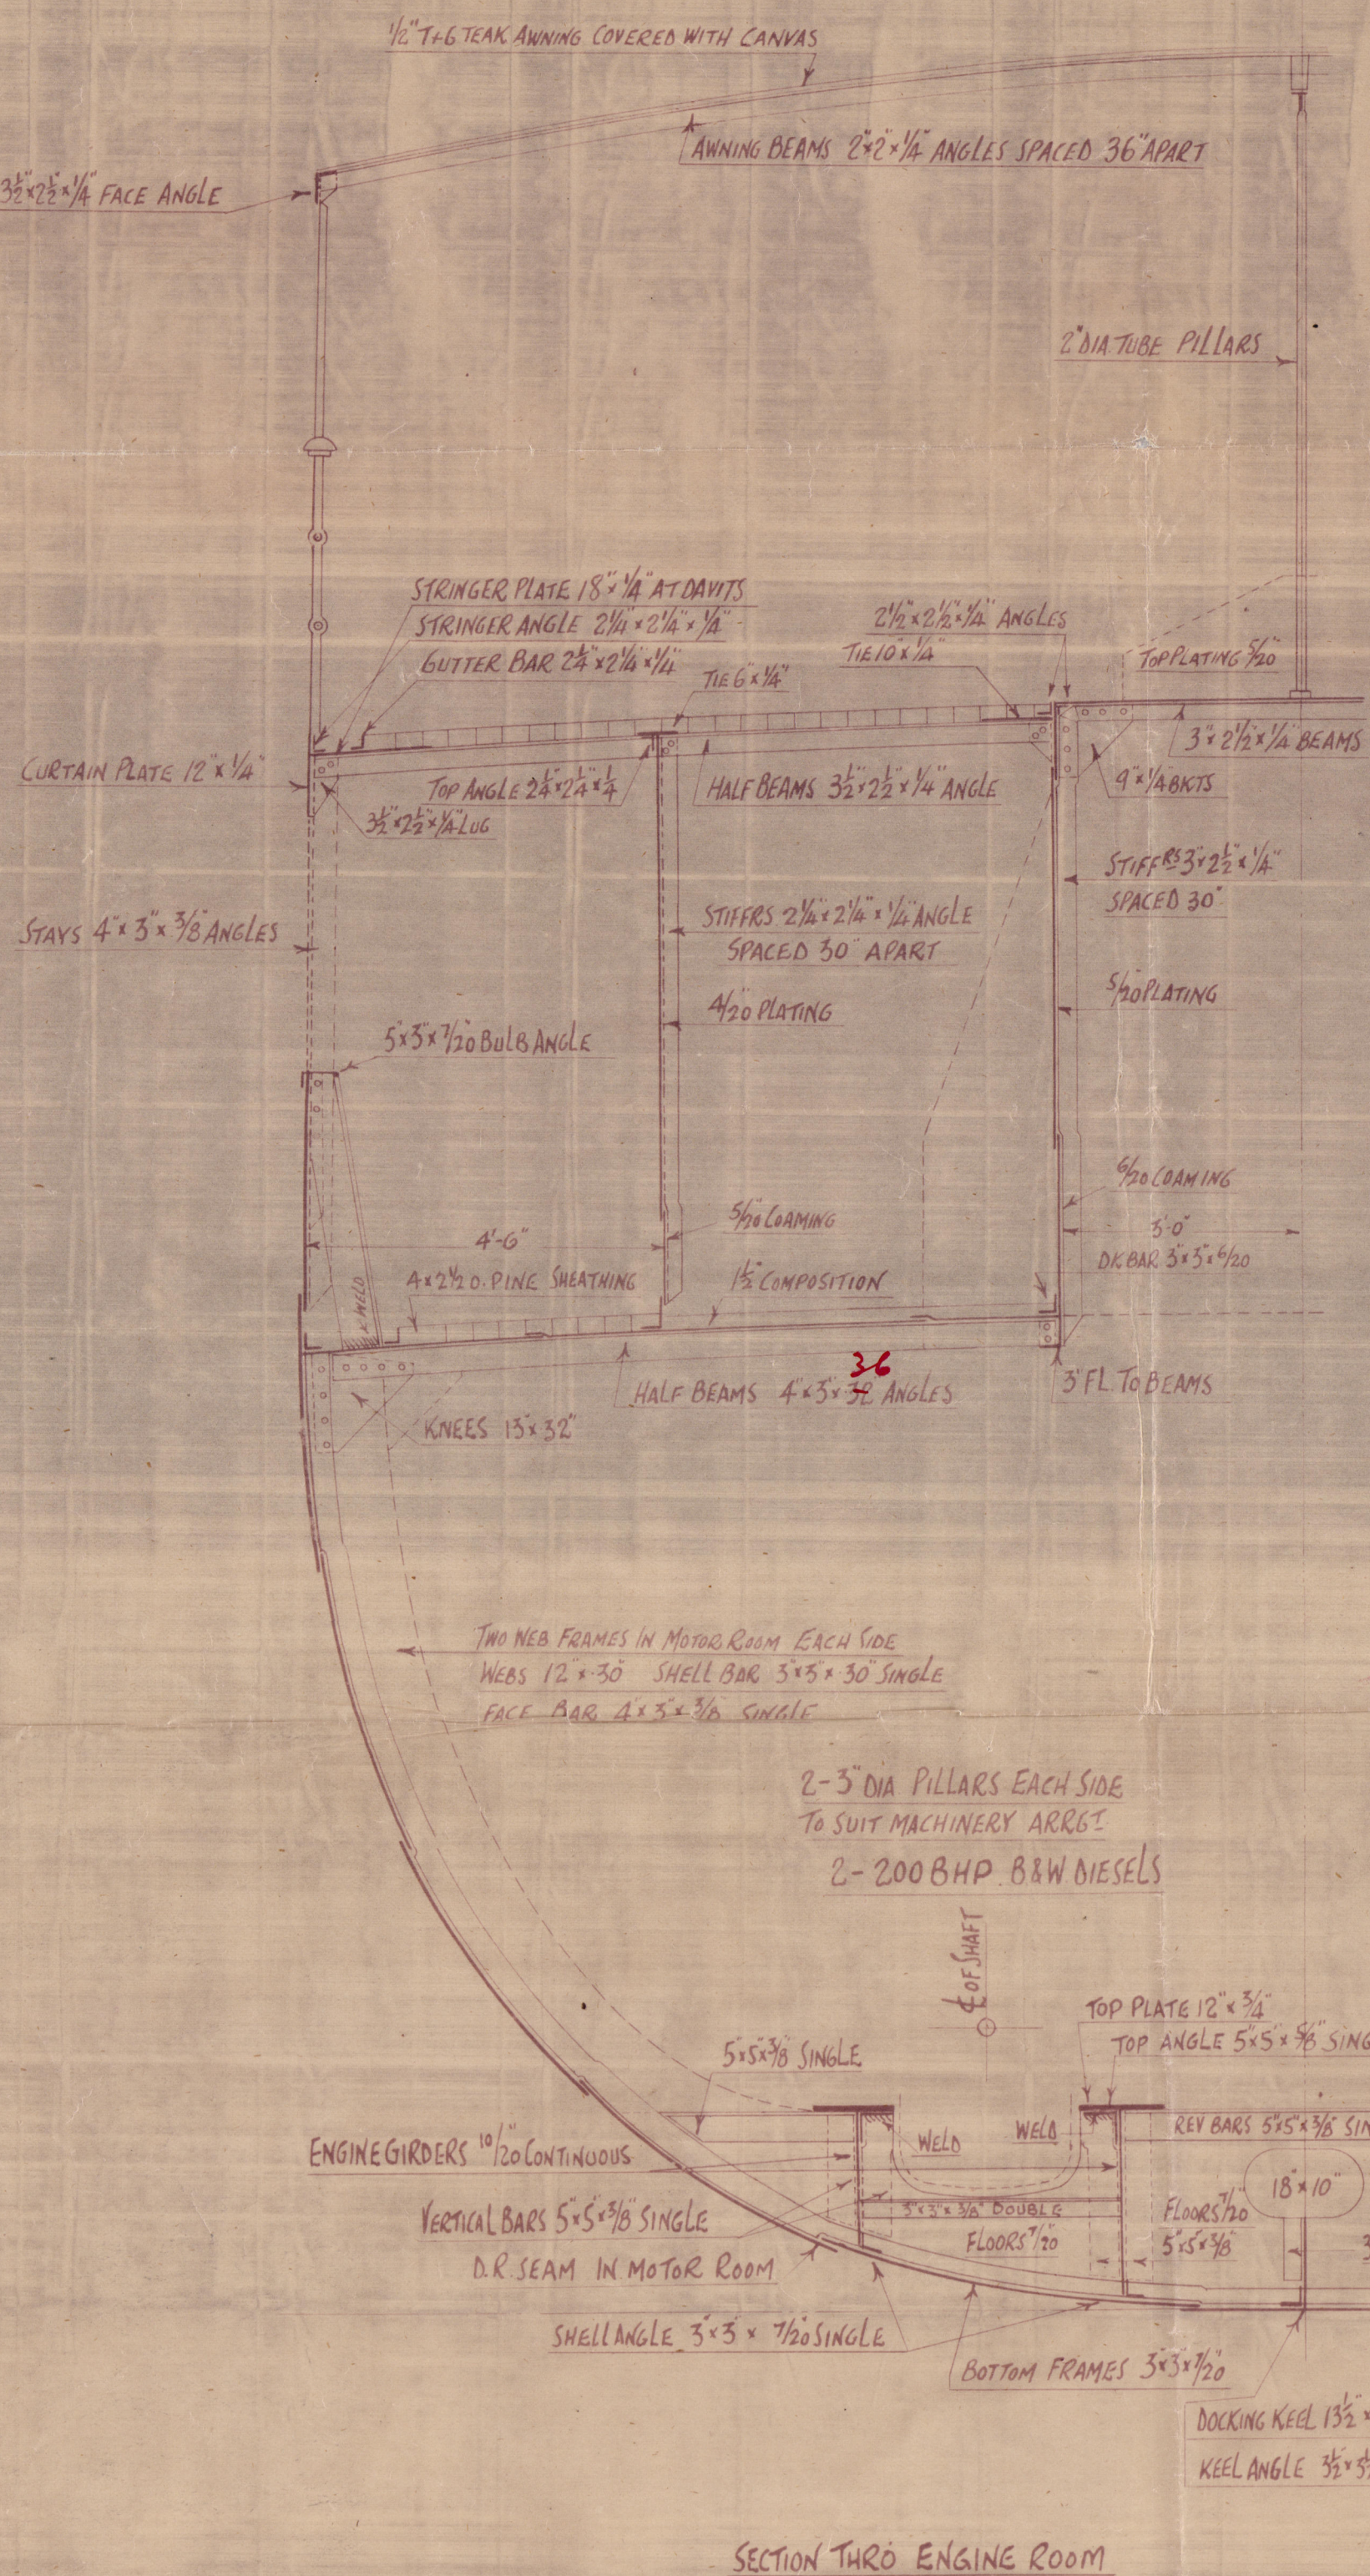

APPROVED

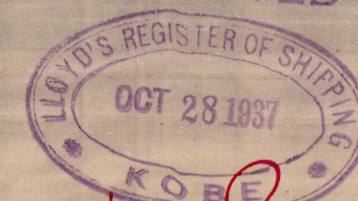

HONG KONG & WHAMPOA DOCK CO. LTD.

HONG KONG & WHAMPOA DOCK CO. LTD.

