


S. S. N<sup>o</sup> 548

1<sup>st</sup> No 37.00      2<sup>nd</sup> No 6105.00

SCALE  $\frac{1}{4}$  INCH = 1 FOOT

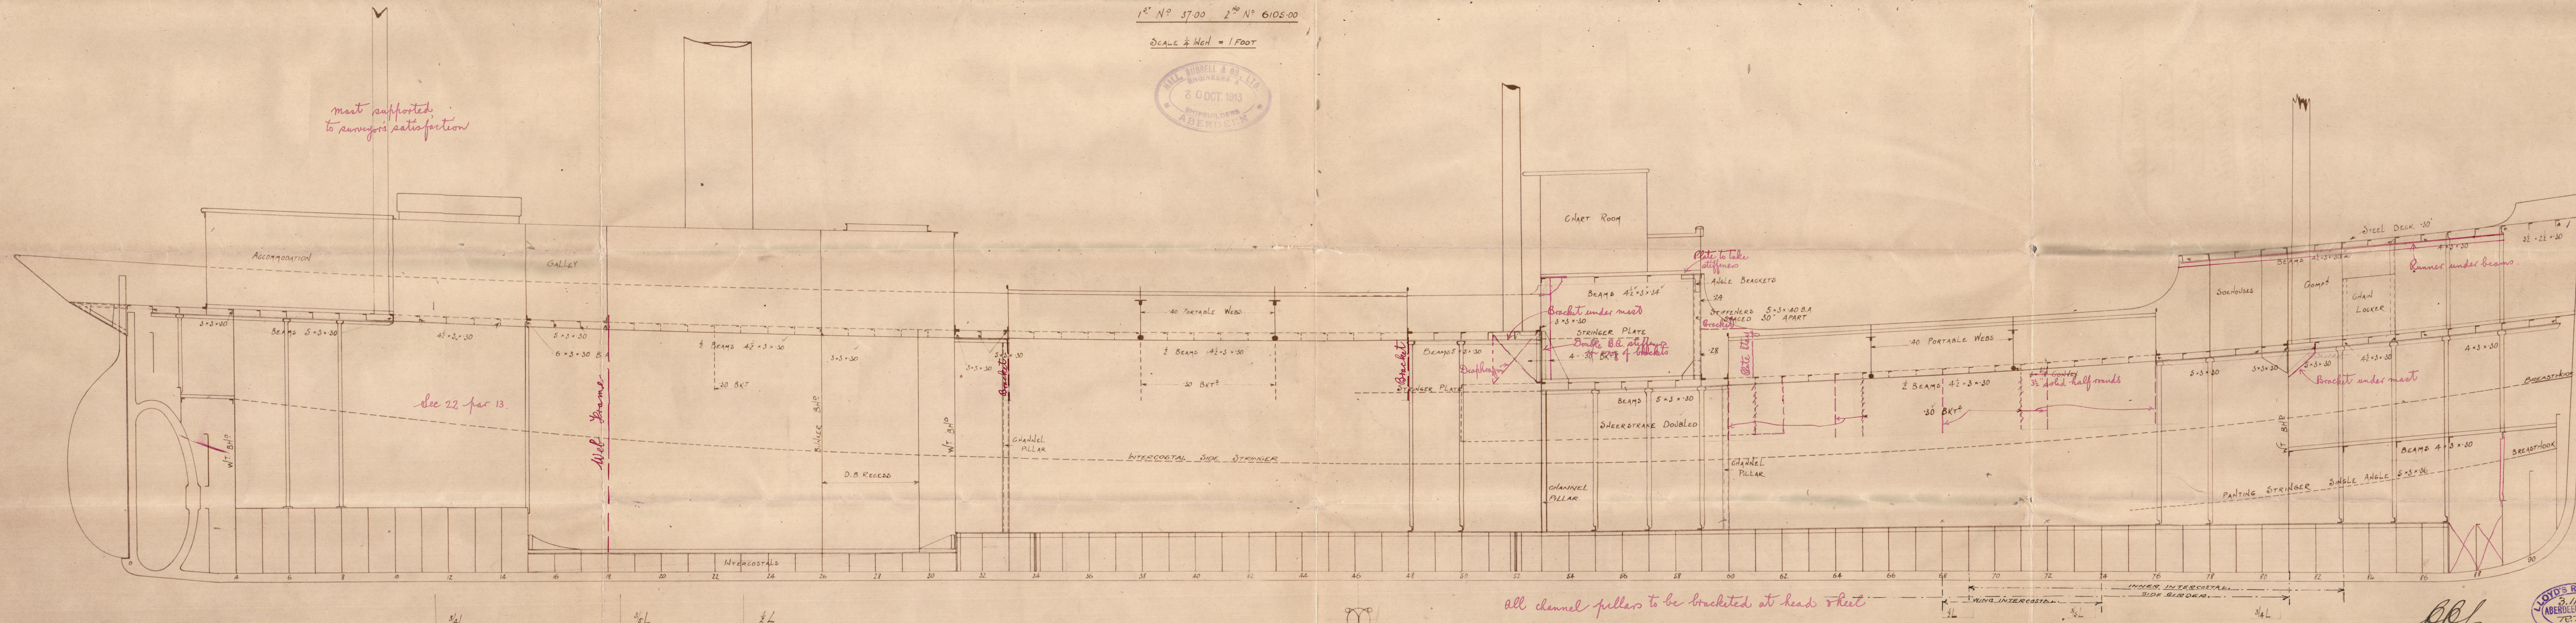


all channel pillars to be bracketed at head sheet

BBf  
11. 11-13.





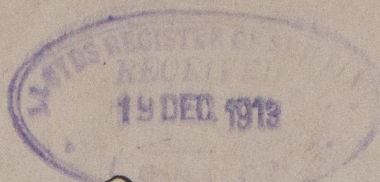

Hall Russell & Co. Ltd.


No 548.

Profile

Duncarrow

ex S.S. "Whinhill"

Abn rept No. 11487.

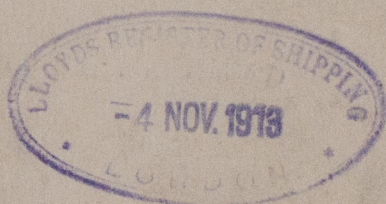

© 2021

Lloyd's Register

W26-0039 Foundation