

S.S. N924

MIDSHIP-SECTION.

SCALE 1/2"=1'-0"

PRINCIPAL DIMENSIONS	
LENGTH BETWEEN P.P.	255'-0"
BREADTH MOULDED	36'-0"
DEPTH	18'-9"
ROUND UP OF BEAMS 9"	
BRIDGE & POOP COMBINED	8'-0" HIGH
FORE CASTLE	8'-0" "
SALOON HOUSE	8'-6" "
SIDE HOUSES & ENG. & B. CASING	7'-3" "

TO CLASS AT LLOYDS REGISTER + 100A.1.

NUMERALS

$$L \times D = 255 \times 18.75 = 4781.25$$

$$L \times (B+D) = 255 \times (36+18.75) = 13961.25$$

$$\frac{L}{D} \text{ TO MAIN DECK } = \frac{255}{18.75} = 13.6$$

$$\frac{L}{D} \text{ TO BRIDGE DECK } = \frac{255}{18.75} = 13.6$$

$$\alpha = 18.9^\circ - 2.9^\circ = 15.9^\circ$$

EQUIPMENT NUMERALS	
$L \times (B+D)$	13961.25
FORE CASTLE	49 x 8 x 3/4 = 294
POOP & BRIDGE COMBINED	165 x 8 x 3/4 = 990
MIDSHIP HOUSE	15.5 x 8.5 x 3/4 = 98.81
SIDE HOUSES & CASING	45 x 7.25 x 1/2 = 163.12
	15507.78

EQUIPMENT	
3 BOWER RICHMOND STOCKLESS	9.4 CWT. COLL. WEIGHT
1 STEAM INCHMOR	8 1/2 CWT. EXCL. STOCK
240 FATHOM	1 1/2" STUD CHAIN CABLE
75 "	4" STEAM STEEL WIRE
90 "	3 1/2" TONLINE "
2 x 90 "	2 1/4" HAWSER "
2 x 90 "	1 3/4" WARP "

TUMBLE HOME 1" ON BRIDGE DECK.

BULLWARK PLATING 1/4" BUTT LAPS SINGLE RIV.

S.R. 2 1/4" RIV. 5/8" SPACED 4D

BRIDGE SIDE PLATING 1/4" FOR 1/2 L TO .38" AT ENDS BUTT LAPS TREBLE RIVETED TO DOUBLE AT ENDS

* S.R. 2 1/2" - 3/4" RIV.

.44" FOR 1/2 L TO .38" AT ENDS BUTT LAPS TREBLE RIVETED TO DOUBLE AT ENDS

* S.R. 2 1/2" - 3/4" RIV.

.44" FOR 1/2 L TO .38" AT ENDS BUTT LAPS TREBLE RIVETED TO DOUBLE AT ENDS RIVETS 3/4" SPACED 3 1/2 D

S.R. 2 1/2" FOR I

RIVETS 3/4" SPACED 4D as Table 40

.44" FOR 1/2 L TO .38" AT ENDS BUTT LAPS TREBLE RIVETED TO DOUBLE AT ENDS RIVETS 3/4" SPACED 3 1/2 D

S.R. 2 1/2" FOR I

RIVETS 3/4" SPACED 4D

NOTE

* DOUBLE FOR FOUR FRAME SPACES AT END OF BRIDGE

S.R. 2 1/2" FOR I

RIVETS 3/4" SPACED 4D

D.R. 4 1/2" FOR I

RIVETS 3/4" SPACED 4D

EXTRA'S AS PER OWNERS REQUIREMENTS

EXPOSED WEATHER DECKS MINIMUM 3/8" THICKNESS INCL. FORECASTLE
2" DECK THROUGH REGION OF BUNKERS .05" THICKNESS
THE WHOLE OF THE STRUCTURE UNDER BOLLERS INCL. INTERC.
FLOORS, REVERSE BARS AND CONNECTING ANGLES .10" THICKNESS
ICE FRAMING: INTERMEDIATE FRAMES 5" x 3" x 3/8" L IN 1/2" HOLD
AND FOREPEAK FROM MAIN DECK BEAM KNEES TO TRUNK BRACKETS
3 TO 4 STRAKES OF SHELL PLATING DOUBLED FOR ABOUT
20 TO 25 FEET AHEAD THE FORE PEAK BULKHEAD
RUDDERHEAD 1/2" MORE THAN REQUIRED BY RULES
TUNNEL TOP PLATING NOT LESS THAN 13" UNDER HATCHES

Plan to be submitted for consideration if notation required

INNER BOTTOM PLATING


MIDDLE LINE STRAKE 4 1/2" x .38" FOR 1/2 L TO .34" AT ENDS
AT ENDS, BUTT LAPS DOUBLE RIVETED 3/4" x 3/8" RIVETS
SPACED 4D. REMAINING STRAKES IN HOLDS .35" FOR 1/2 L TO .31" AT ENDS
BUTT LAPS DOUBLE RIV. FOR 1/2 L, SINGLE AT ENDS RIV. 3/8" RIVETS SPACED 4D
IN ENGINE ROOM .38" IN BOILER SPACE .48" BUTT LAPS TREBLE
1/8" RIVETS

SOLID FLOORS .32" IN B.S. .42"

ON EVERY THIRD FRAME

FLAT PLATE KEEL 4 1/2" x .54"

FOR 1/2 L TO .50" AT ENDS BUTT LAPS TREBLE RIV. 1/8" RIVETS SPACED 3 1/2 D

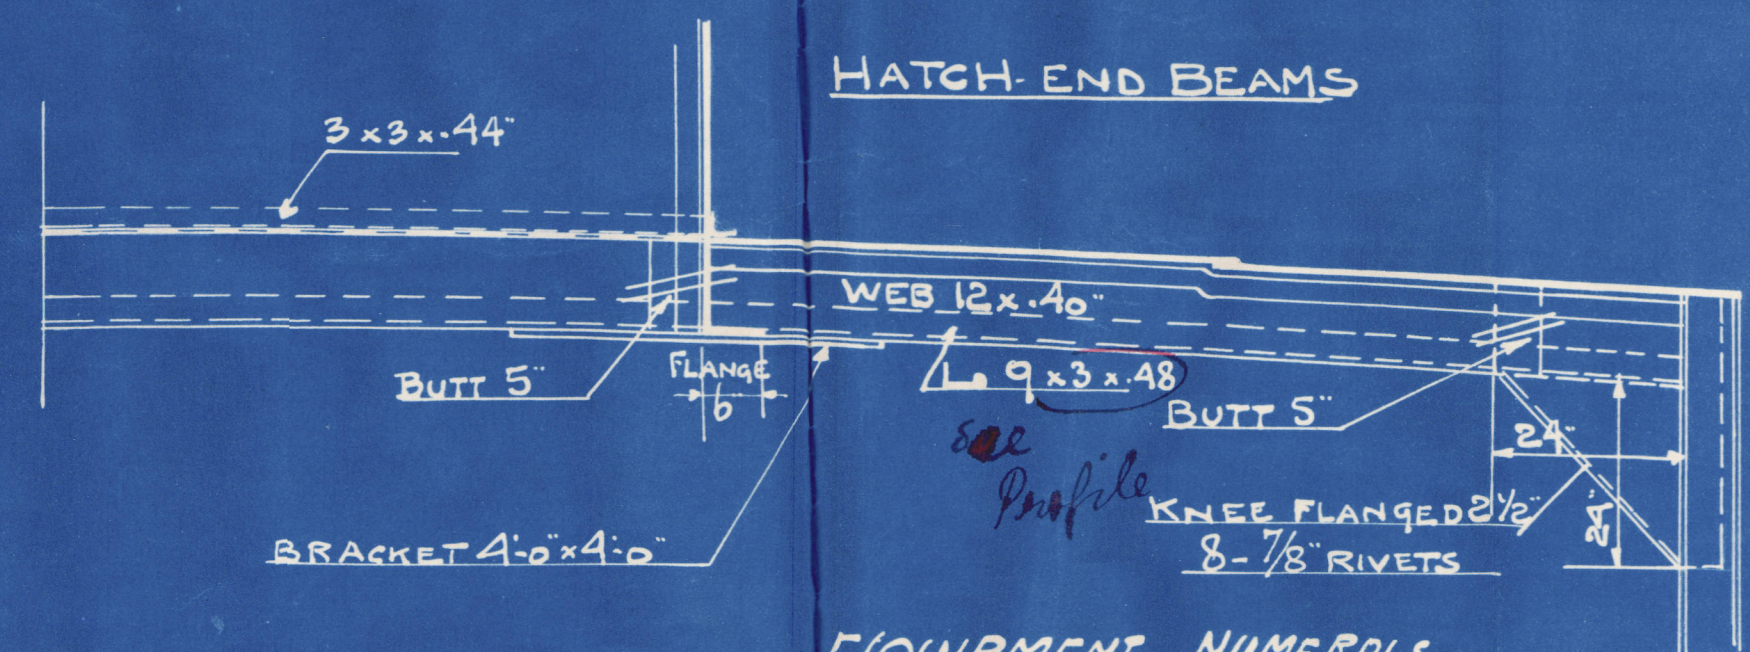

STEM 7 1/4" x 2"
STERNPOST 7 1/2" x 5 1/4"
RUDDERPOST 6 3/4" x 5 1/4"
FRAME SPACES 23 1/2" ALL FORWARD

FORE CASTLE

SIDE PLATING .32"

STRINGER & DECK PLATING .30"

BEAMS 6 1/2" x 3 1/2" x .34"

UPPER DECK STRINGER 6 1/2" x 3 1/2" x .34"

APPROX. BUTT LAPS TREBLE RIVETED TO DOUBLE AT ENDS

18-3/4" RIVETS SPACED 3 1/2 D

5 x 5" x .34" FOR 1/2 L TO .38" AT ENDS

3 x 3" x .34" FOR 1/2 L TO .38" AT ENDS

SPACED 6" IN WAY OF UNSHEATHED DECK

BEAMS 6 1/2" x 3 1/2" x .38" KNEES 10" x .38"

HALF " 1 1/2" x 3 1/2" x .34" " 18" x .38"

FRAMES 7 1/2" x 3 1/2" L + 10" x .38" IN B.S. + 13" x .38"

IN PEAKS 6" x 3" x .32" L

maybe 5 1/2" x 3" x .38"

CONSTRUCTION OF SIDE GIRDER

6 1/2" x 3 1/2" x .34" IN B.S. .44"

2 1/2" x 2 1/2" x .30" IN B.S. .30"

3" x 3" x .30"

MANHOLE 13" x 18"

2 1/2" WHITE PINE

3" x 3" x .40"

MARGIN PLATE 2 1/2" x 3 1/2" IN B.S. .44"

BUTTS DOUBLE RIV. 3/4" RIV. SPACED 4D

BRACKETS 32" IN B.S. .44"

26" LUGS

26" LUGS

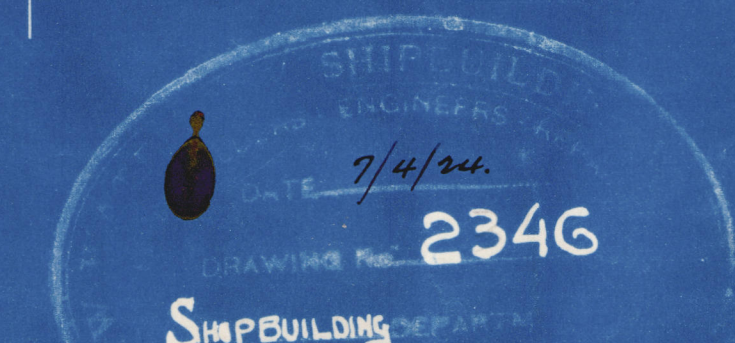

Bottom strengthened forward as per Rules
9/4/24
16/4/24

Messrs. The New Waterway Co
Yard No 124
Midship Section.

Gen Box 227

"Domino"

Ref. 14112



© 2021

Lloyd's Register
Foundation

W26 - 0132