

MIDSHIP SECTION.

— OF A —
SINGLE DECKED SCREW STEAMER.

— DIMENSIONS. —
LENGTH — 390-0
BREADTH M/LP — 53-0
DEPTH M/LP — 26-0

— CLASS 100. A. 1. —
— SCALE 1/2" = ONE FOOT. —


— Anchors & Cables —
Equipment N° 33011-78
✓ 1st Bow Blockless 60 cuts
✓ 2nd do do do 60 do
✓ 3rd do do do 50 do
✓ Stream ex Block 16 do
✓ Kedge do do 7 do
✓ 270 fathoms Stud chain Cable 2 3/4
✓ 40 do do Stream chain 1 1/4 or 4 1/2 Steel Wire

— Hawser & Warps —
✓ 120 fathoms Trawl line 3/4 or 4 1/2 Steel Wire
✓ 2-40 do do Hawser 3
✓ 2-40 do do Warp 7

✓ Poop Side plating .38
✓ Stringer plate 3/4 x 3/4
✓ Angle 3 1/2 x 3 1/2 x 3/4
✓ Deck plating .26 Steel
✓ Cle Side plating .40
✓ Stringer plate 3/4 x 3/4
✓ Angle 3 1/2 x 3 1/2 x 3/4
✓ Deck plating .25 Steel, Wood Sheathed 5 x 1 1/2 PP
✓ Butts of Poop & Cle side plating
✓ overlapped & double riveted, Beams single riveted.


— Lloyd's Numerals. —
Breadth Mid — 53.00
Depth M/LP — 26.00
Transverse N° 79.00
390
Longitudinal N° 30810.0
Depths to Length 15.00 Main Deck
Do 11.47 Bridge Deck.

14.4.15
22.5.15 (193)
5.7.15
8.2.16 (194)
28.6.16
6.8.16

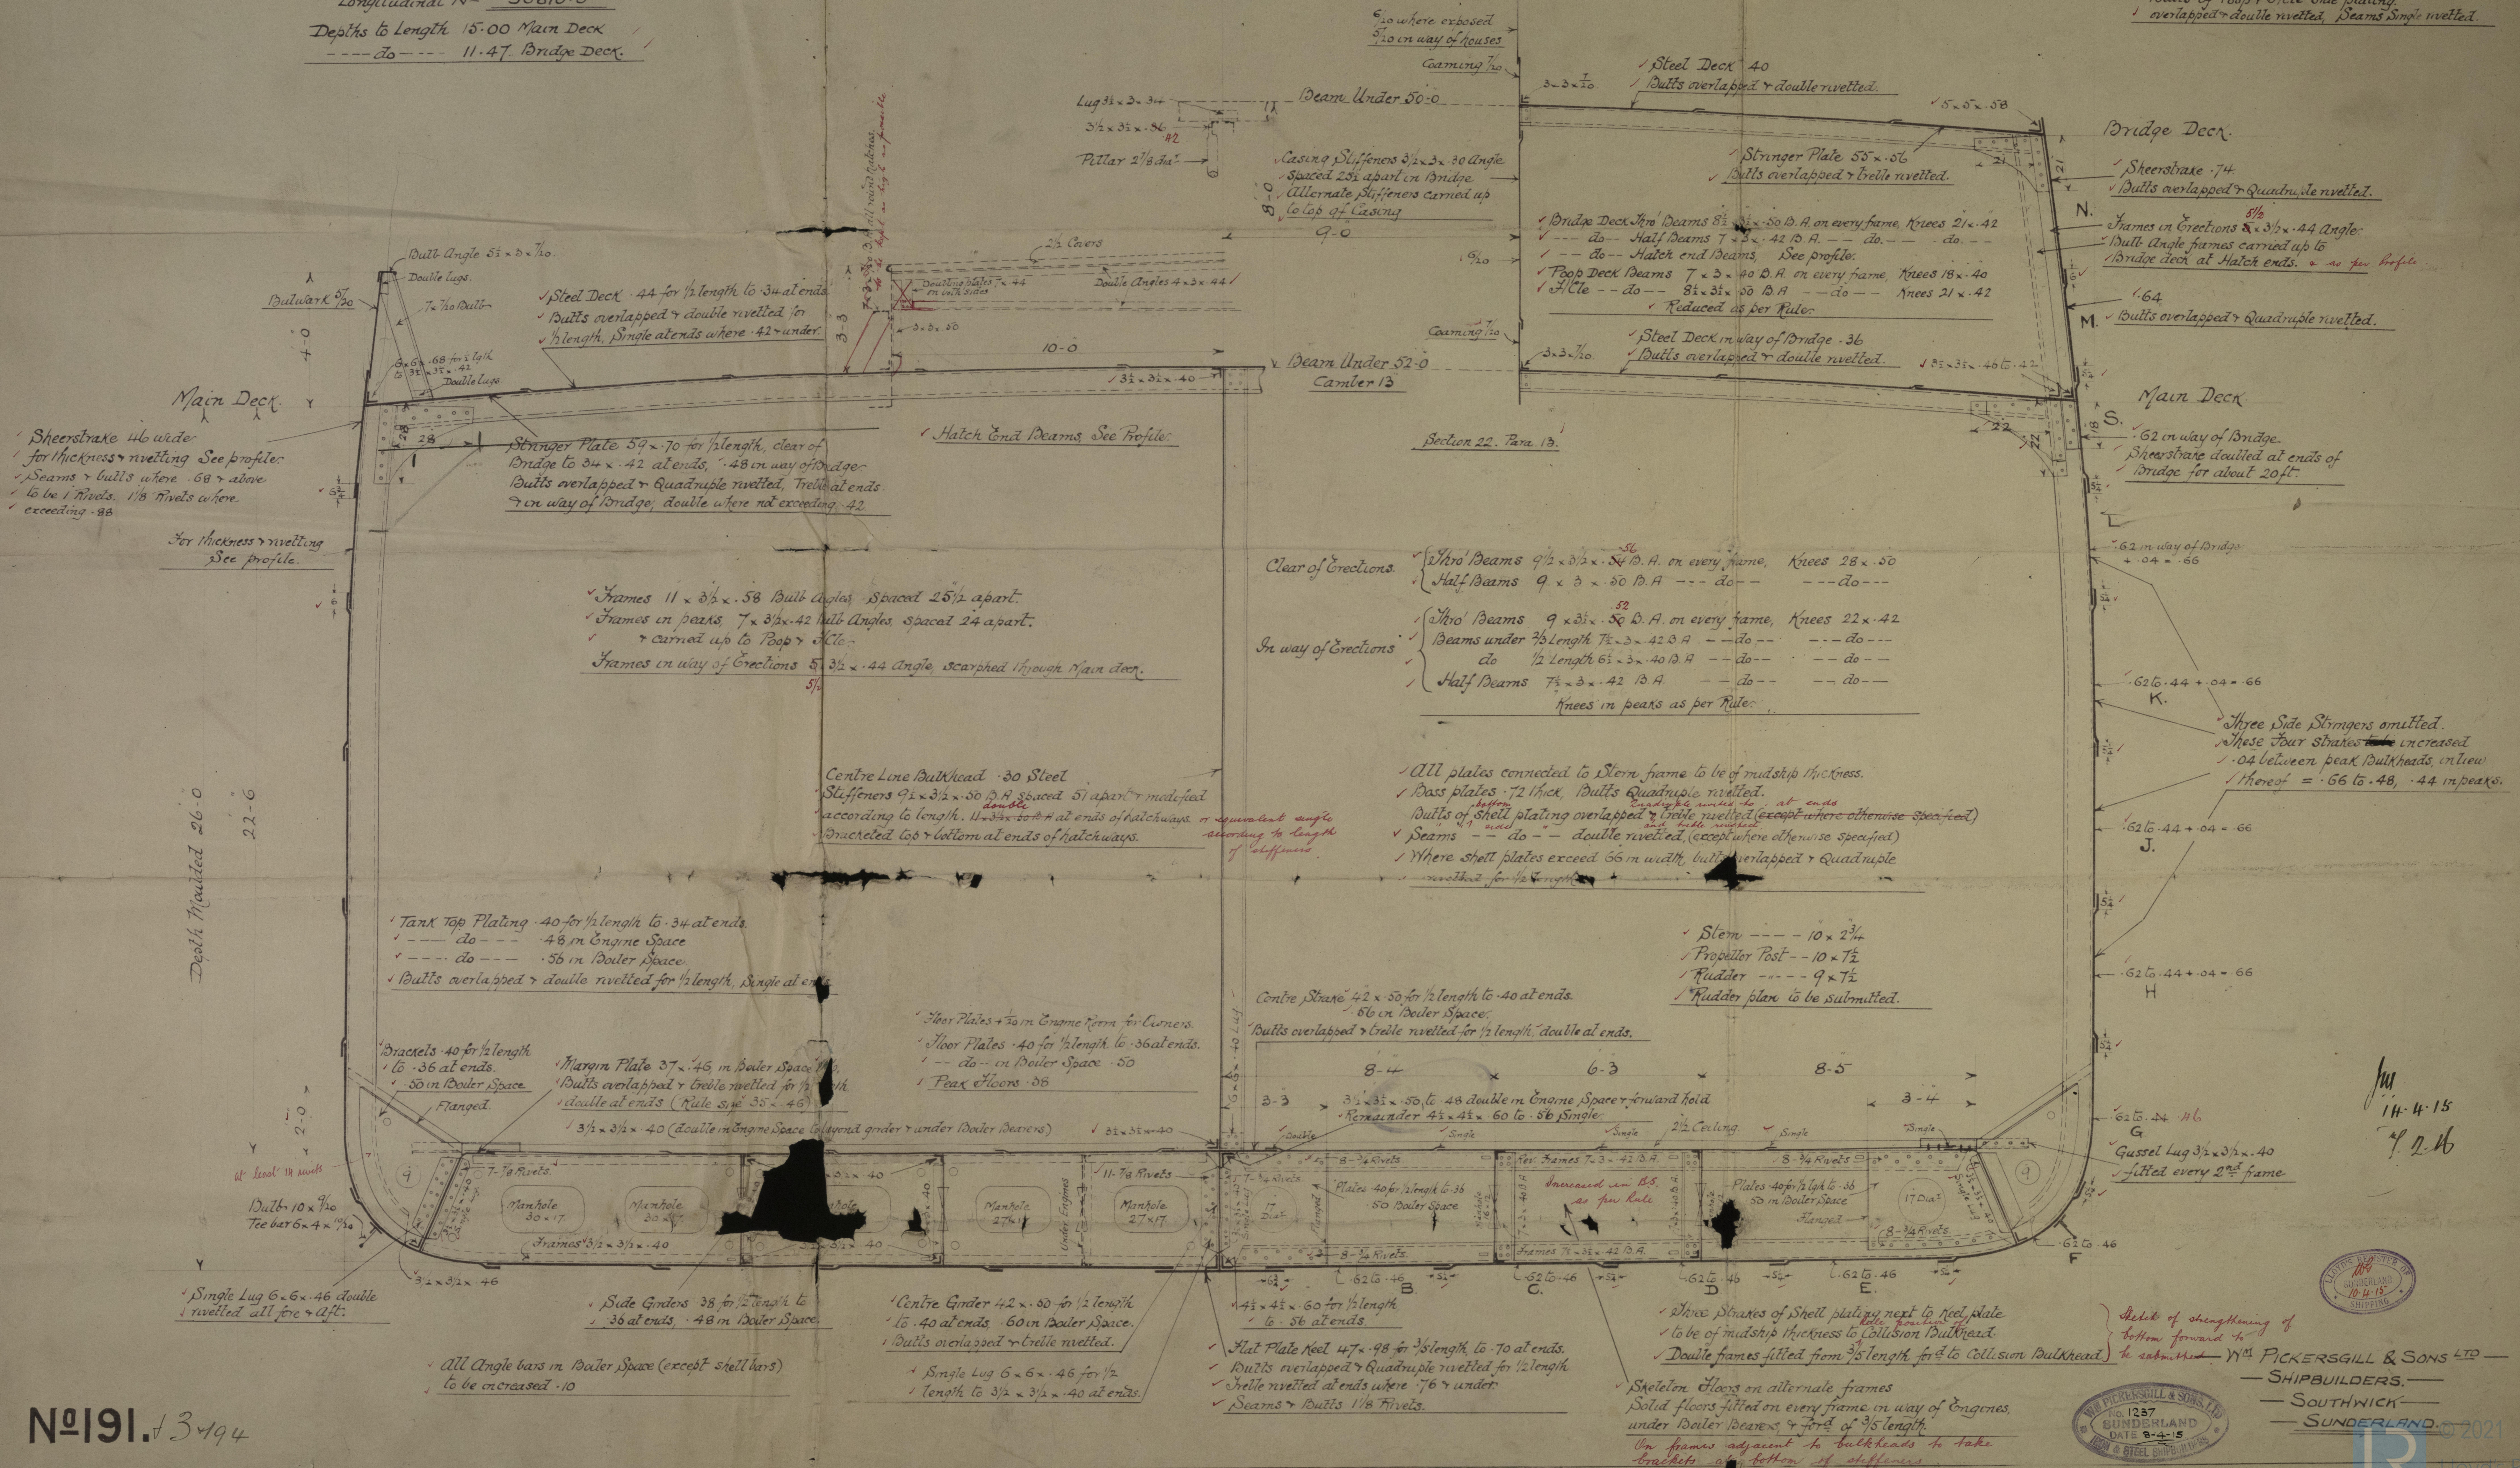

N° 191. 13/194

14.4.15
9.2.16

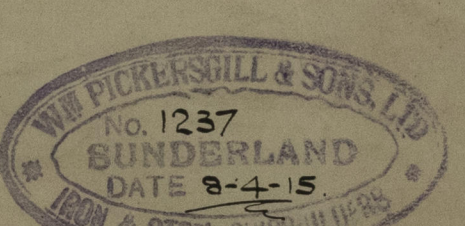




PICKERSGILLS N^o 191 + 3

Dorphys MIDSHIP SECTION 194

191. S.S. SWINDON SLD RPT N^o 26966







193. *Llanove*

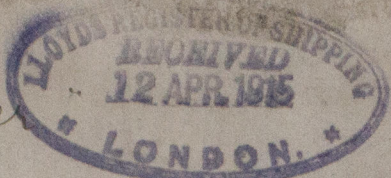

SUNDERLAND RPT. NO. 26974



194. S.S. OAKMORE
SLD. RPT N^o 27116

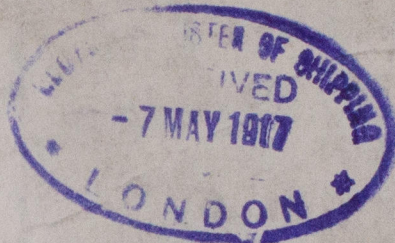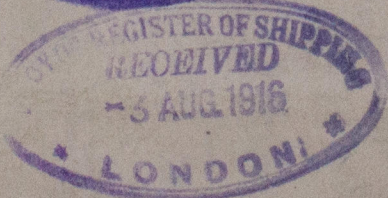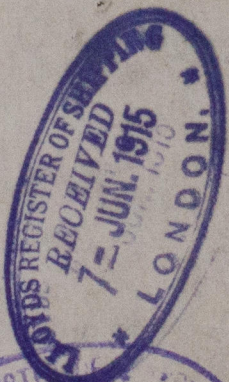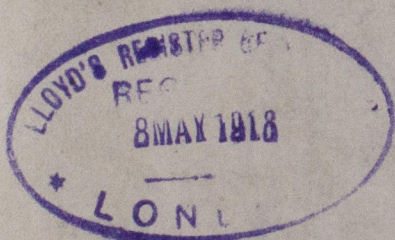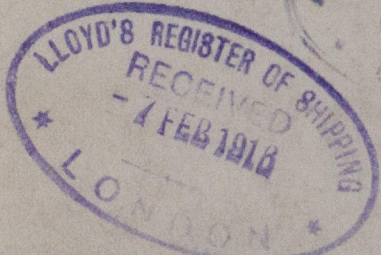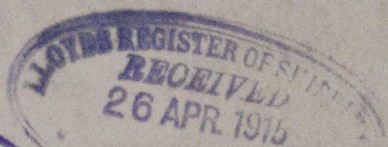

W26-0171

W26-0171



© 2021

Lloyd's Register
Foundation