




South America -

New Bulkheads.

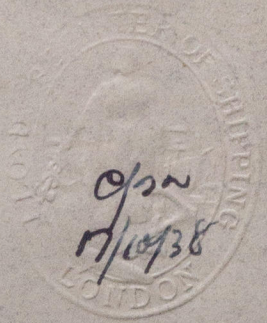

$$\frac{1}{4} = 1'-0"$$

NB! (The new Bulkheads similar present bulkheads.)

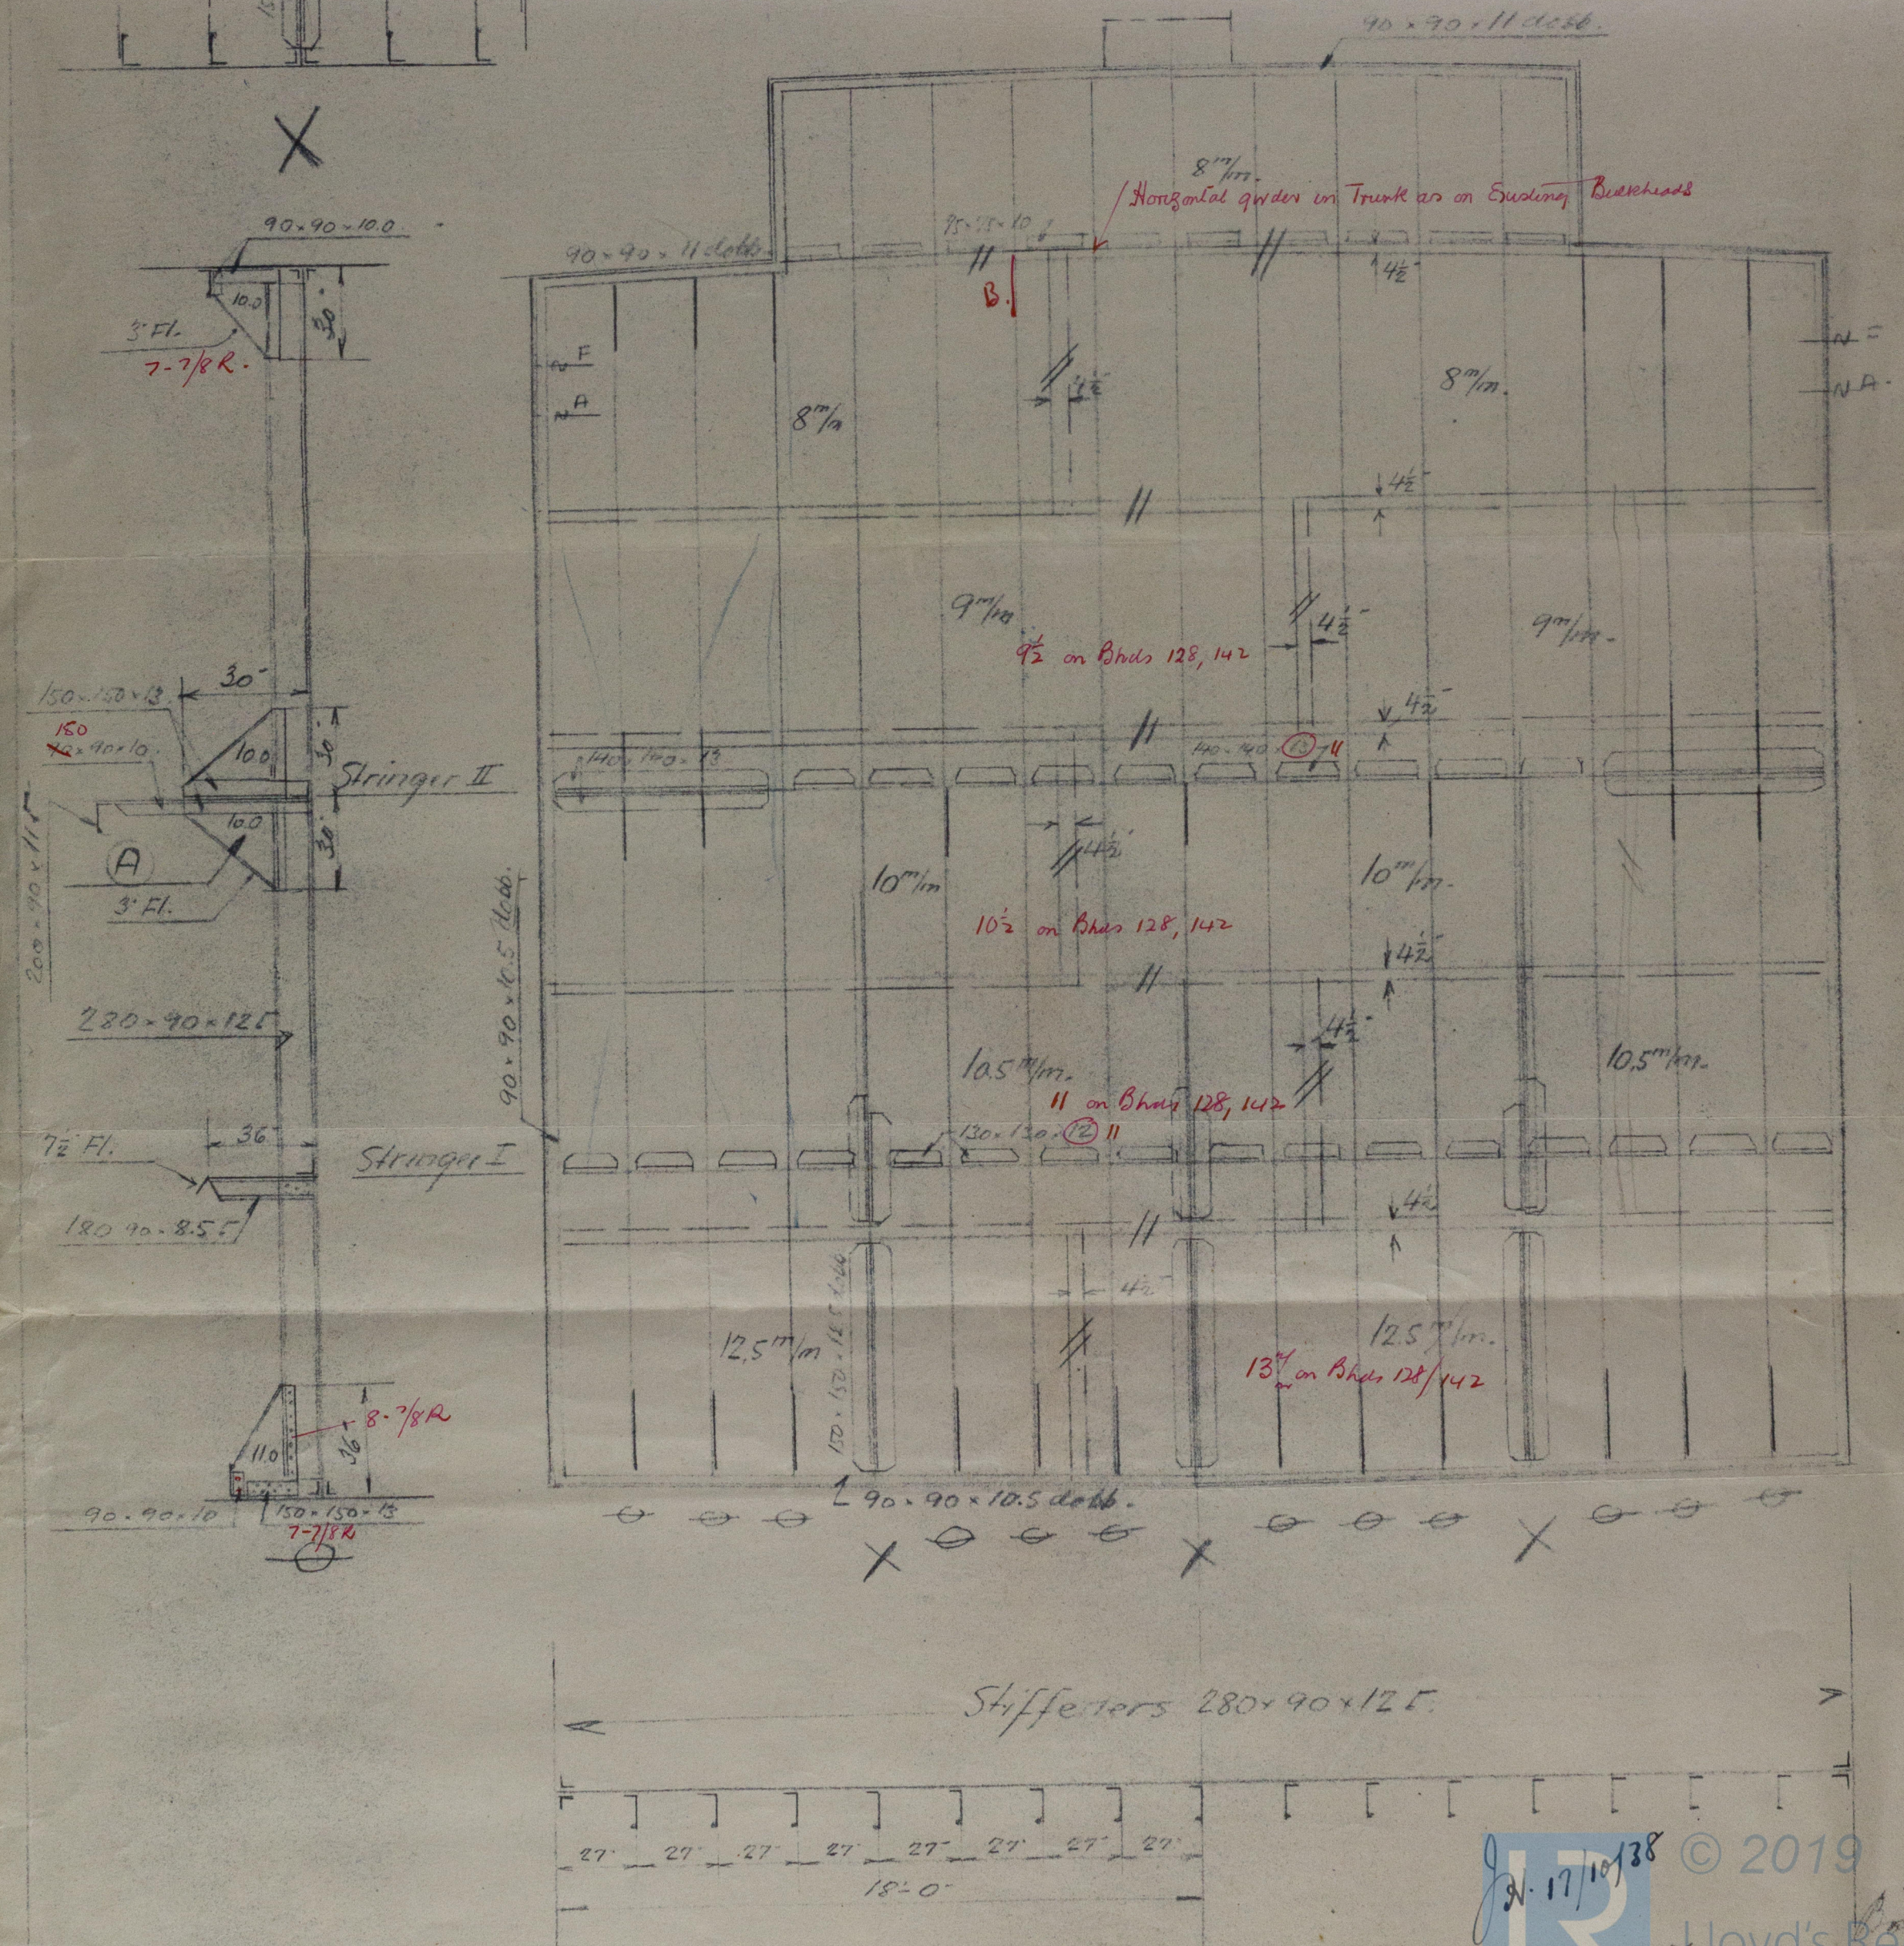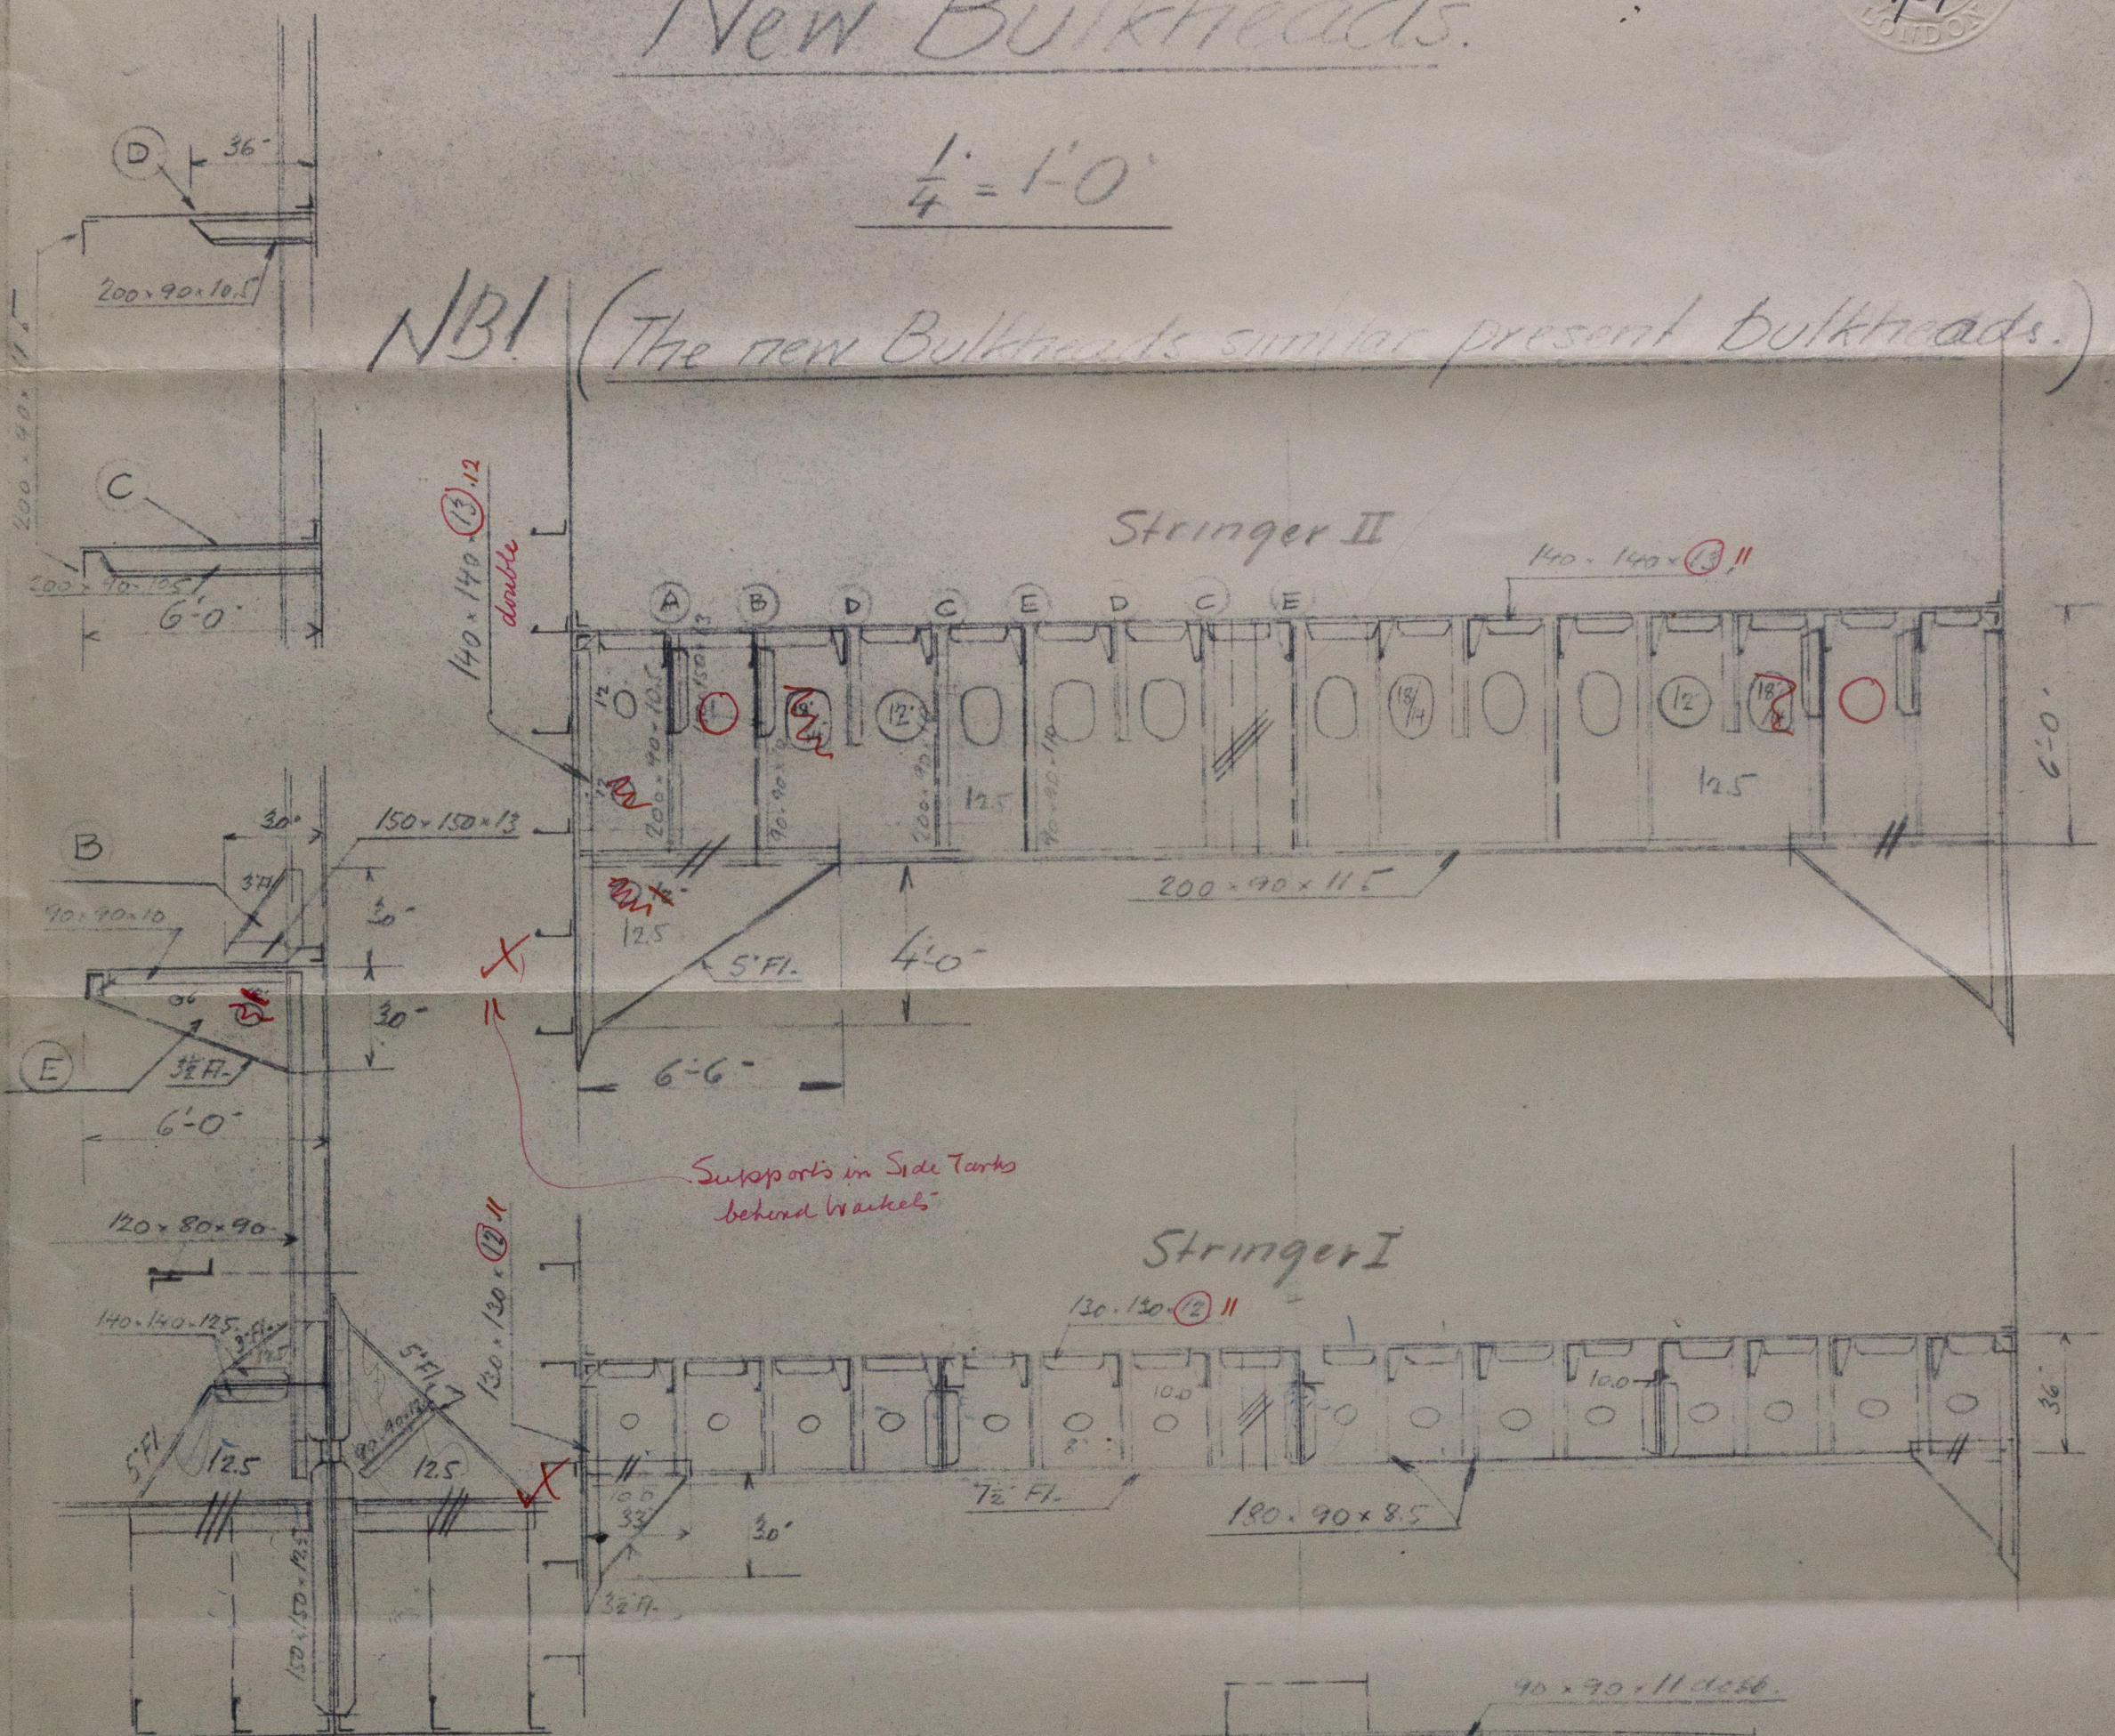

W261-0016

"South America"

Cpn Rpt 10831

New Bulkheads



W261 - 0016



© 2019

Lloyd's Register
Foundation