

S.S. N°497.

LENGTH B.P. 379'-6". BREADTH EXT. 53'-0". DEPTH M-D 25'-4".


SCALE $\frac{1}{8}$ " = 1 FOOT.

Shelter deck plating of steel (thickness = 6 iron)

Shelter OK (steel of iron thickness)


SHELTER DECK BUTTS DOUBLE RIVETED FOR $\frac{1}{2}L$
SINGLE RIVETED AT ENDS WHERE PLATING .42" AND UNDER.

PLAN OF SHELTER DECK.

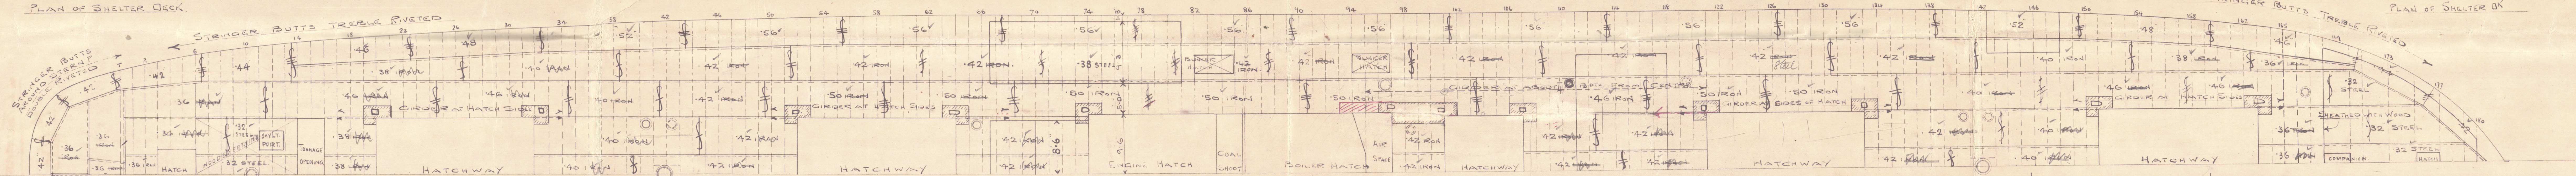

POSITIONS OF BUTTS ARE APPROXIMATE ONLY.

PLAN OF 2ND DECK.

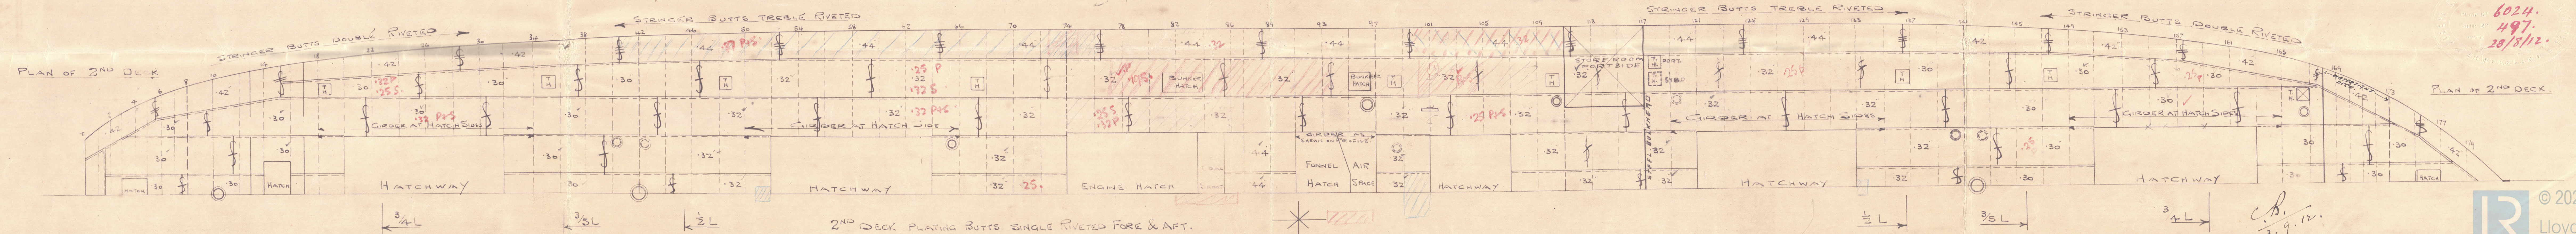

2ND DECK PLATING BUTTS SINGLE RIVETED FORE & AFT.

6024.
497.
28/8/12.

SUNDERLAND

DECK PLANS

J. L. THOMPSON & SONS LTD

YARD No 497

"VINLAKÉ" EX. GOSKUS

EX

NORTH PACIFIC

SLD. RPT. 25689



© 2021

Lloyd's Register
Foundation

W268-0131