

7/9/17

S.S. N° 699.


PROFILE & DECK PLANS.

LENGTH B.P. 405'-0" BREADTH MLD. 53'-3" DEPTH MLD. 29'-5" (UPPER DECK)

SCALE 1" = 1' FOOT


POOP 25'-5"
BRIDGE 226'-5"
FOOT 41'-0"

73.9% ERECTIONS

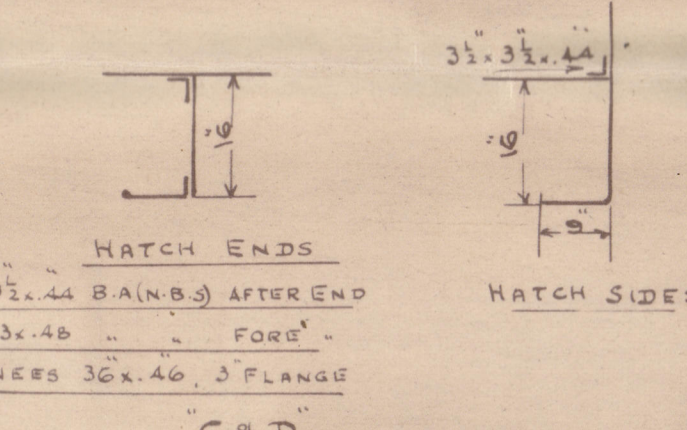




Additional strengthening under windlass, anchors, steam gear, masts, etc., to survivors satisfaction.

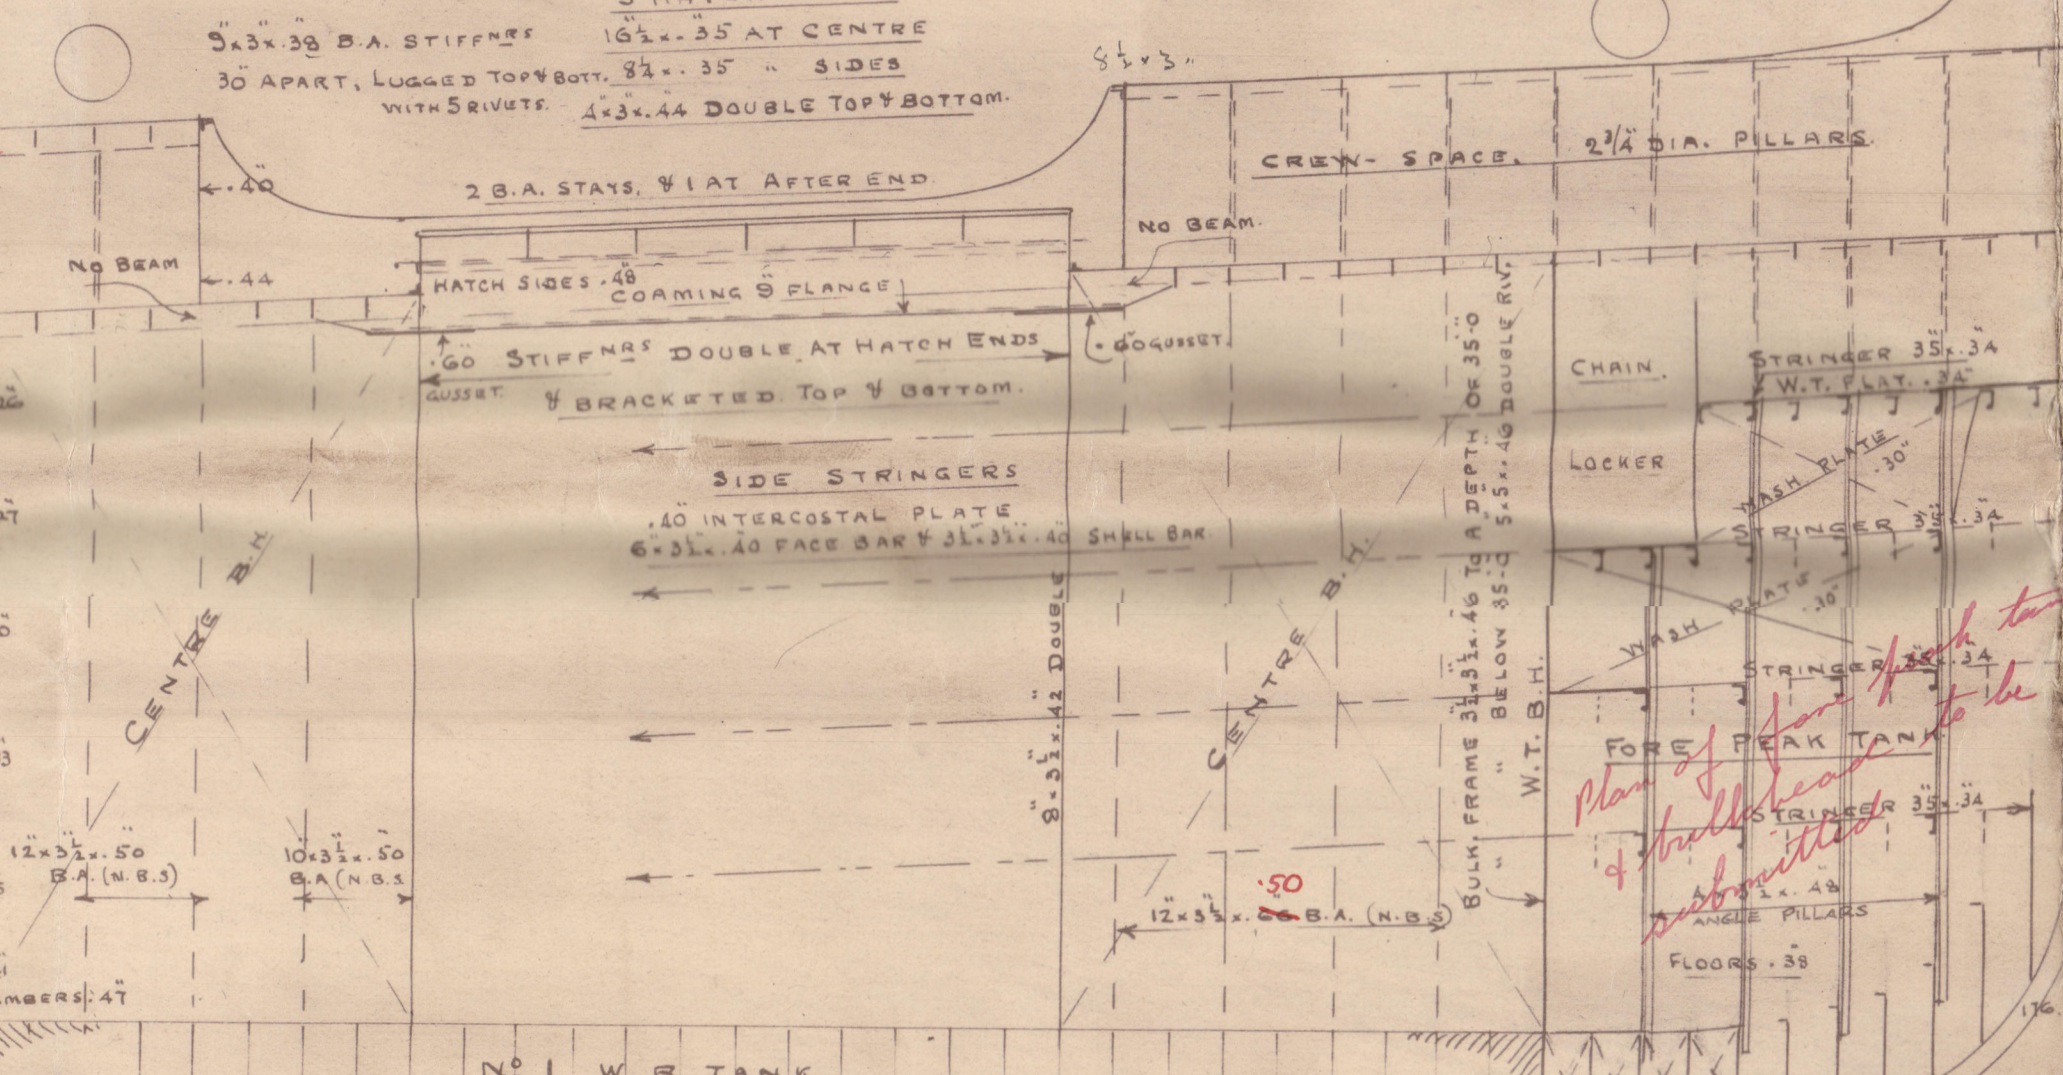





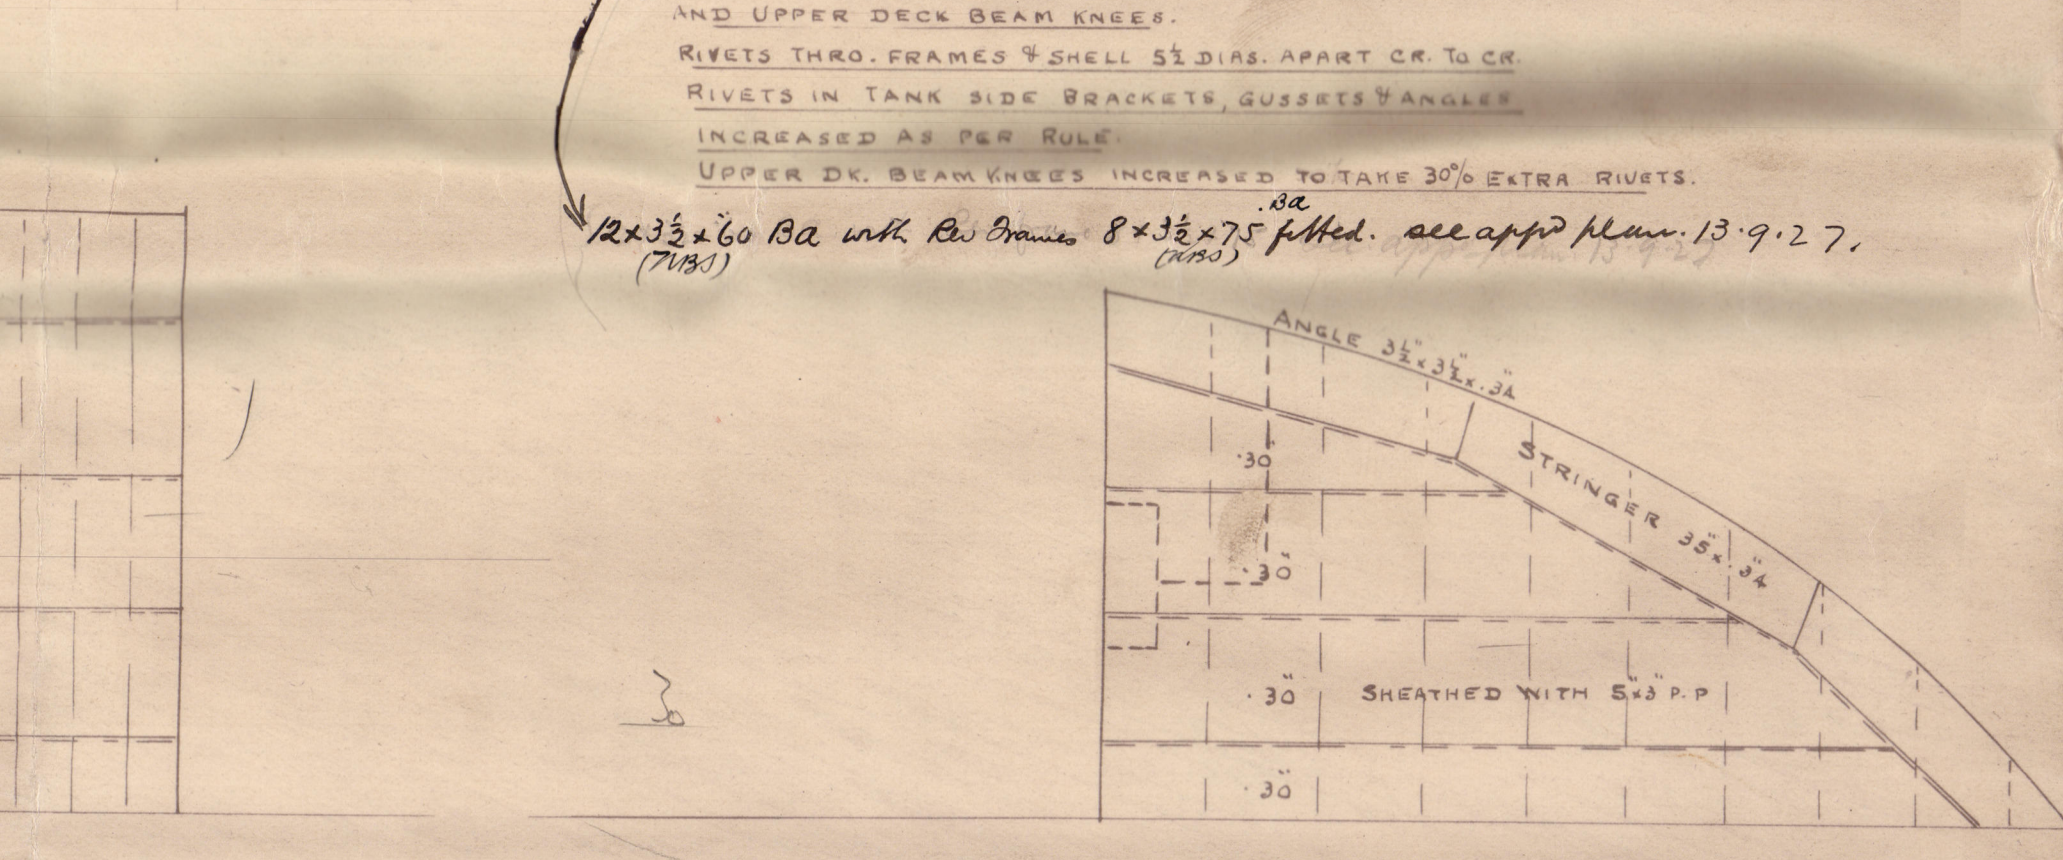


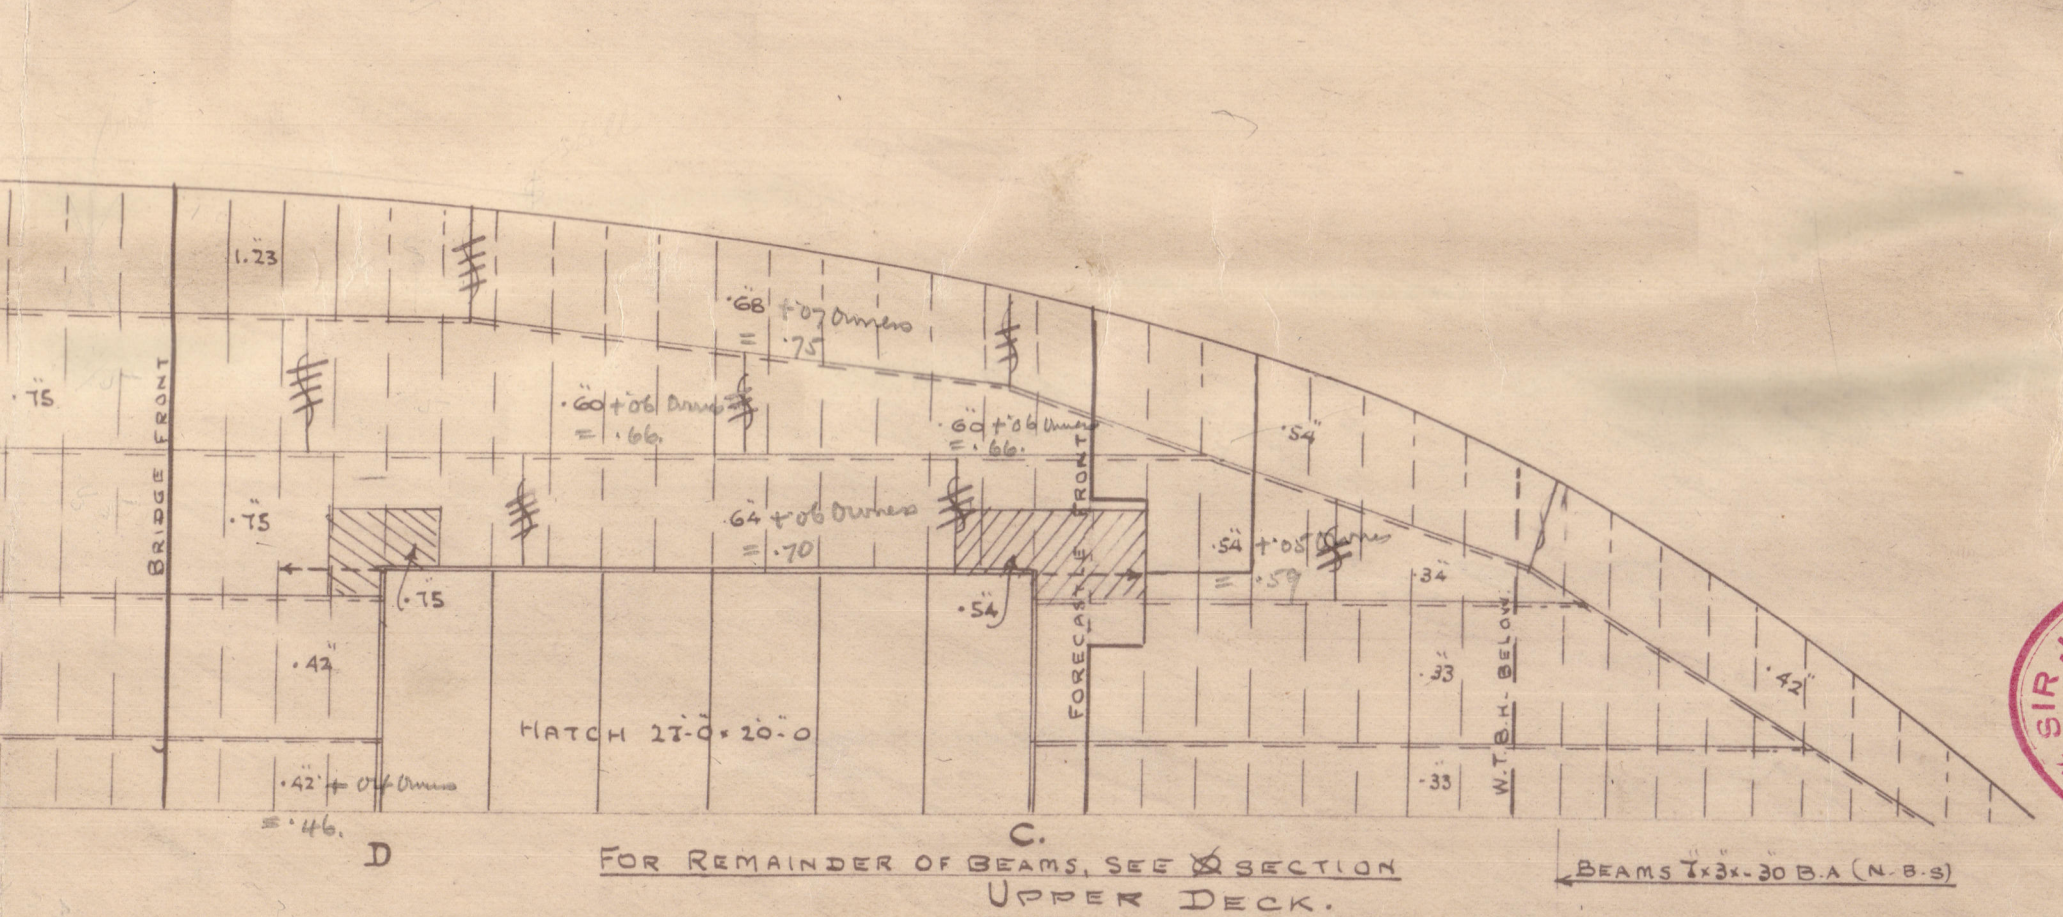


   


IR JAMES LAING & SONS LIMITED
DRAWING OFFICE
No. 1055
27.9.17

SUNDERLAND

SIR JAS LAING & SONS L^{td}

N^o 699

PROFILE AND DECK PLAN



S.S. KIRKPOOL

LLOYD'S REG. OF SHIP. NO.

29760

W275-0094



© 2020

Lloyd's Register
Foundation