


13-19
25.3.19

S.S. N° 220
MIDSHIP SECTION
Length B.P. 270.0 B.M. 39.11 19.4 Mtd.
CLASS 100 A.L. Lloyds
Scale 1/2" = 1 foot.

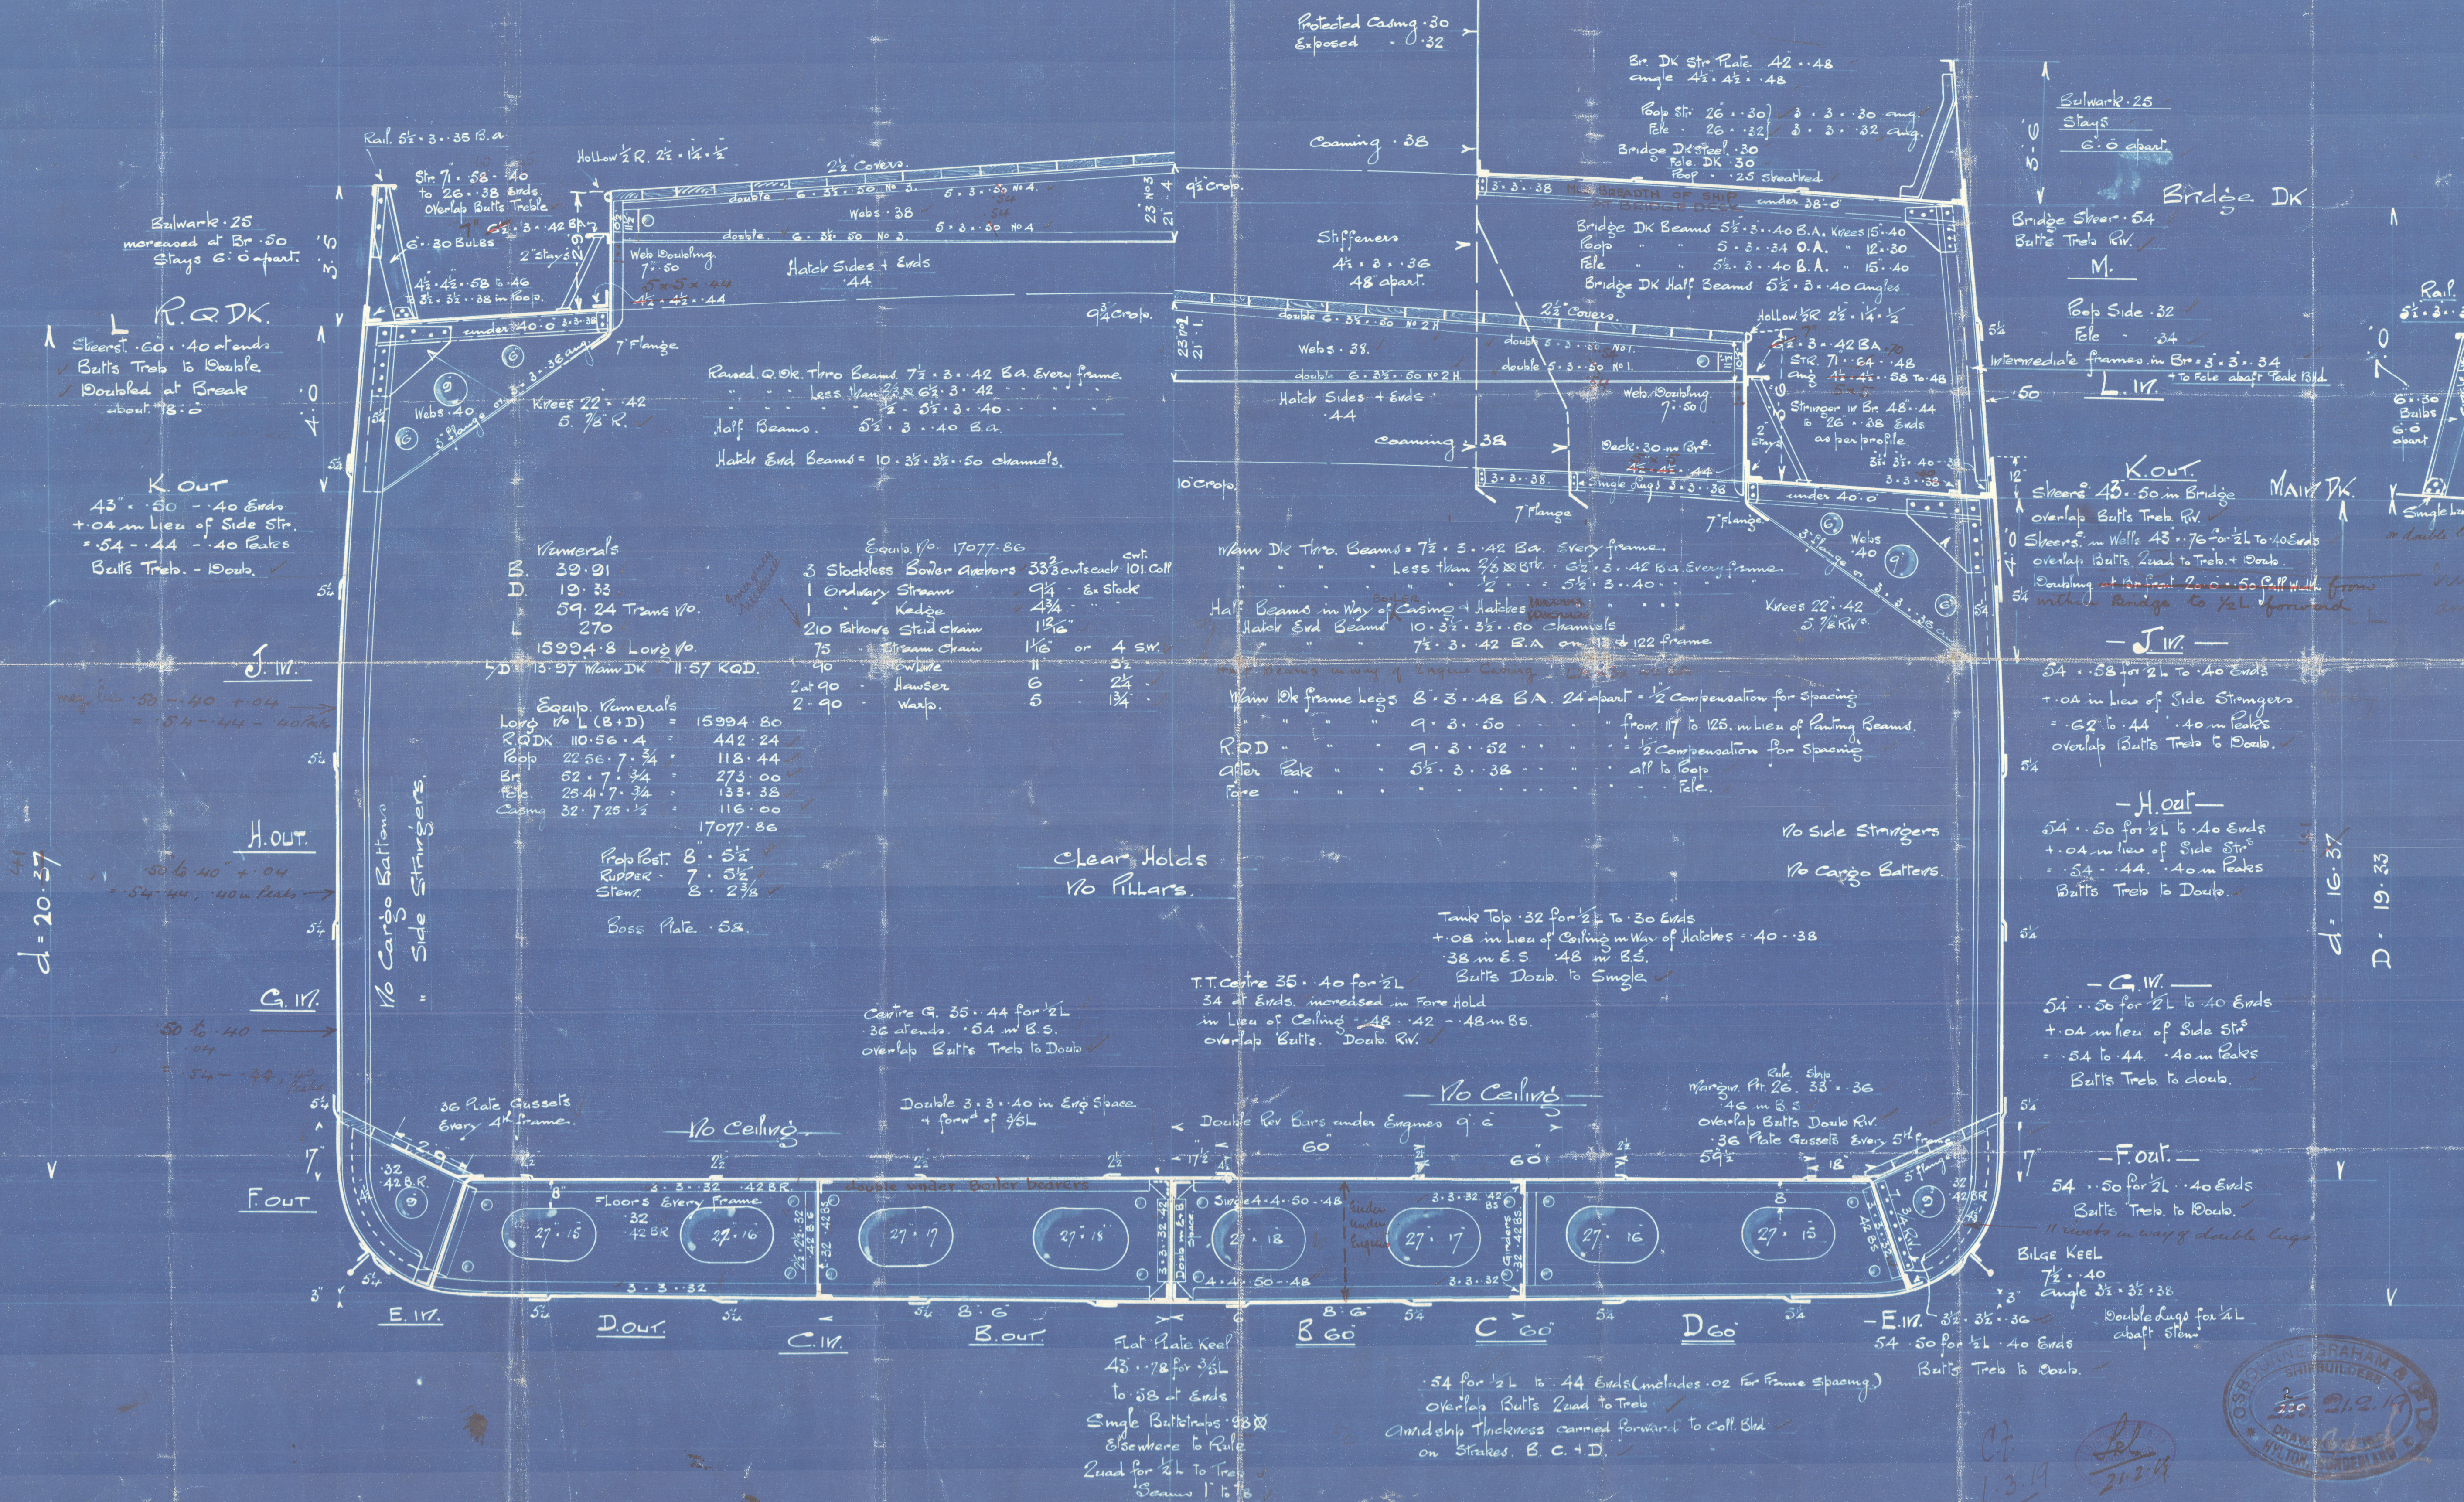

SUNDERLAND

Messrs OSBOURNE, GRAHAM & CO. LTD.

AMENDED MIDSHIP SECTION

No. 220

S.S. "LOLWORTH"

SUNDERLAND RPT. No. 27785

OSBOURNE, GRAHAM & CO. LTD.,
MYLTON,
SUNDERLAND

OSBOURNE, GRAHAM & CO. LTD.,
MYLTON,
SUNDERLAND

W285-0075



© 2021

Lloyd's Register
Foundation