

T. S. S. "ANTONIA"

STRUCTURAL PROFILE. [AS FITTED.]

SCALE $\frac{1}{8}$ INCH = ONE FOOT.

CLASS LLOYDS 100 A1. SHELTER DECK WITH FREEBOARD SPECIAL SURVEY.


DIMENSIONS.

LENGTH B.P. 519'-0"
BREADTH MLD. 65'-0"
DEPTH MLD. 43'-0" TO C DECK (SHELTER DECK)




BOAT DECK BEAMS - FITTED ON EVERY FRAME. FRAMES 59, 60, 71, 72, 85, 86, 91, 93, 104, 105, 107, 118, 121, 122, 123,1000.



DETAILS OF DECK GIRDERS.

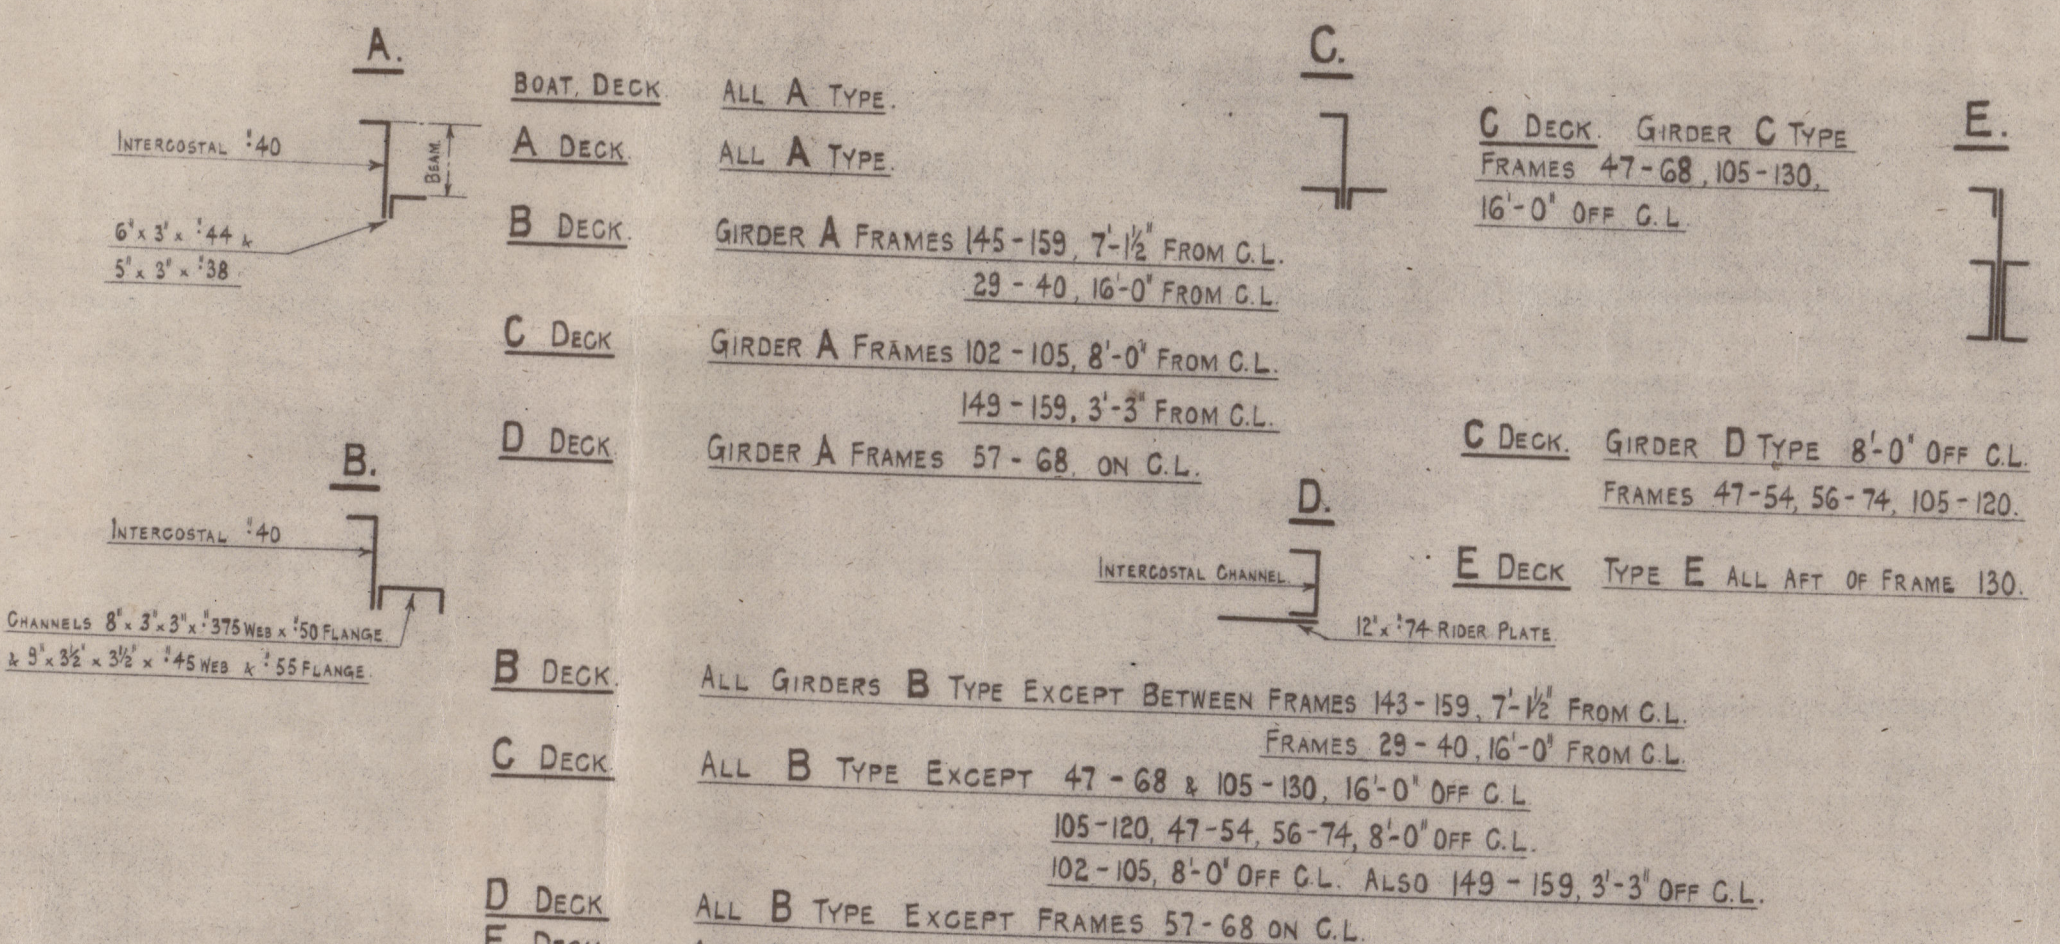

WIDE SPACED PILLARS IN HOLDS.

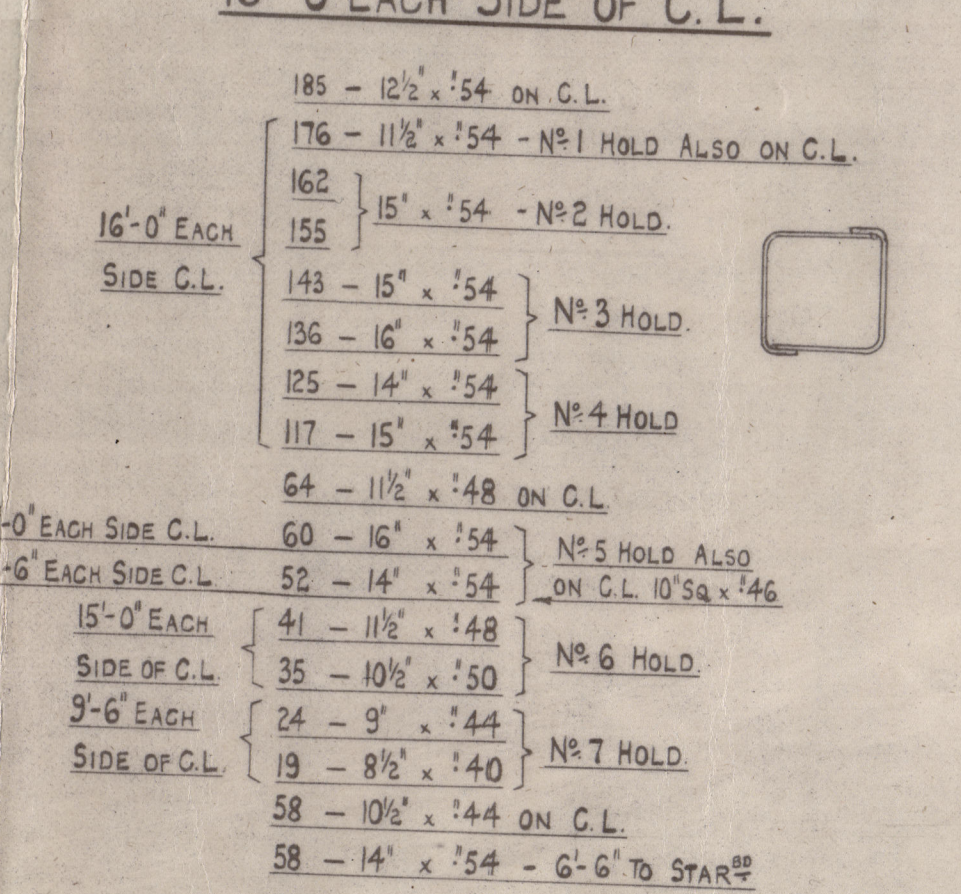

PILLARS IN TUNNEL SPACE FRAME 24.

 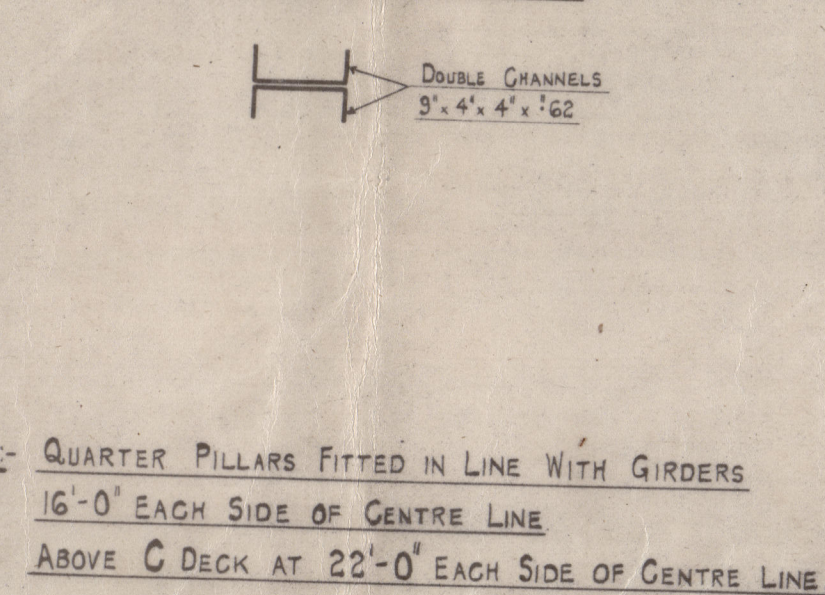

Vickers Ltd

No. 498

Profile (as built)

S.S. Antonia

Barron 1st Embay

Report No. 1957.



© 2021

Lloyd's Register
Foundation

W293-0019