

Log  
Blot  
9/5/19

# TWIN SCREW PASSENGER & CARGO STEAMER.

495  
N<sup>o</sup> 498.

## MIDSHIP SECTION.

SCALE 1/2 INCH = ONE FOOT.

LLOYDS CLASS 100 A1. SHELTER DECK. SPECIAL SURVEY.




DIMENSIONS.

LENGTH B.P. 519'-0"  
BREADTH MLD. 65'-0"  
DEPTH MLD. TO 'C' (SHELTER DECK) 43'-0"

LLOYDS NUMERALS & PROPORTIONS.

BREADTH MOULDED 65.0  
DEPTH MOULDED TO SHELTER DECK 43.0  
1<sup>st</sup> NUMERAL 65.0 + (43.0 - 8) = 100.0  
2<sup>nd</sup> NUMERAL 100 x 519.0 = 51900  
1/10 TO 'B' DECK 519.0 ÷ 51.25 = 10.12  
1/10 TO 'C' DECK 519.0 ÷ 43.00 = 12.07  
1/10 TO 'E' DECK 43.0 - (16.2 + 4.2) = 22.7  
1/10 TO 'F' DECK 43.0 - (24.2 + 4.2) = 14.7

EQUIPMENT AS PER RULES.

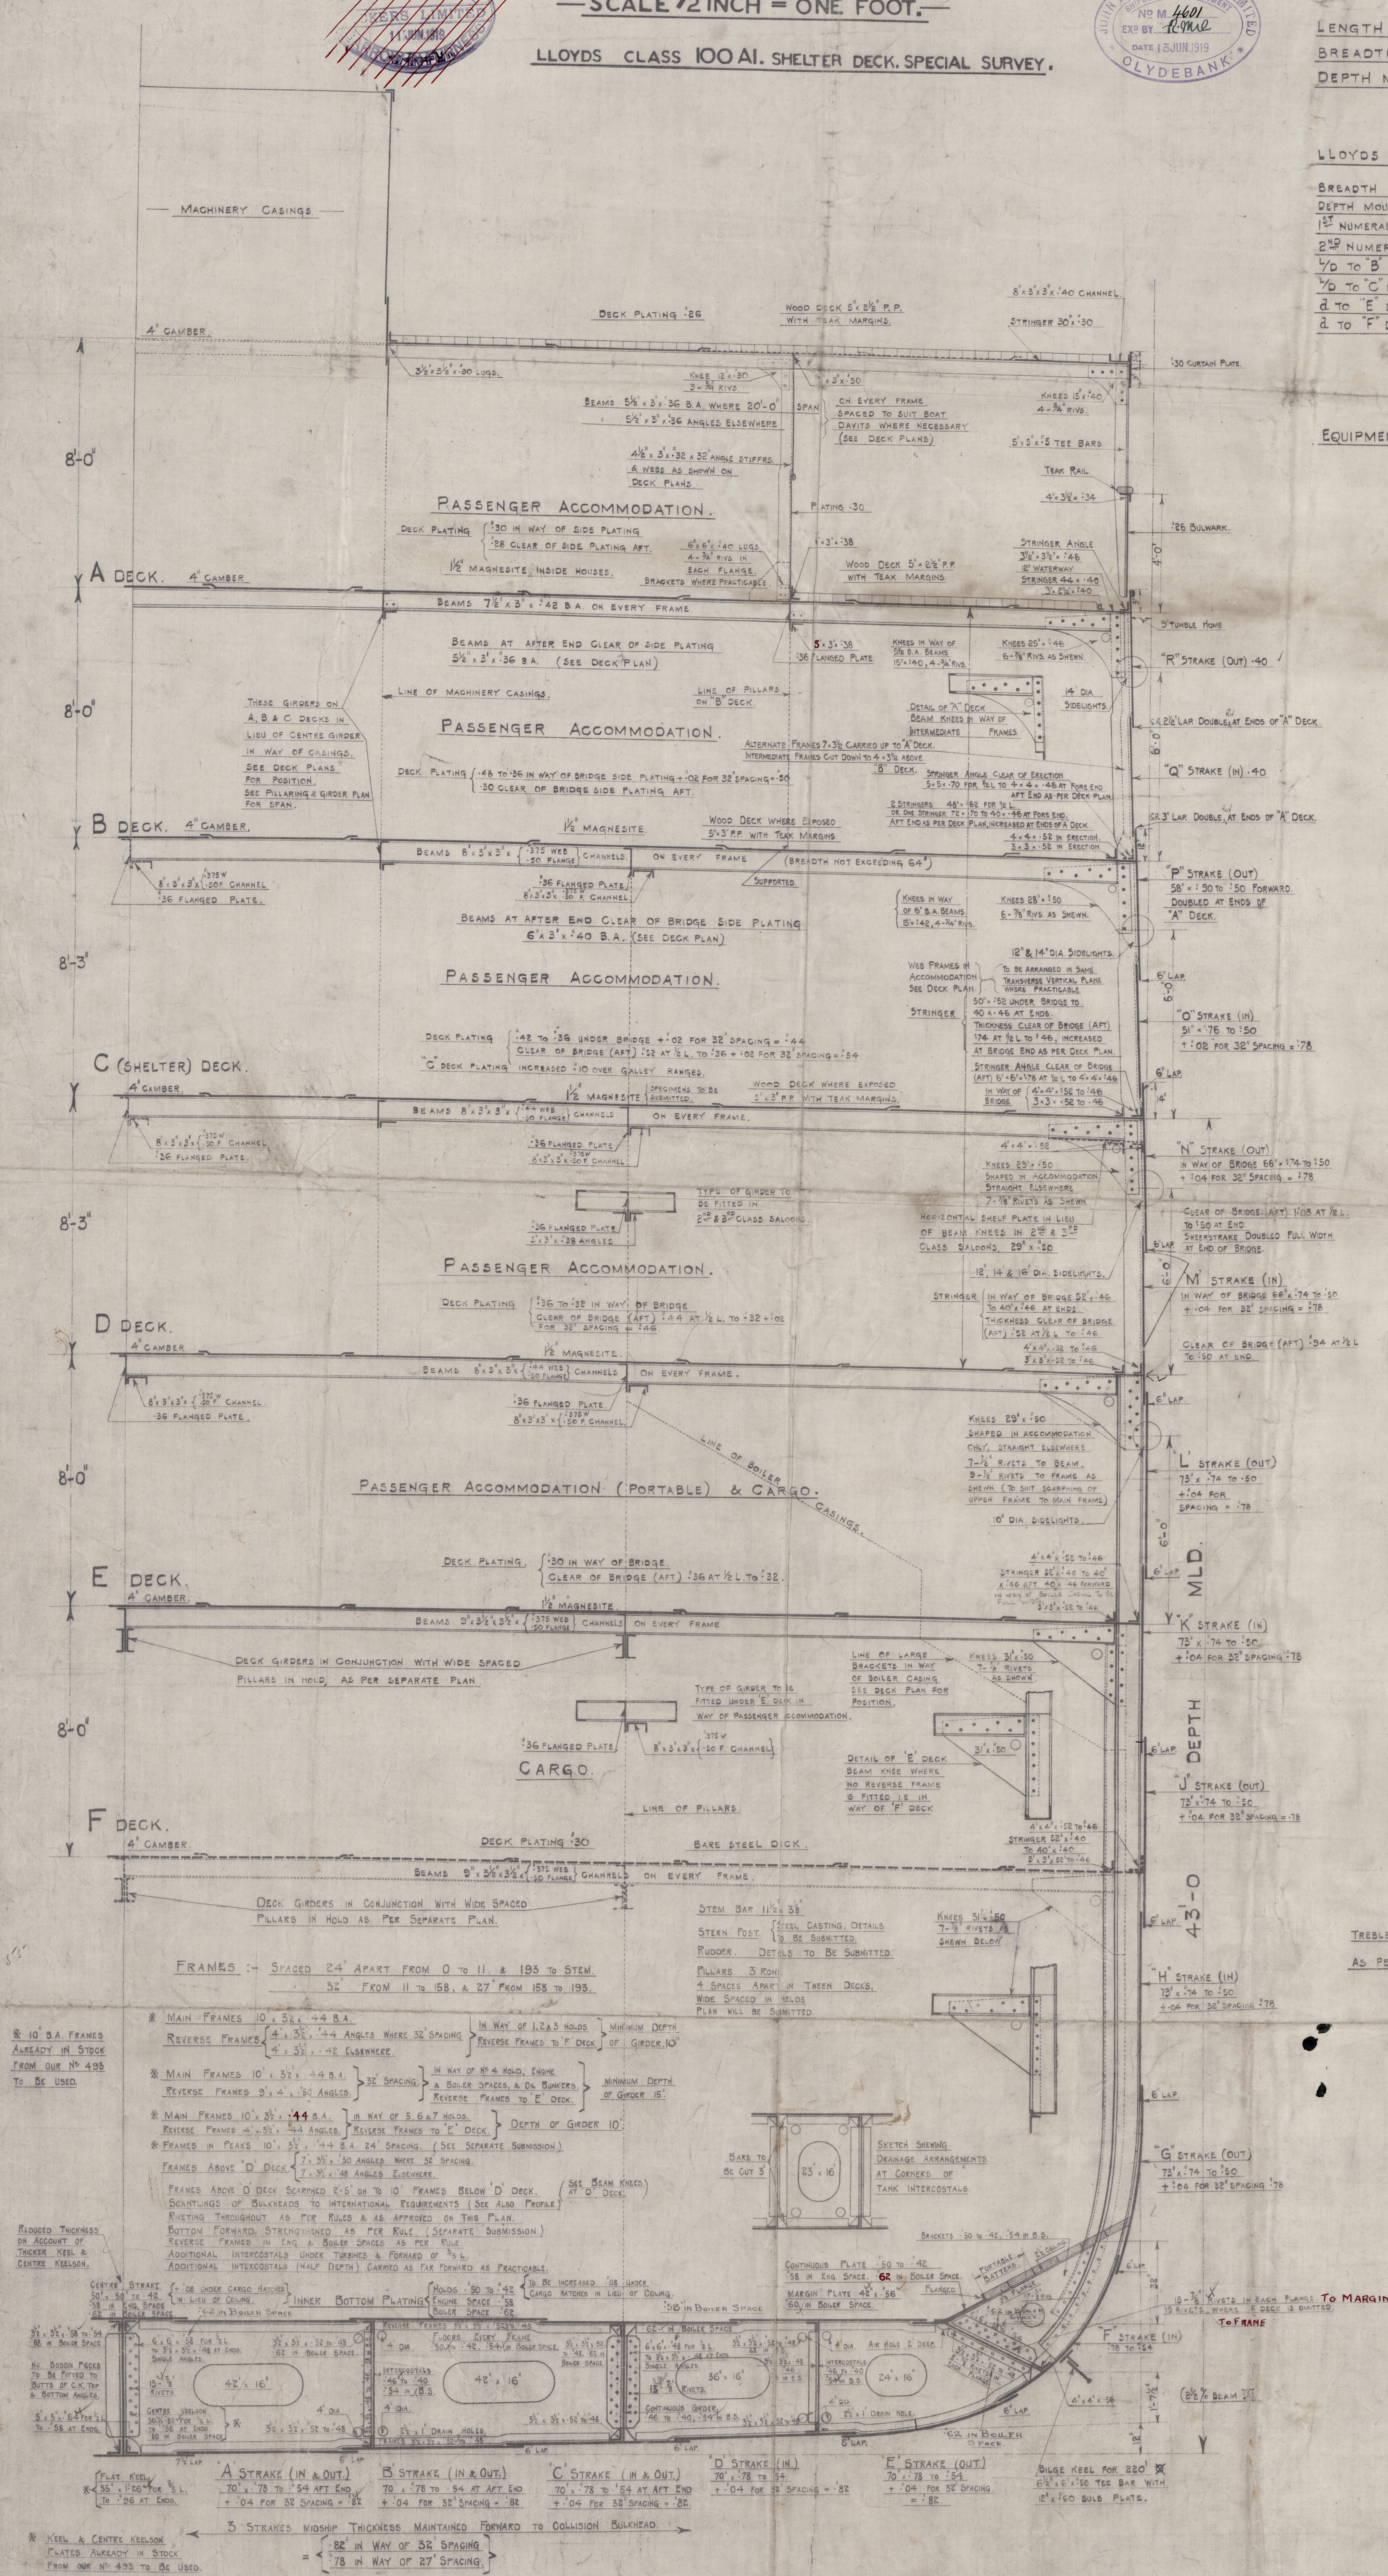

TREBLE RIVETED LANDINGS  
AS PER SEC. 25 PARA. 6.

9-5-19



*Mad. Becton*

*N<sup>o</sup> 495-*

---

*T. S. S. Alauinia*

GLASGOW REPORT No. 44840