


30.11.14
7-1-15

MODIFICATIONS IN BLUE AS FITTED IN SHIP.

 

note: a sketch showing the beams, deck plating, hatchway coamings and webs, also the girders and pillars in way of the hatchways, is to be submitted.
Bulk pillars to be fitted at center line in way of hatchways.

LONGITUDINAL SECTION & DECK PLANS Nos 445 & 6.

400'-0" B.P. x 53'-0" B.DTH. MLD x 29'-7" CLASS 100A. LLOYDS SPECIAL SURVEY.


Scale 1" = One Foot.

DATE 27/11/14
HARRIS & THOMSON LTD
LONDON & GLASGOW
BY IRVINE
EXAMINED AND PASSED
NATURAL ORDERED BY
SHEARER

Mackie + Thompson
Irvine

Nos 445 + 446

PROFILE and DECK PLAN

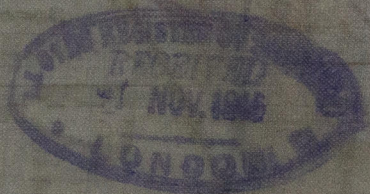

GLASGOW REPORT No. 36849

J. Glennevis
How Bottle

WS 401

GLASGOW REPORT No. 36943

J. Glencarrow



© 2021

Lloyd's Register
Foundation

W293-0124