


$\begin{array}{r} 20.96 \\ 20.86 \\ \hline 12.036 \\ 4012. \\ \hline 4024. \end{array}$

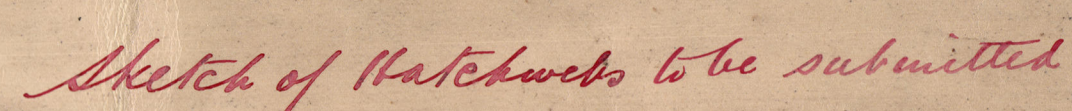

C. J.
24. 12. 14

400'-0" BP x 53'-0" BREADTH MLD. x 29'-7" DEPTH MLD CLASS 100A1 LLOYDS SPECIAL SURVEY.
SCALE 1" = 1' 00"
16/12/14.

MACKIE & THOMSON


N^o 445-6

#

AMENDED DECK PLAN



#

(A)

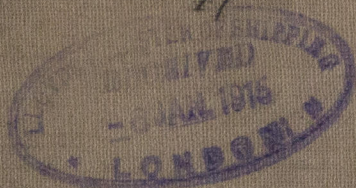


GLASGOW REPORT No 36849

"Boten" Ex. 7/8 GLENNEVIS

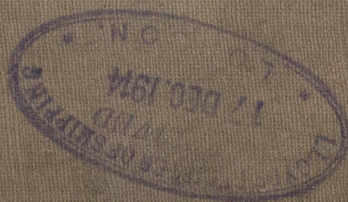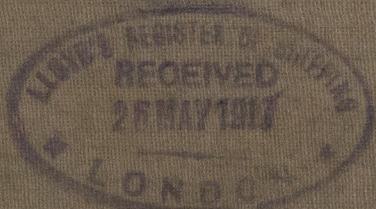

GLASGOW REPORT No 36943

7/8 Glencairn.

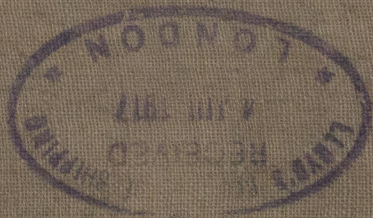

© 2021

Lloyd's Register Foundation
W293-0125