


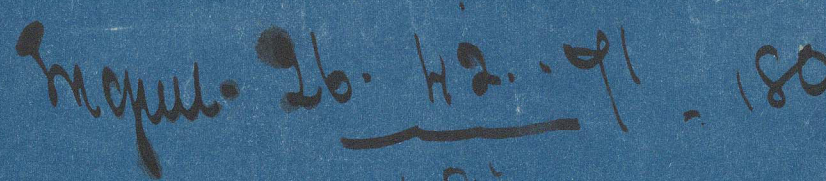


ONE OFF AS DRAWN



Rule 8a 13.5

exam 23/4/29

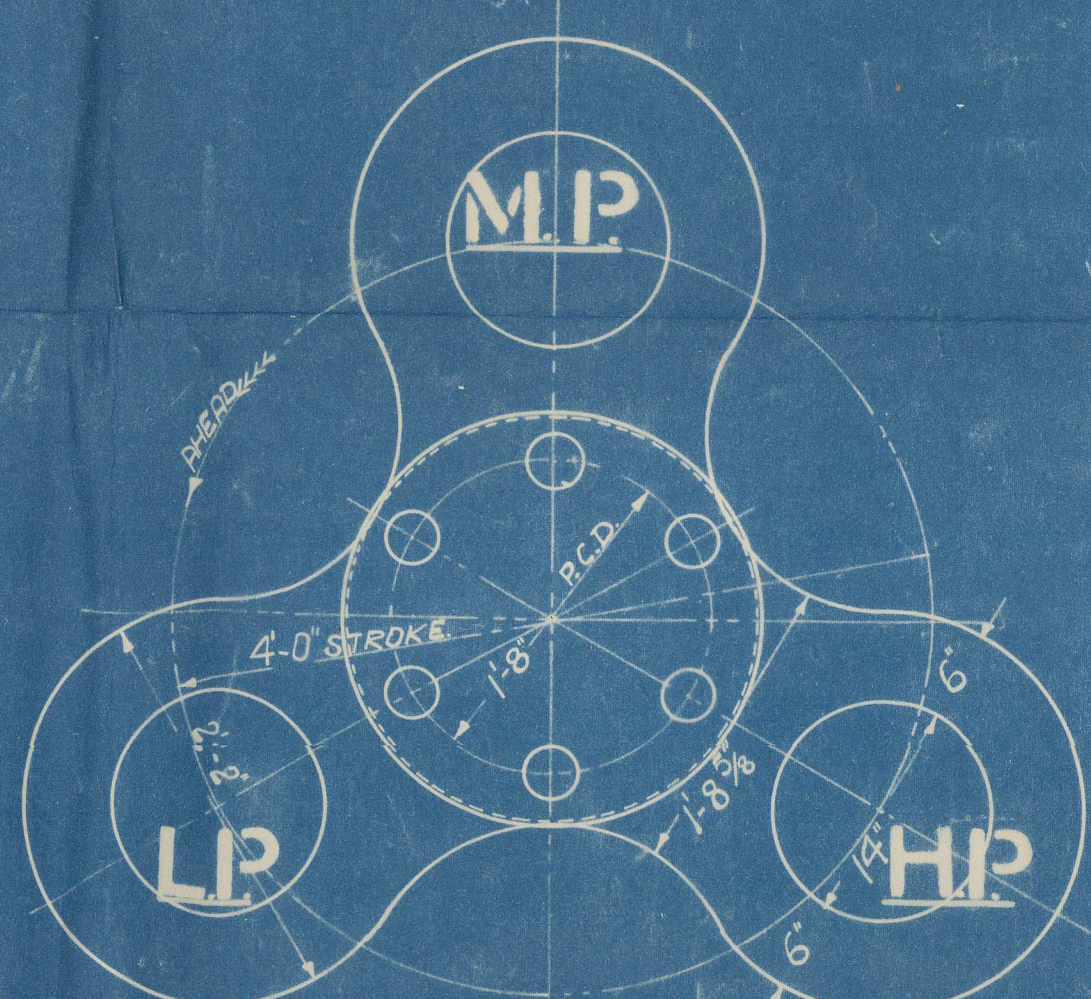

LOOKING AFT

COUPLING BOLTS. HALF SIZE.

12 - OFF - (WORKING)

CRANK SHAFT.

ENC. Nº 66.5.

SCALE:- 1" = 1 FOOT.

6TH APRIL 1927

DRC. №4967

© 2020

Lloyd's Register
-0064- Foundation

JOHN G. KINCAID & Co. LTD.
(DRAWING OFFICE)
22 APR. 1929
ENGINEERS & BOILERMAKERS.
GREENOCK.

~~Crank~~ Shaft
Kincaid 665

S. S. "Antiope".
Lyth. Report N° 19150.

W3-0064
1900-3M



© 2020

Lloyd's Register
Foundation