


W305-0204

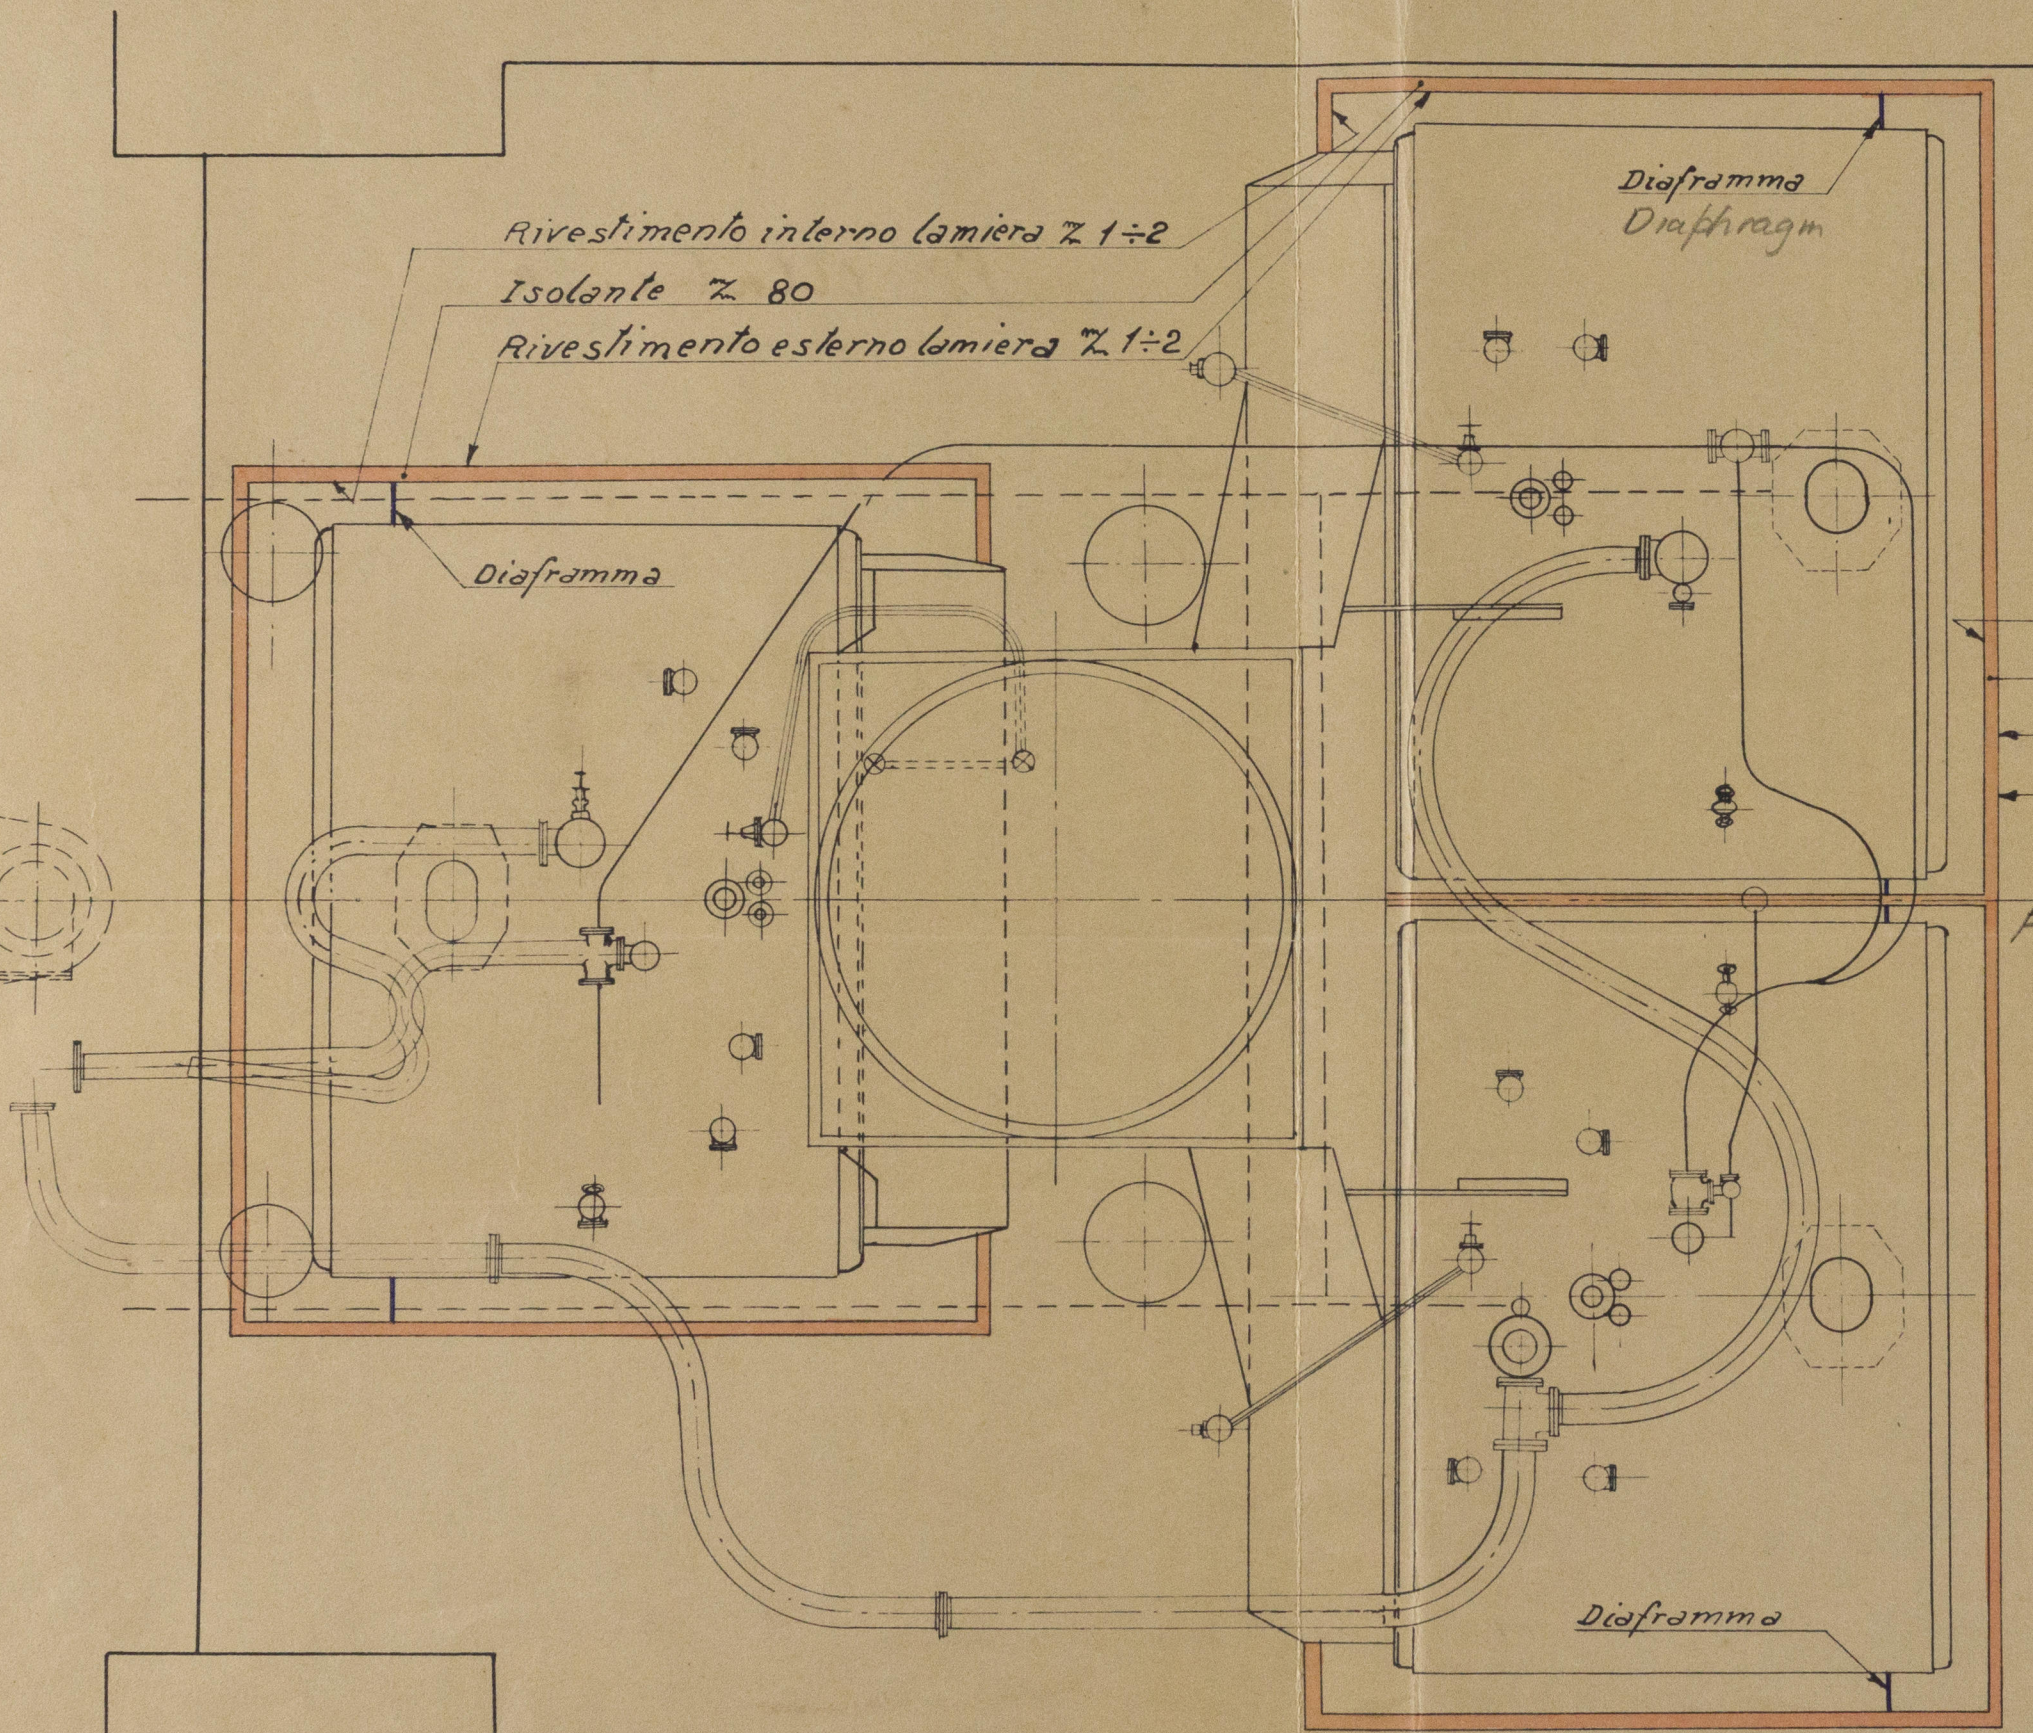

100
250

Internal lining of plate, 1 to 2 mm thick
Rivestimento interno lamiera 1/2
Lagging
Insulation 80
External lining of plate, 1 to 2 mm thick
Rivestimento esterno lamiera 1/2
Interceding Air space
Plating of fuel oil tank
Prora
Forward

S/S ALABAMA
General Arrangement
Plan
Noted. J. M. A.
12/14/30

I.M.I. IMPRESA MECCANICA INDUSTRIALE - GENOVA	
Concessionari Economizzatori Combustibile	
DE DOMENICO Brevetto N. 326974	
Pioscafo ALABAMA	
Sistemazione generale	
Pianta	L. 48
26-27-28	7 134
26 Sett 1937. XV	

SS. 'Alabama'.

See reference in Genoa Machinery Report
No. 15-186 re. Proposed Modification of
Boilers (Proposal does not appear to
have been carried out.)

File with above report.

W305-0204



© 2020

Lloyd's Register
Foundation