


D.R.N. 47398


EXISTING BILGE MAIN:

ADDITIONAL BILGE SECTIONS

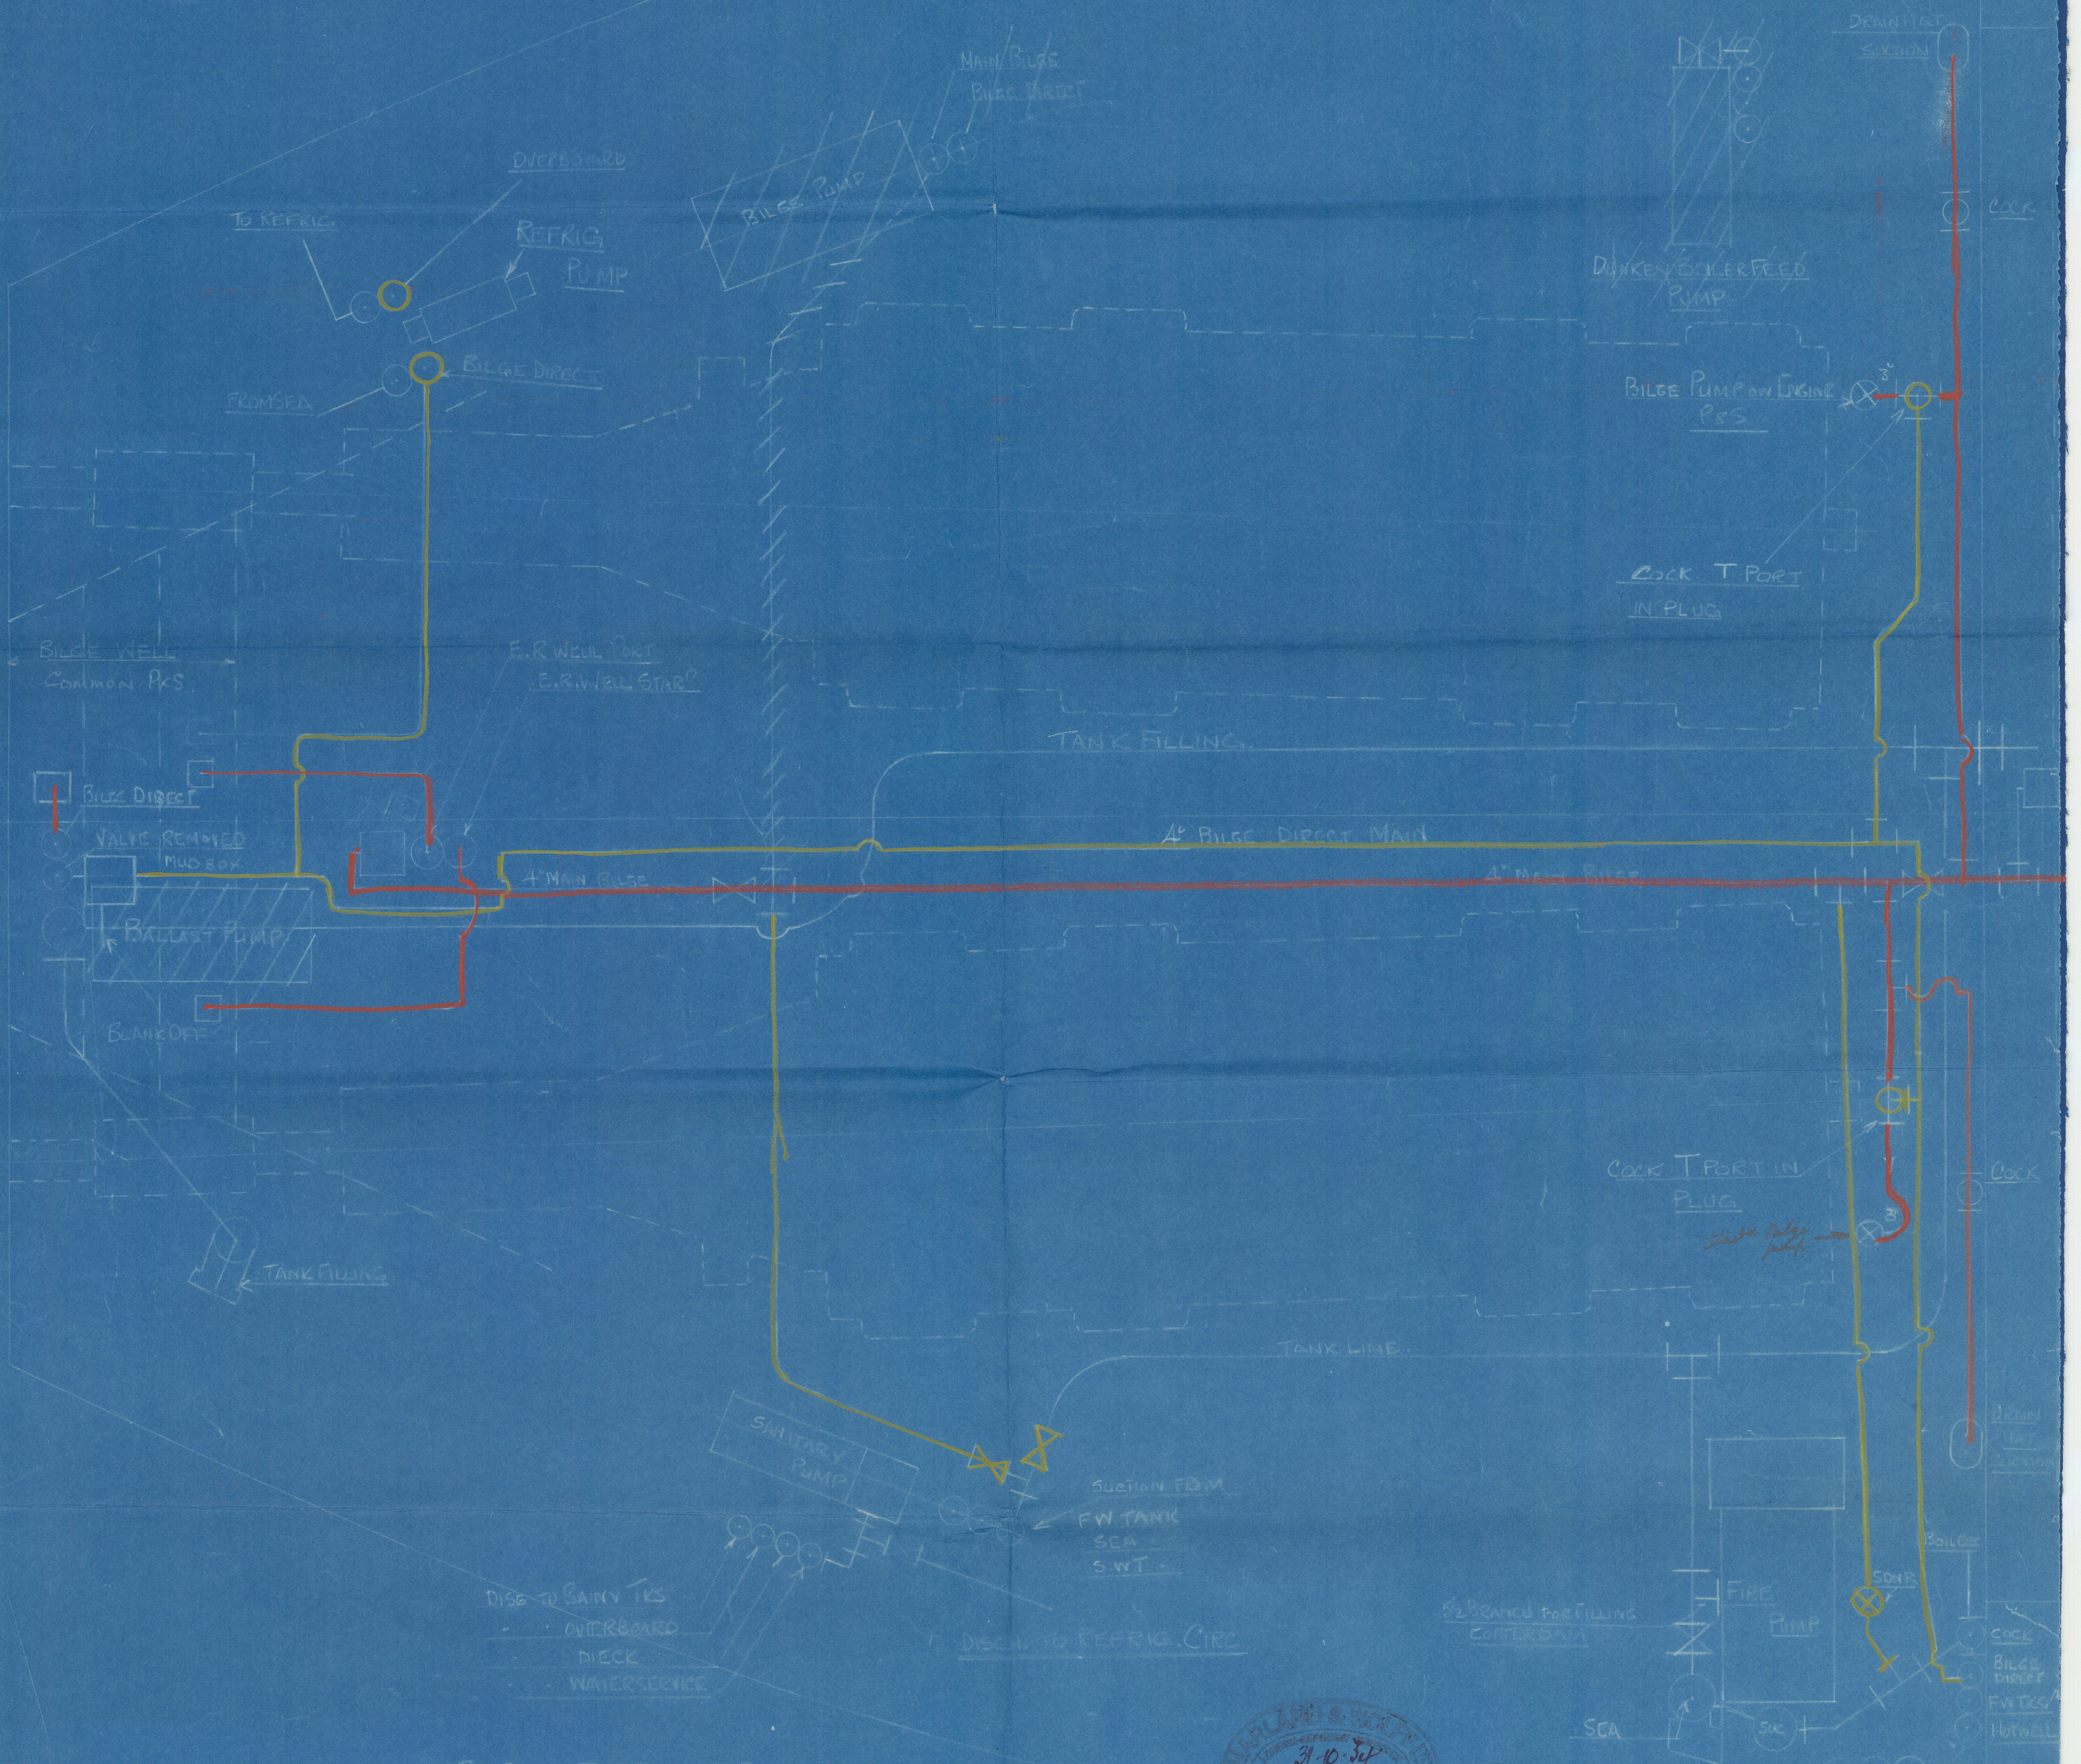


S.S. IROQUOIS

DIAGRAM OF BILGE & TANK SUCTION & DISCHARGES

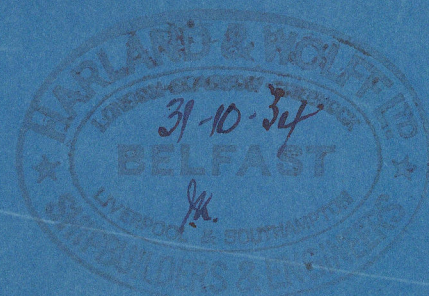

DISG - START CONDENSER
OVERBOARD
DECK & TANKS
BOILERS

S.S. IROQUOIS
Ref. rep. No. 1140X.
Alterations to bilge lines
in Engine Room

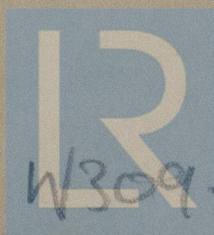

© 2021

Lloyd's Register
Foundation

W309-0067