
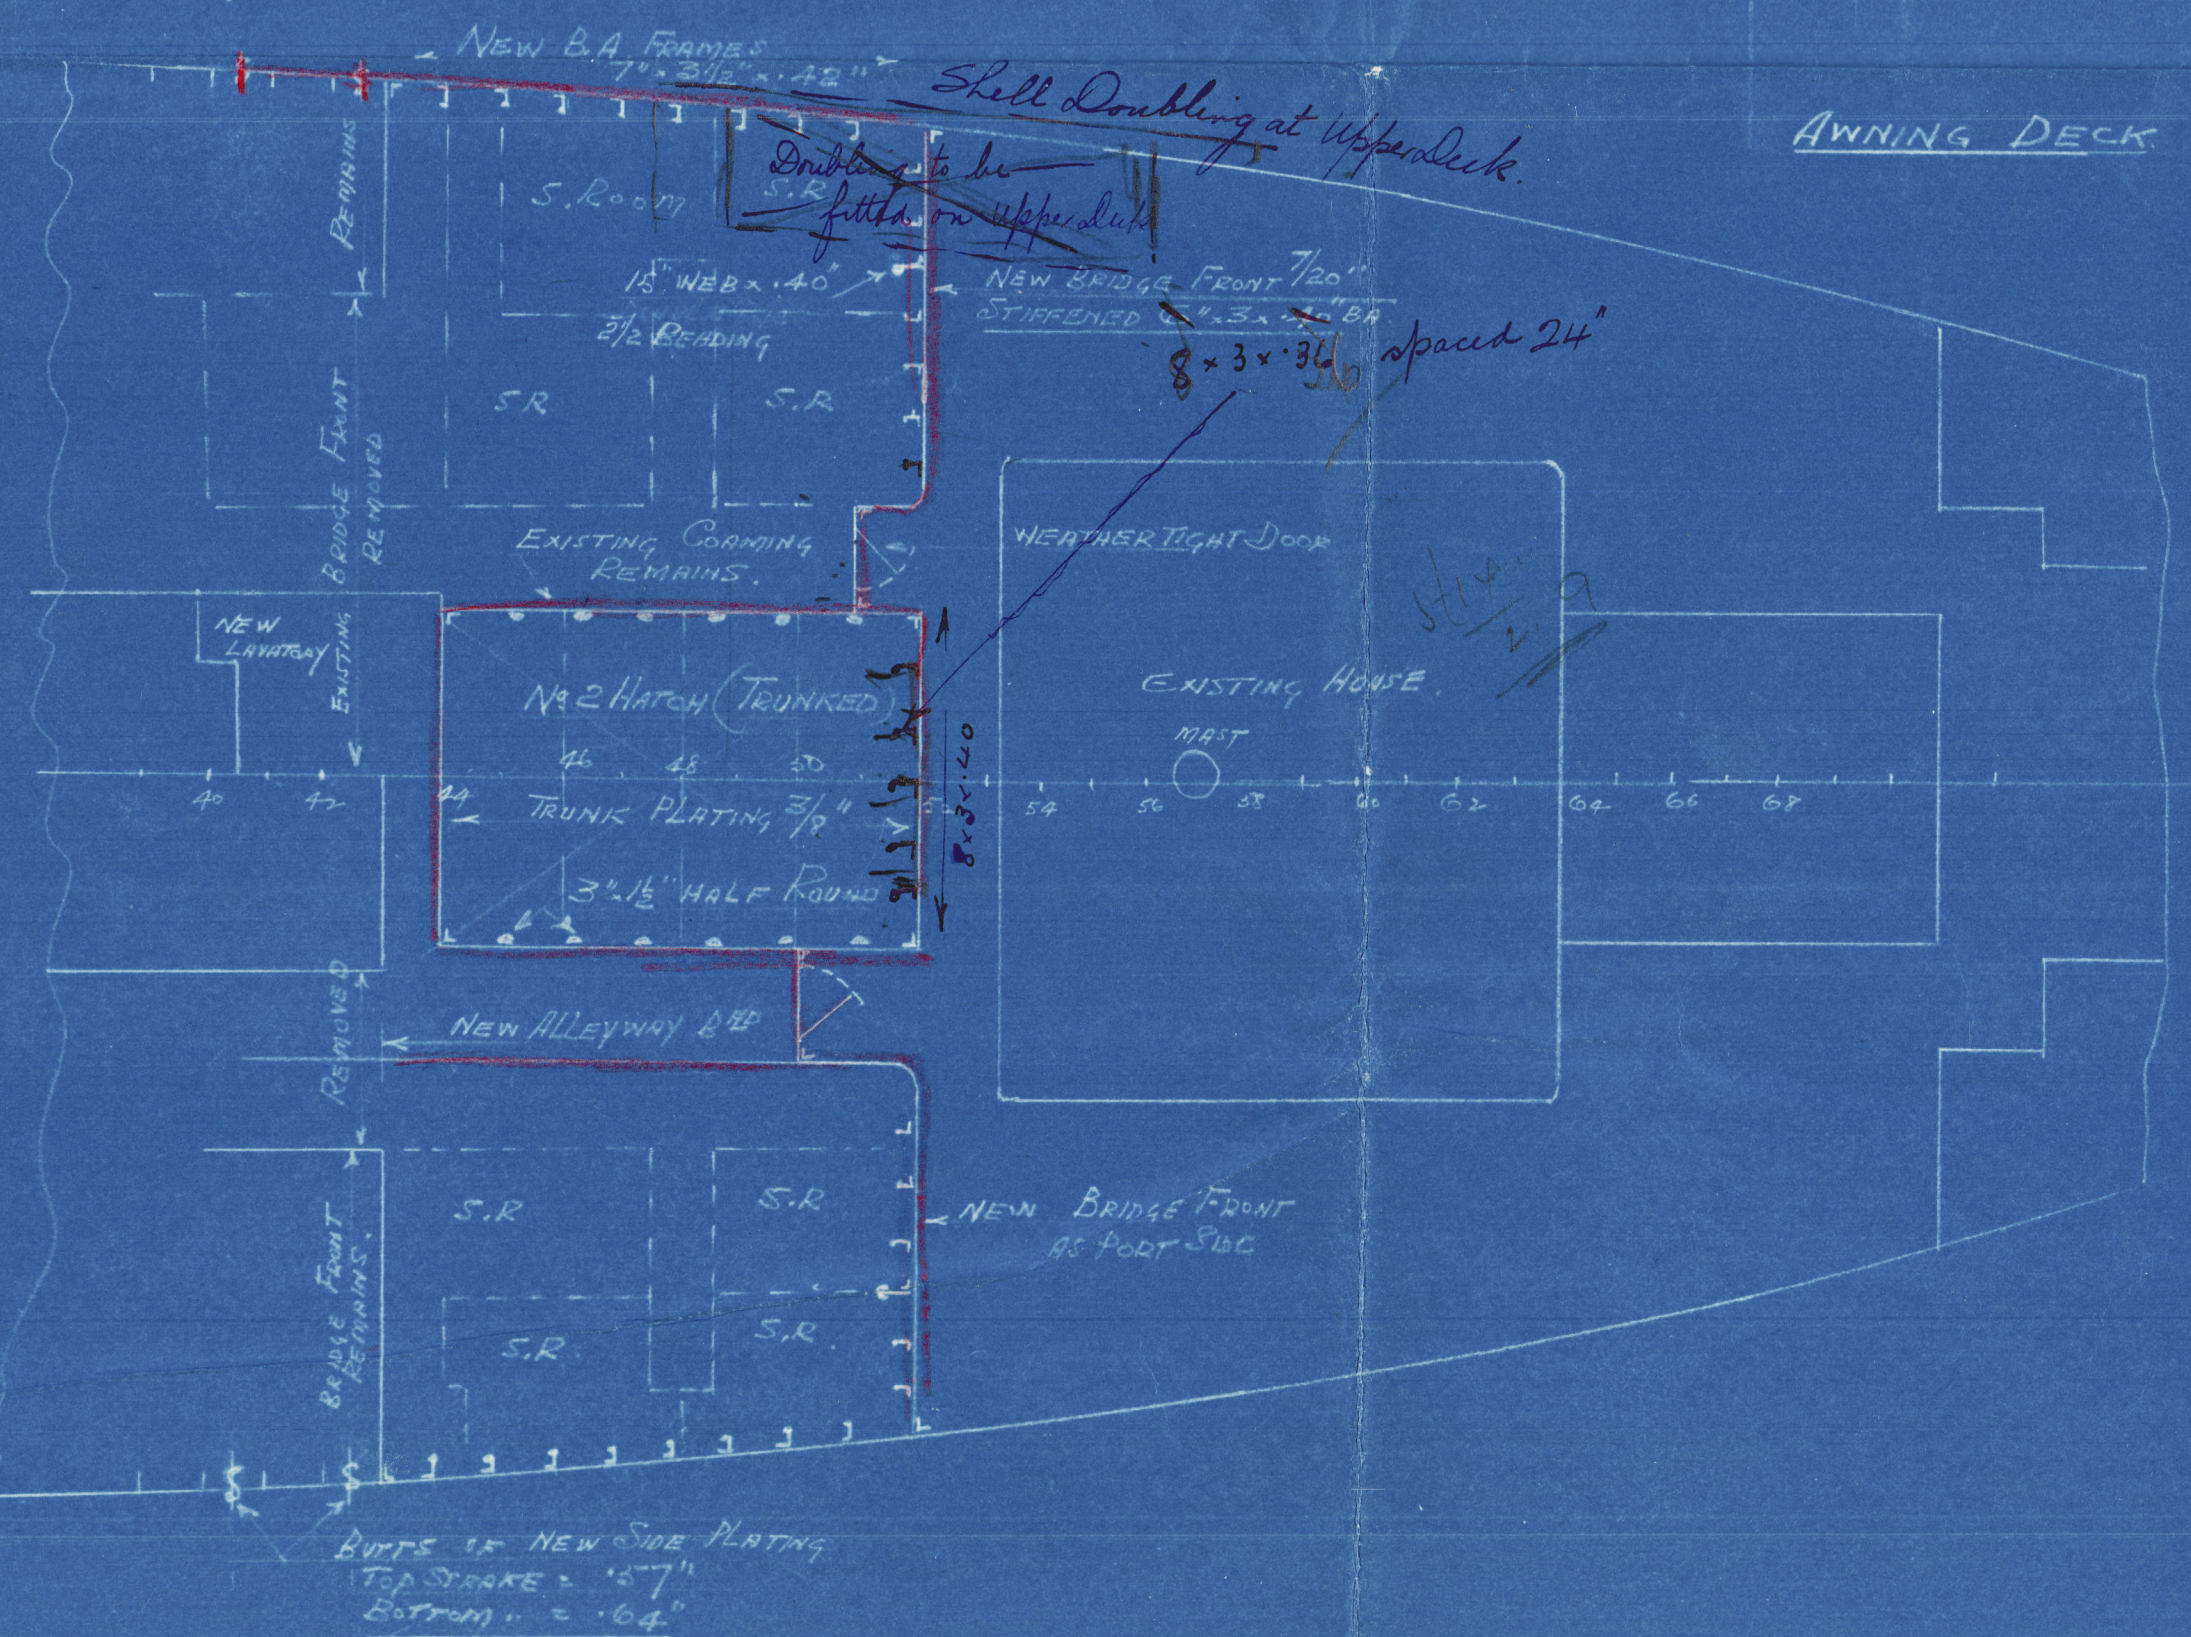
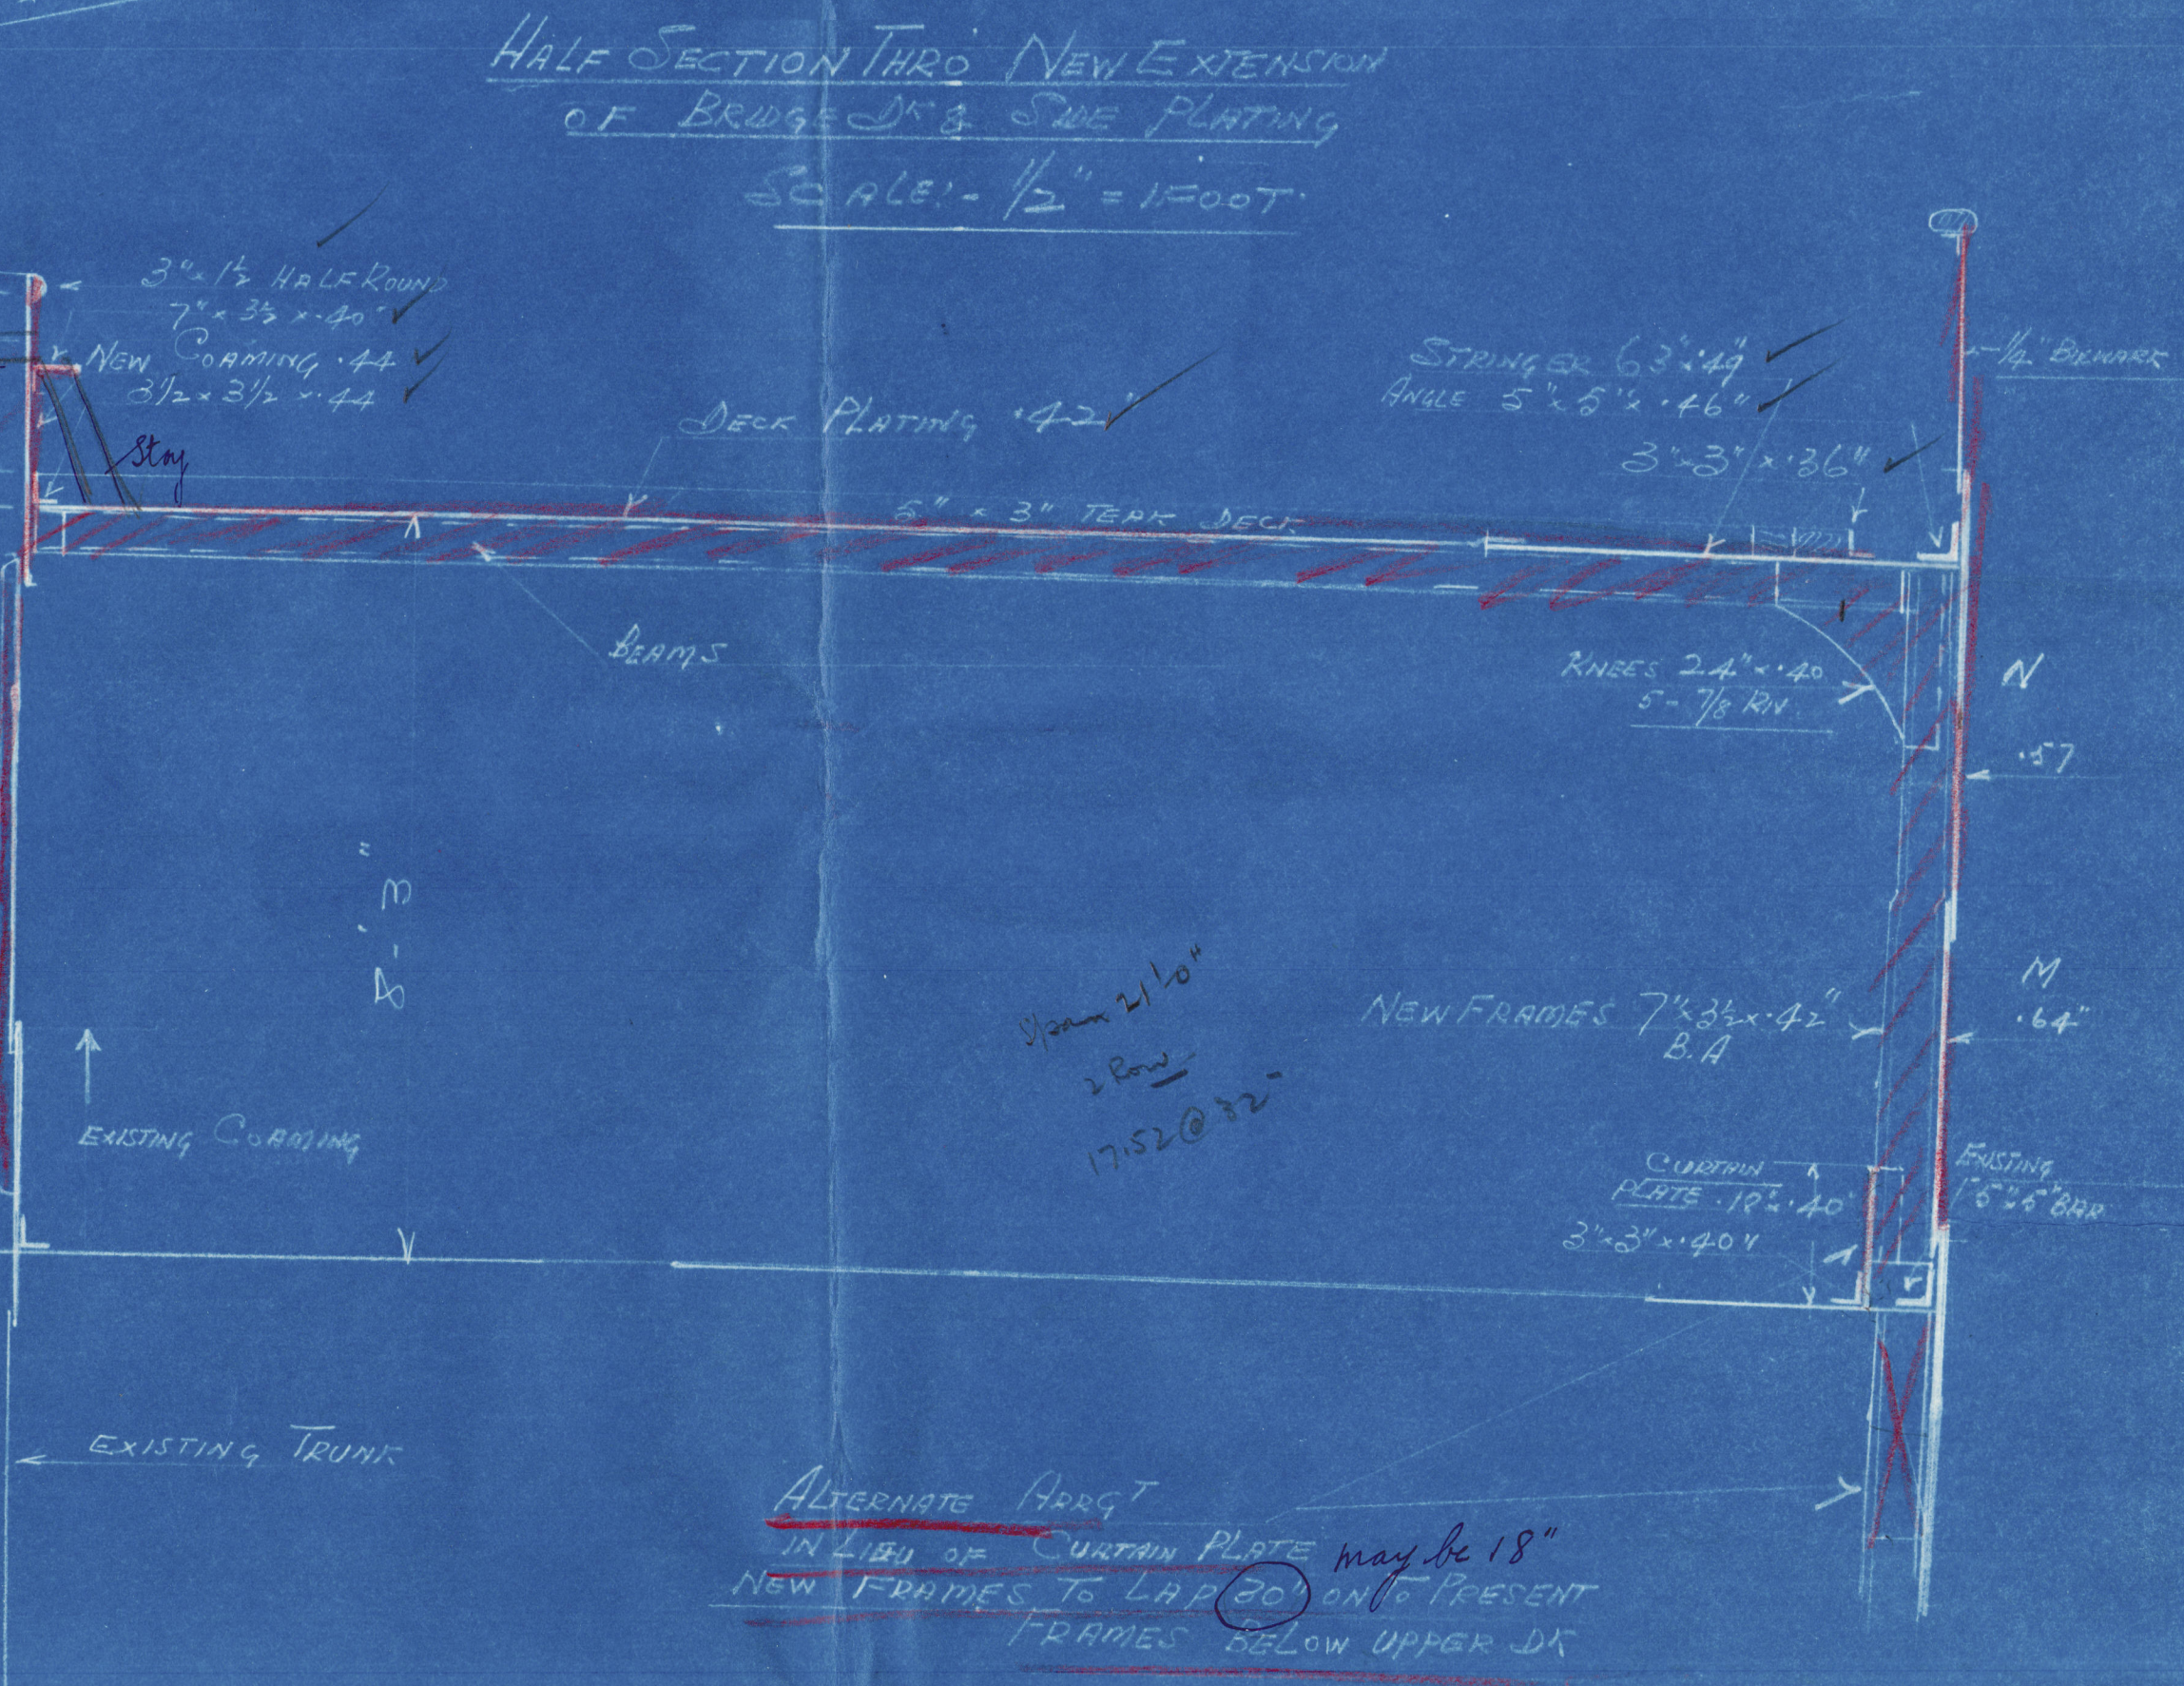
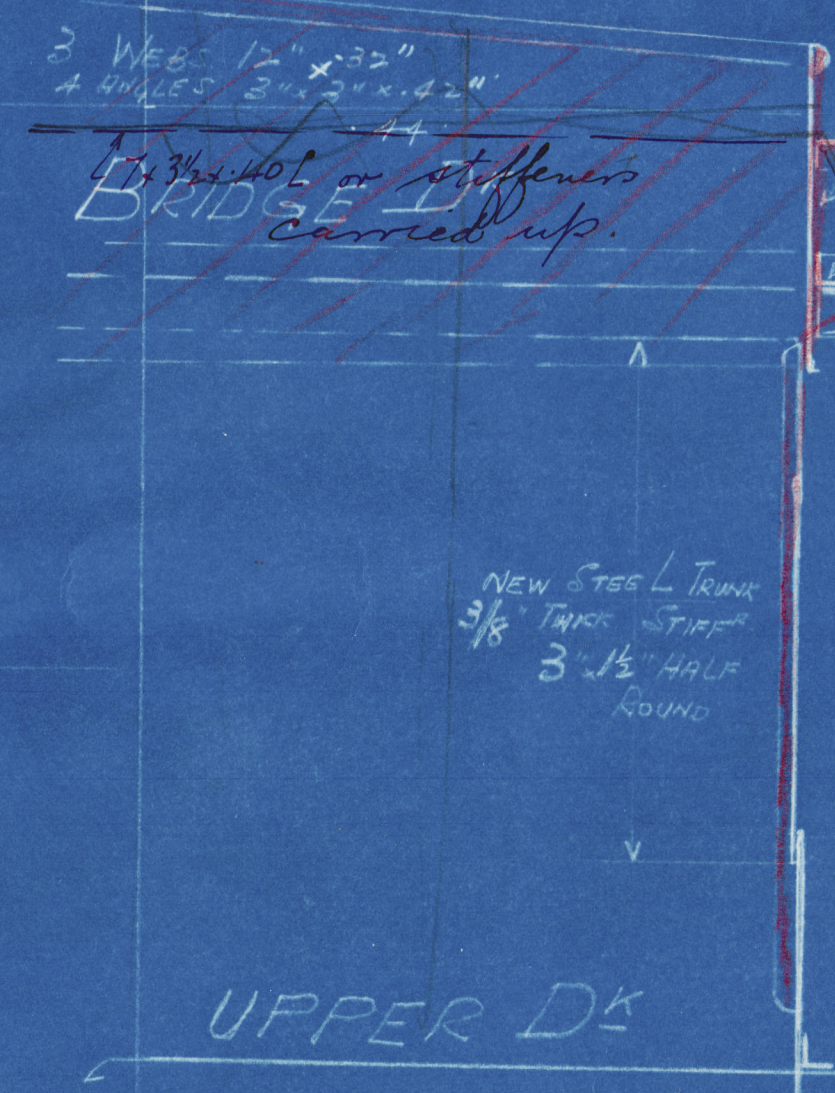
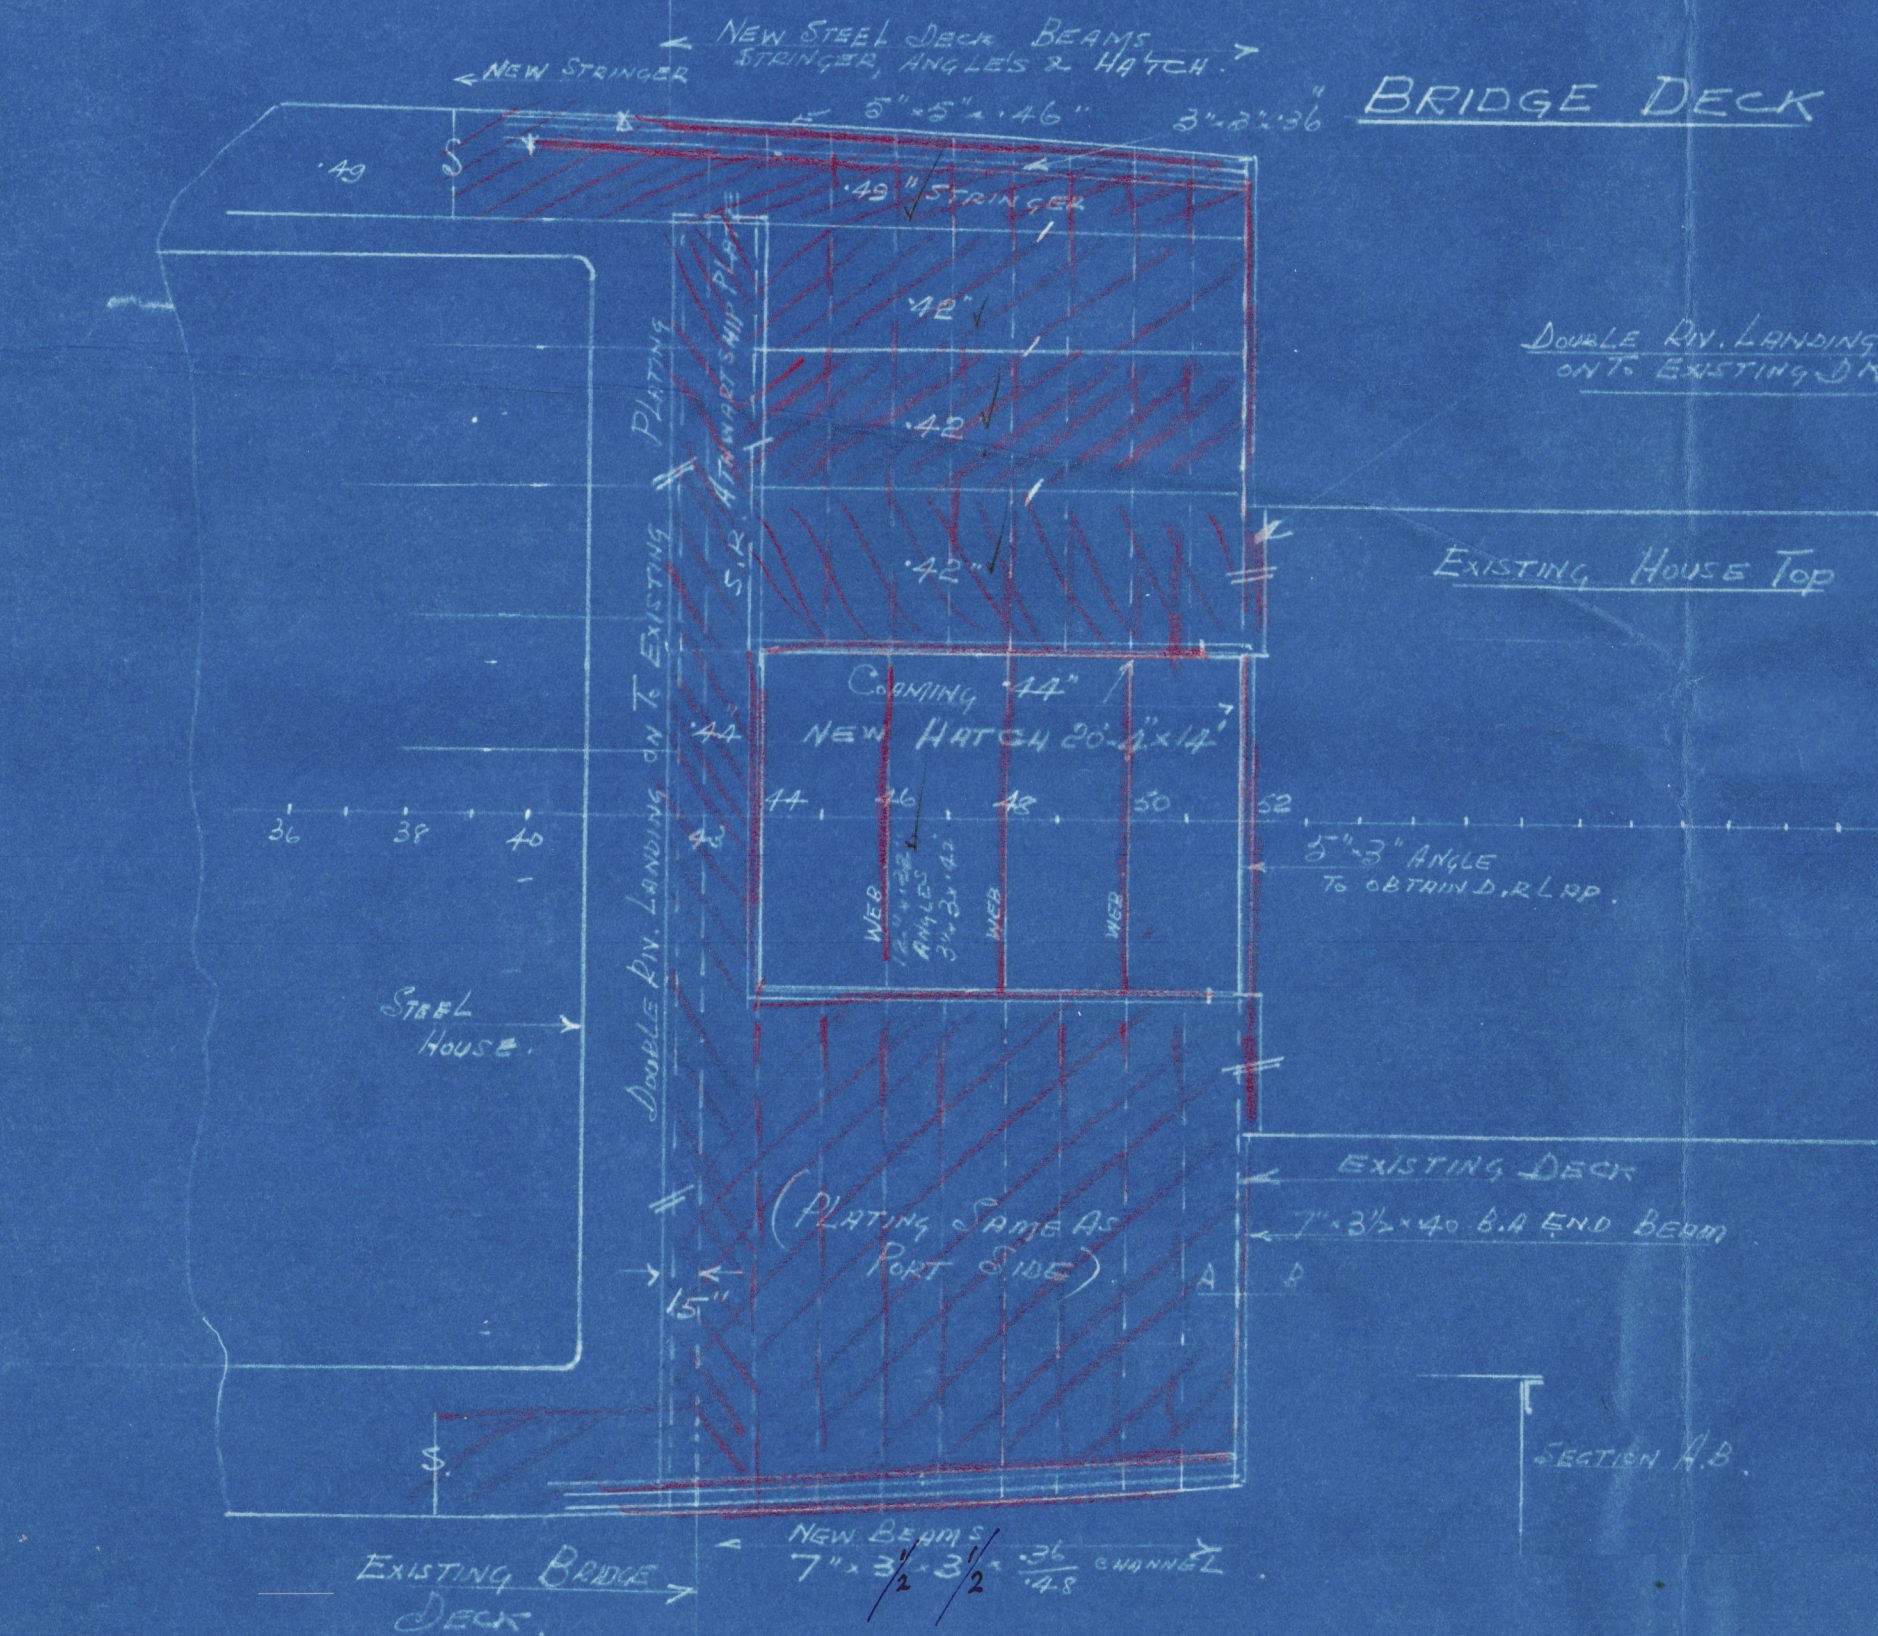


Office

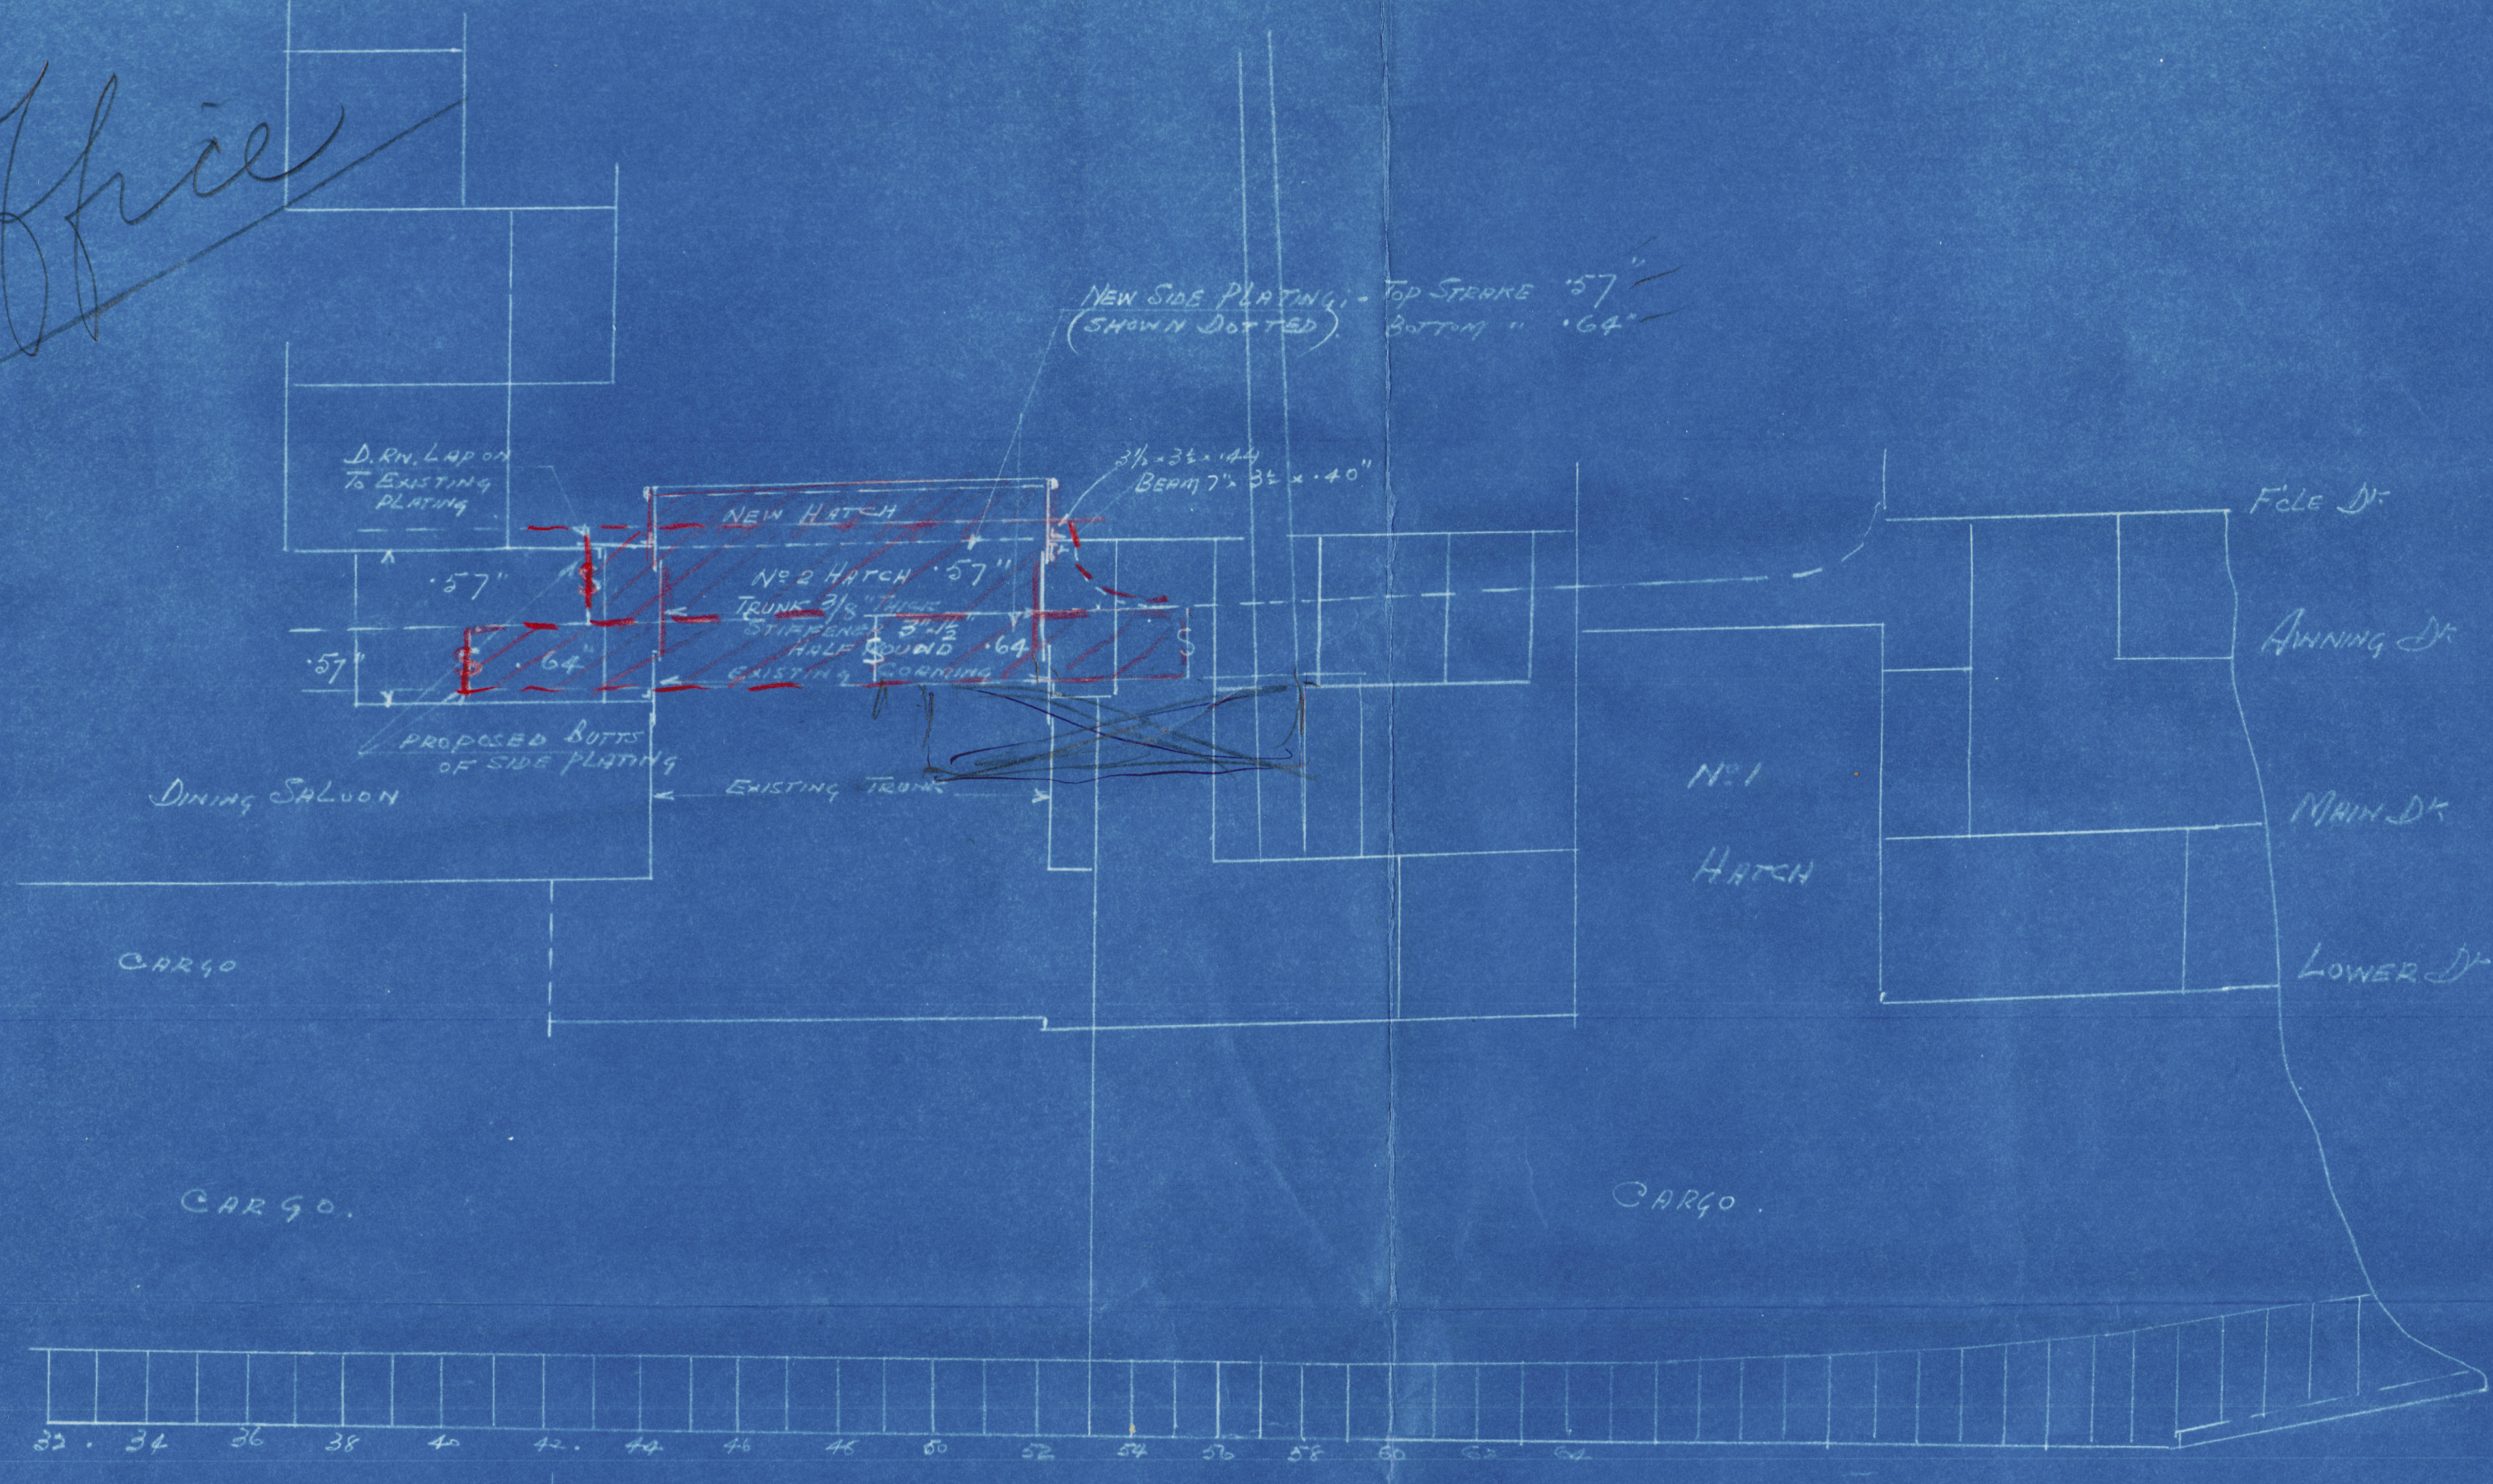

S.S. ACCRA
 DIMS 450'-0" x 62'-0" x 35'-0" MLD.
 PROPOSED EXTENSION OF BRIDGE DECK FORWARD FROM
 FRAME 43 TO 52, WITH NEW BRIDGE SIDE PLATING
 ALSO NEW BRIDGE FRONT

SCALE: 1/8" = 1 FOOT.
 NEW CONSTRUCTION IN RED

10. 9. 17