
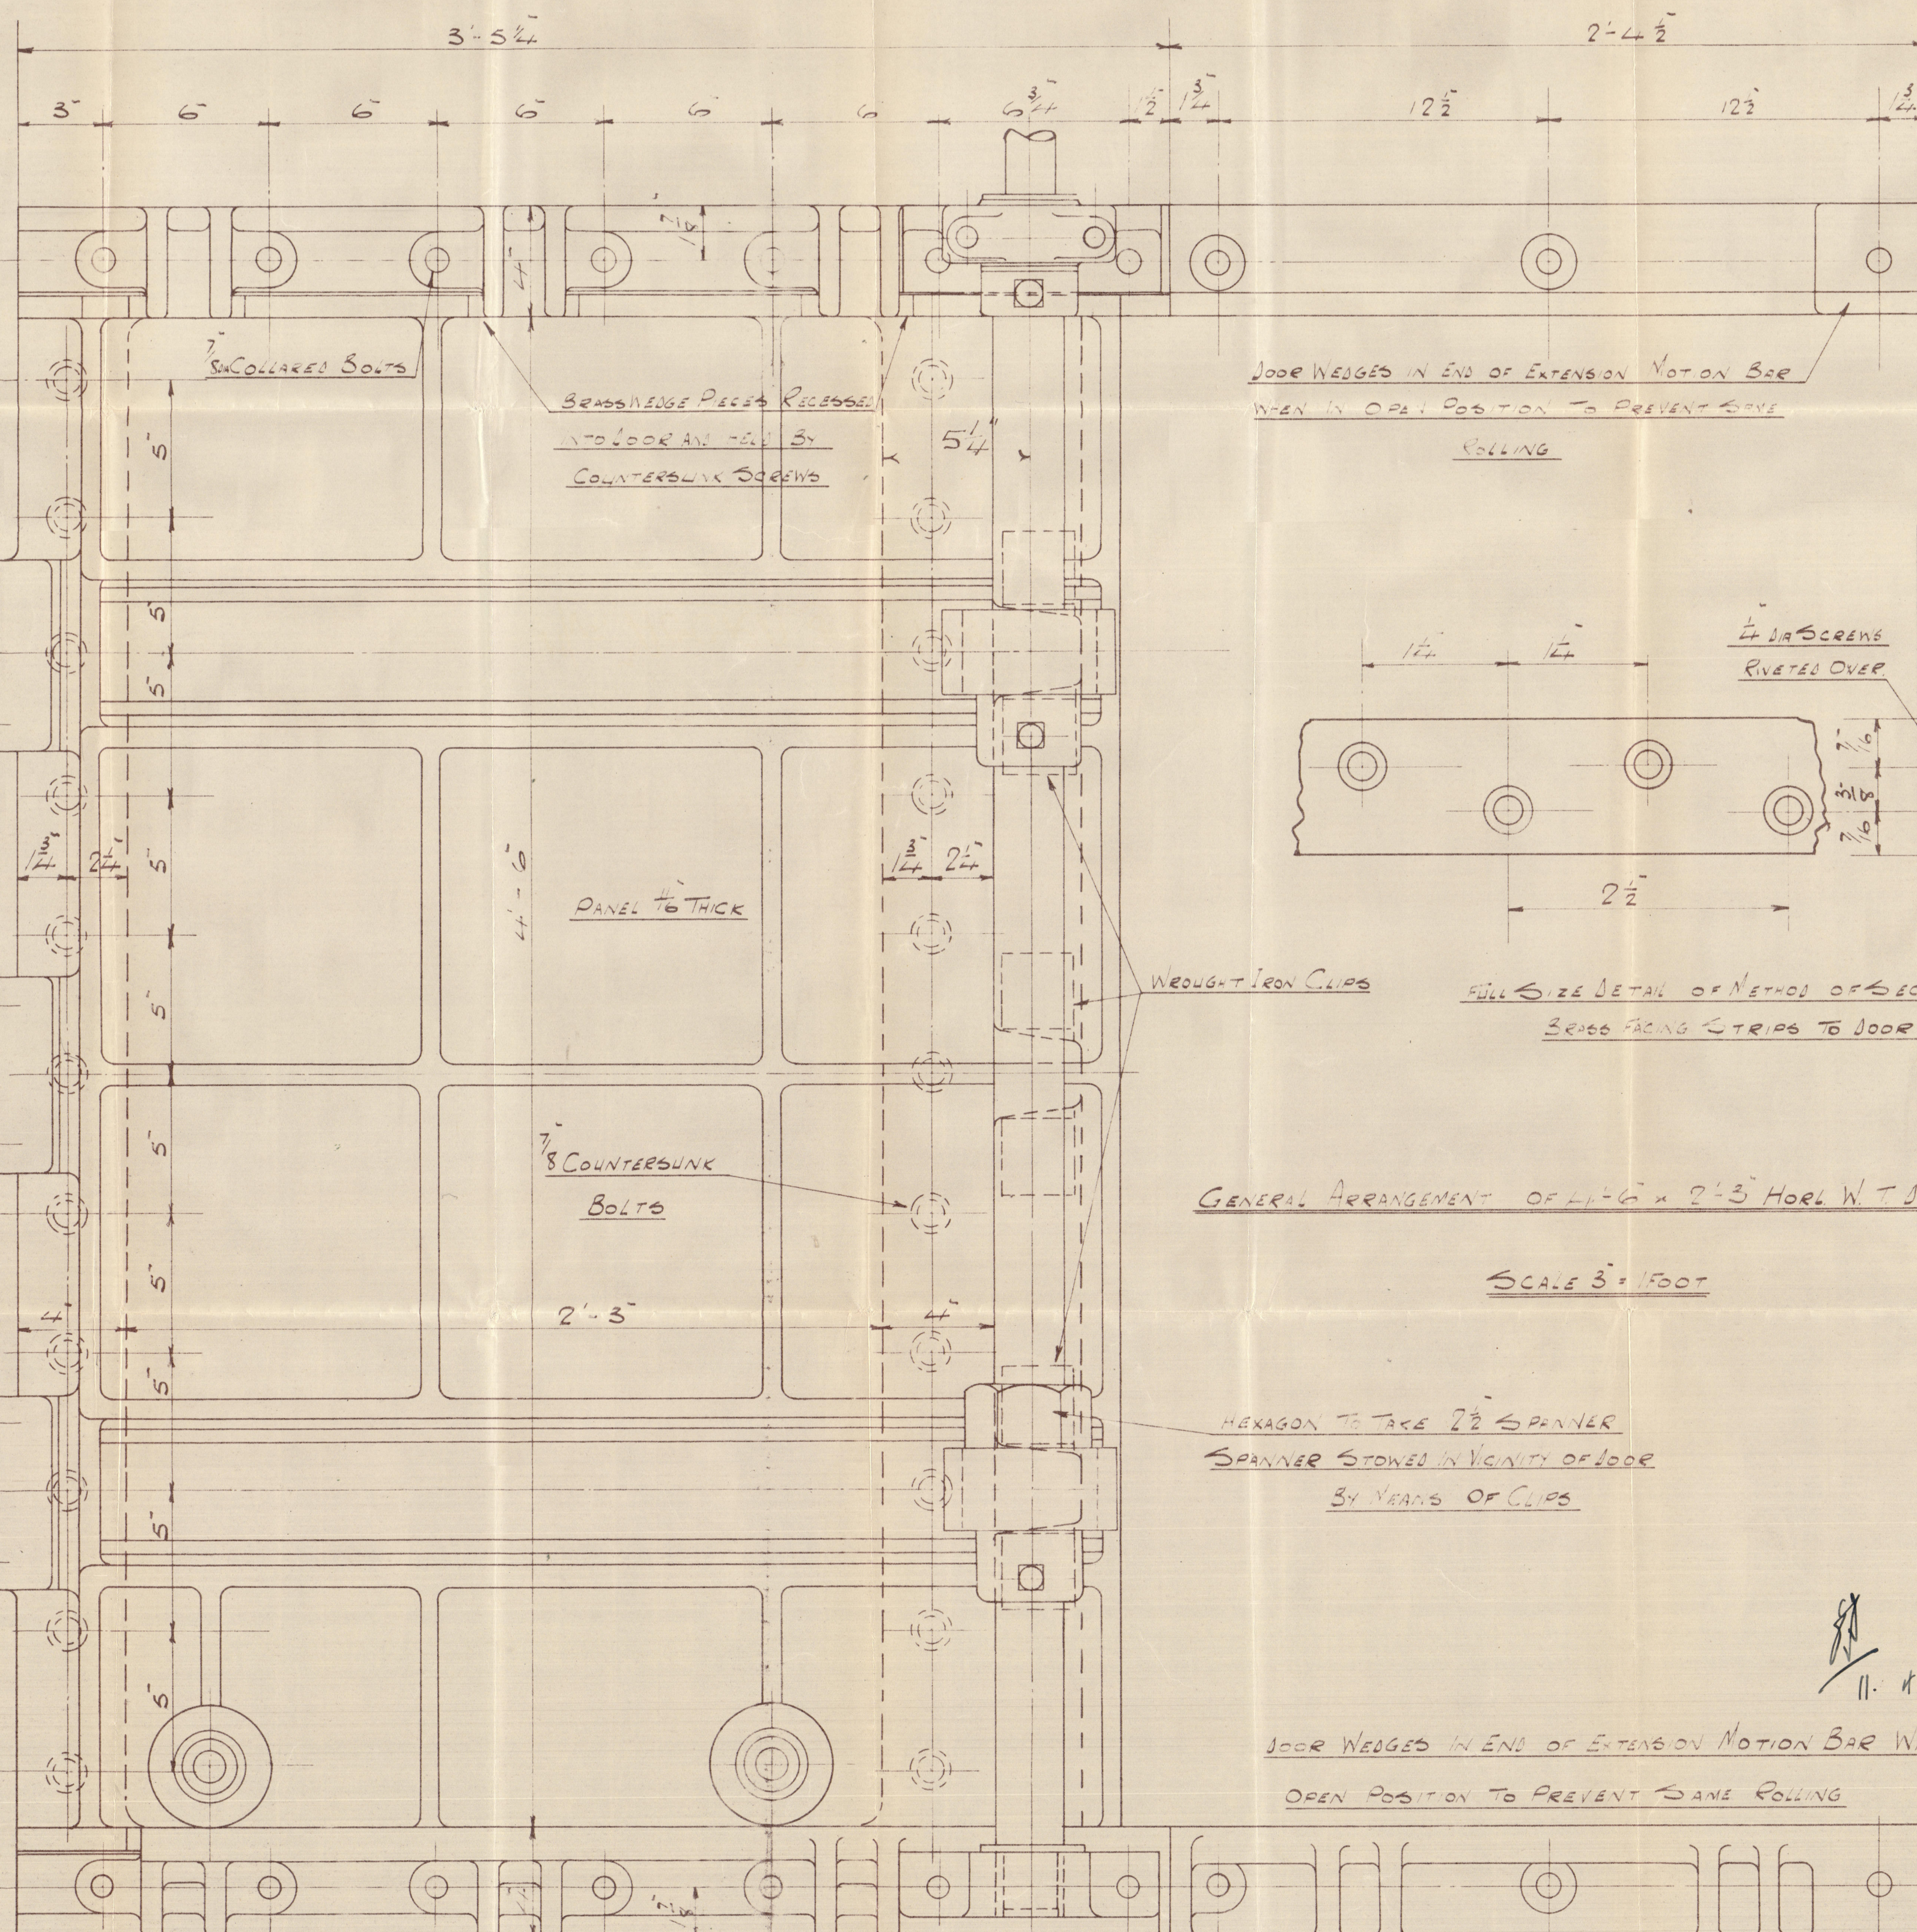


11.4.35

BRASS FACING STRIPS IN WAY OF
SNUGS RECESSED INTO DOOR

FRONT AND BACK FACING STRIPS FITTED AGAINST $\frac{1}{8}$ " COLLAR
ON DOOR TO TAKE SHEAR OFF RIVETS

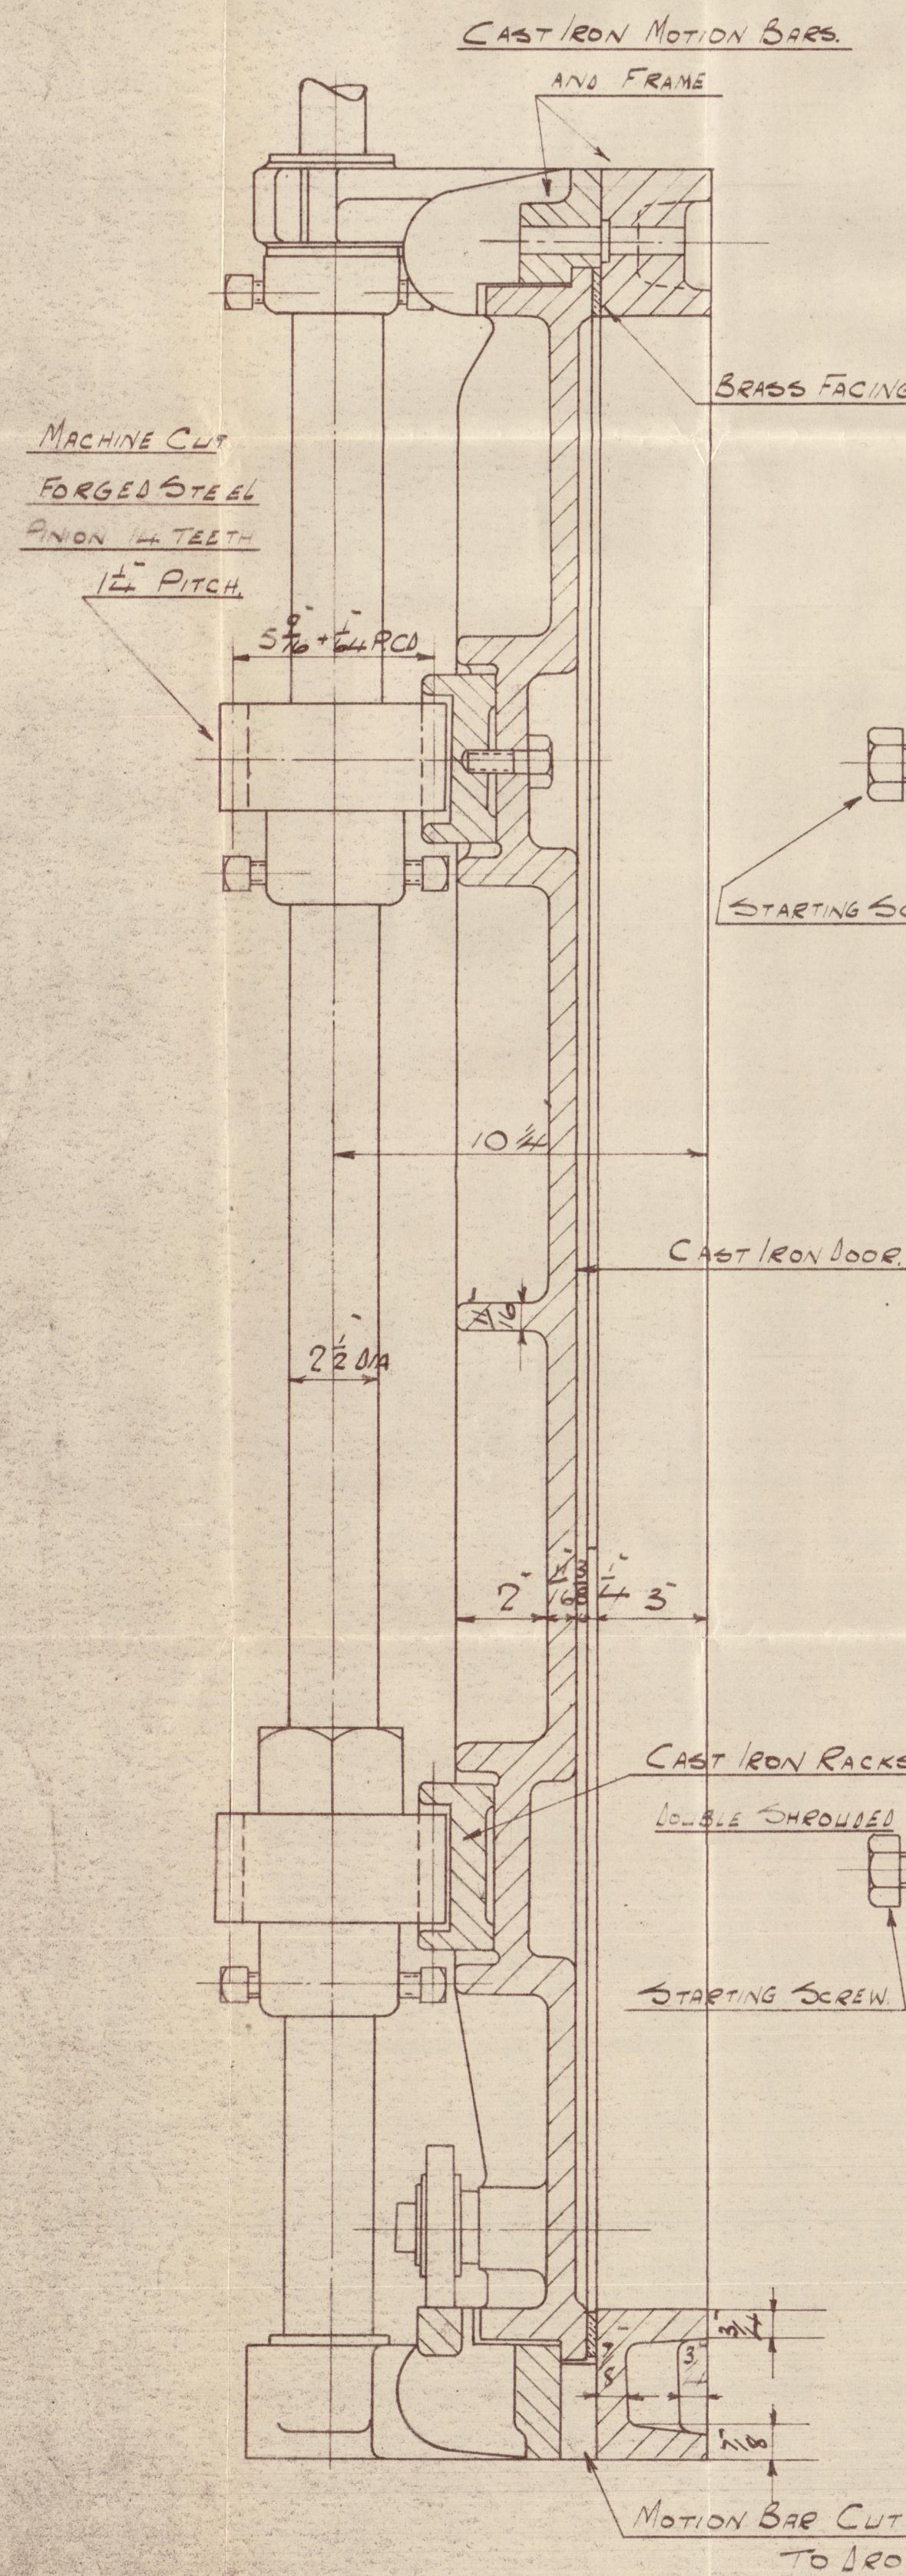

GENERAL ARRANGEMENT OF 4'-6" x 2'-3" HORL. W.T. DOOR

SCALE 3" = 1'00"

11.4.35

M/S. "ACORA" & "APAPA"

DONKIN & Co, LTD.
ENGINEERS,
WALKER GATE,
NEWCASTLE-ON-TYNE.
No 49115. 21.9.35.

Lloyd's Register
Foundry 1000

W324-0016

DRAWING N° 2125 FOUNDRY 1000

ACCR A

+ APAPD

W. T. dool

Liverpool Rpt 105391

© 2020

Lloyd's Register
Foundation

W324-0016