



ELEVATION LOOKING TO PORT SIDE

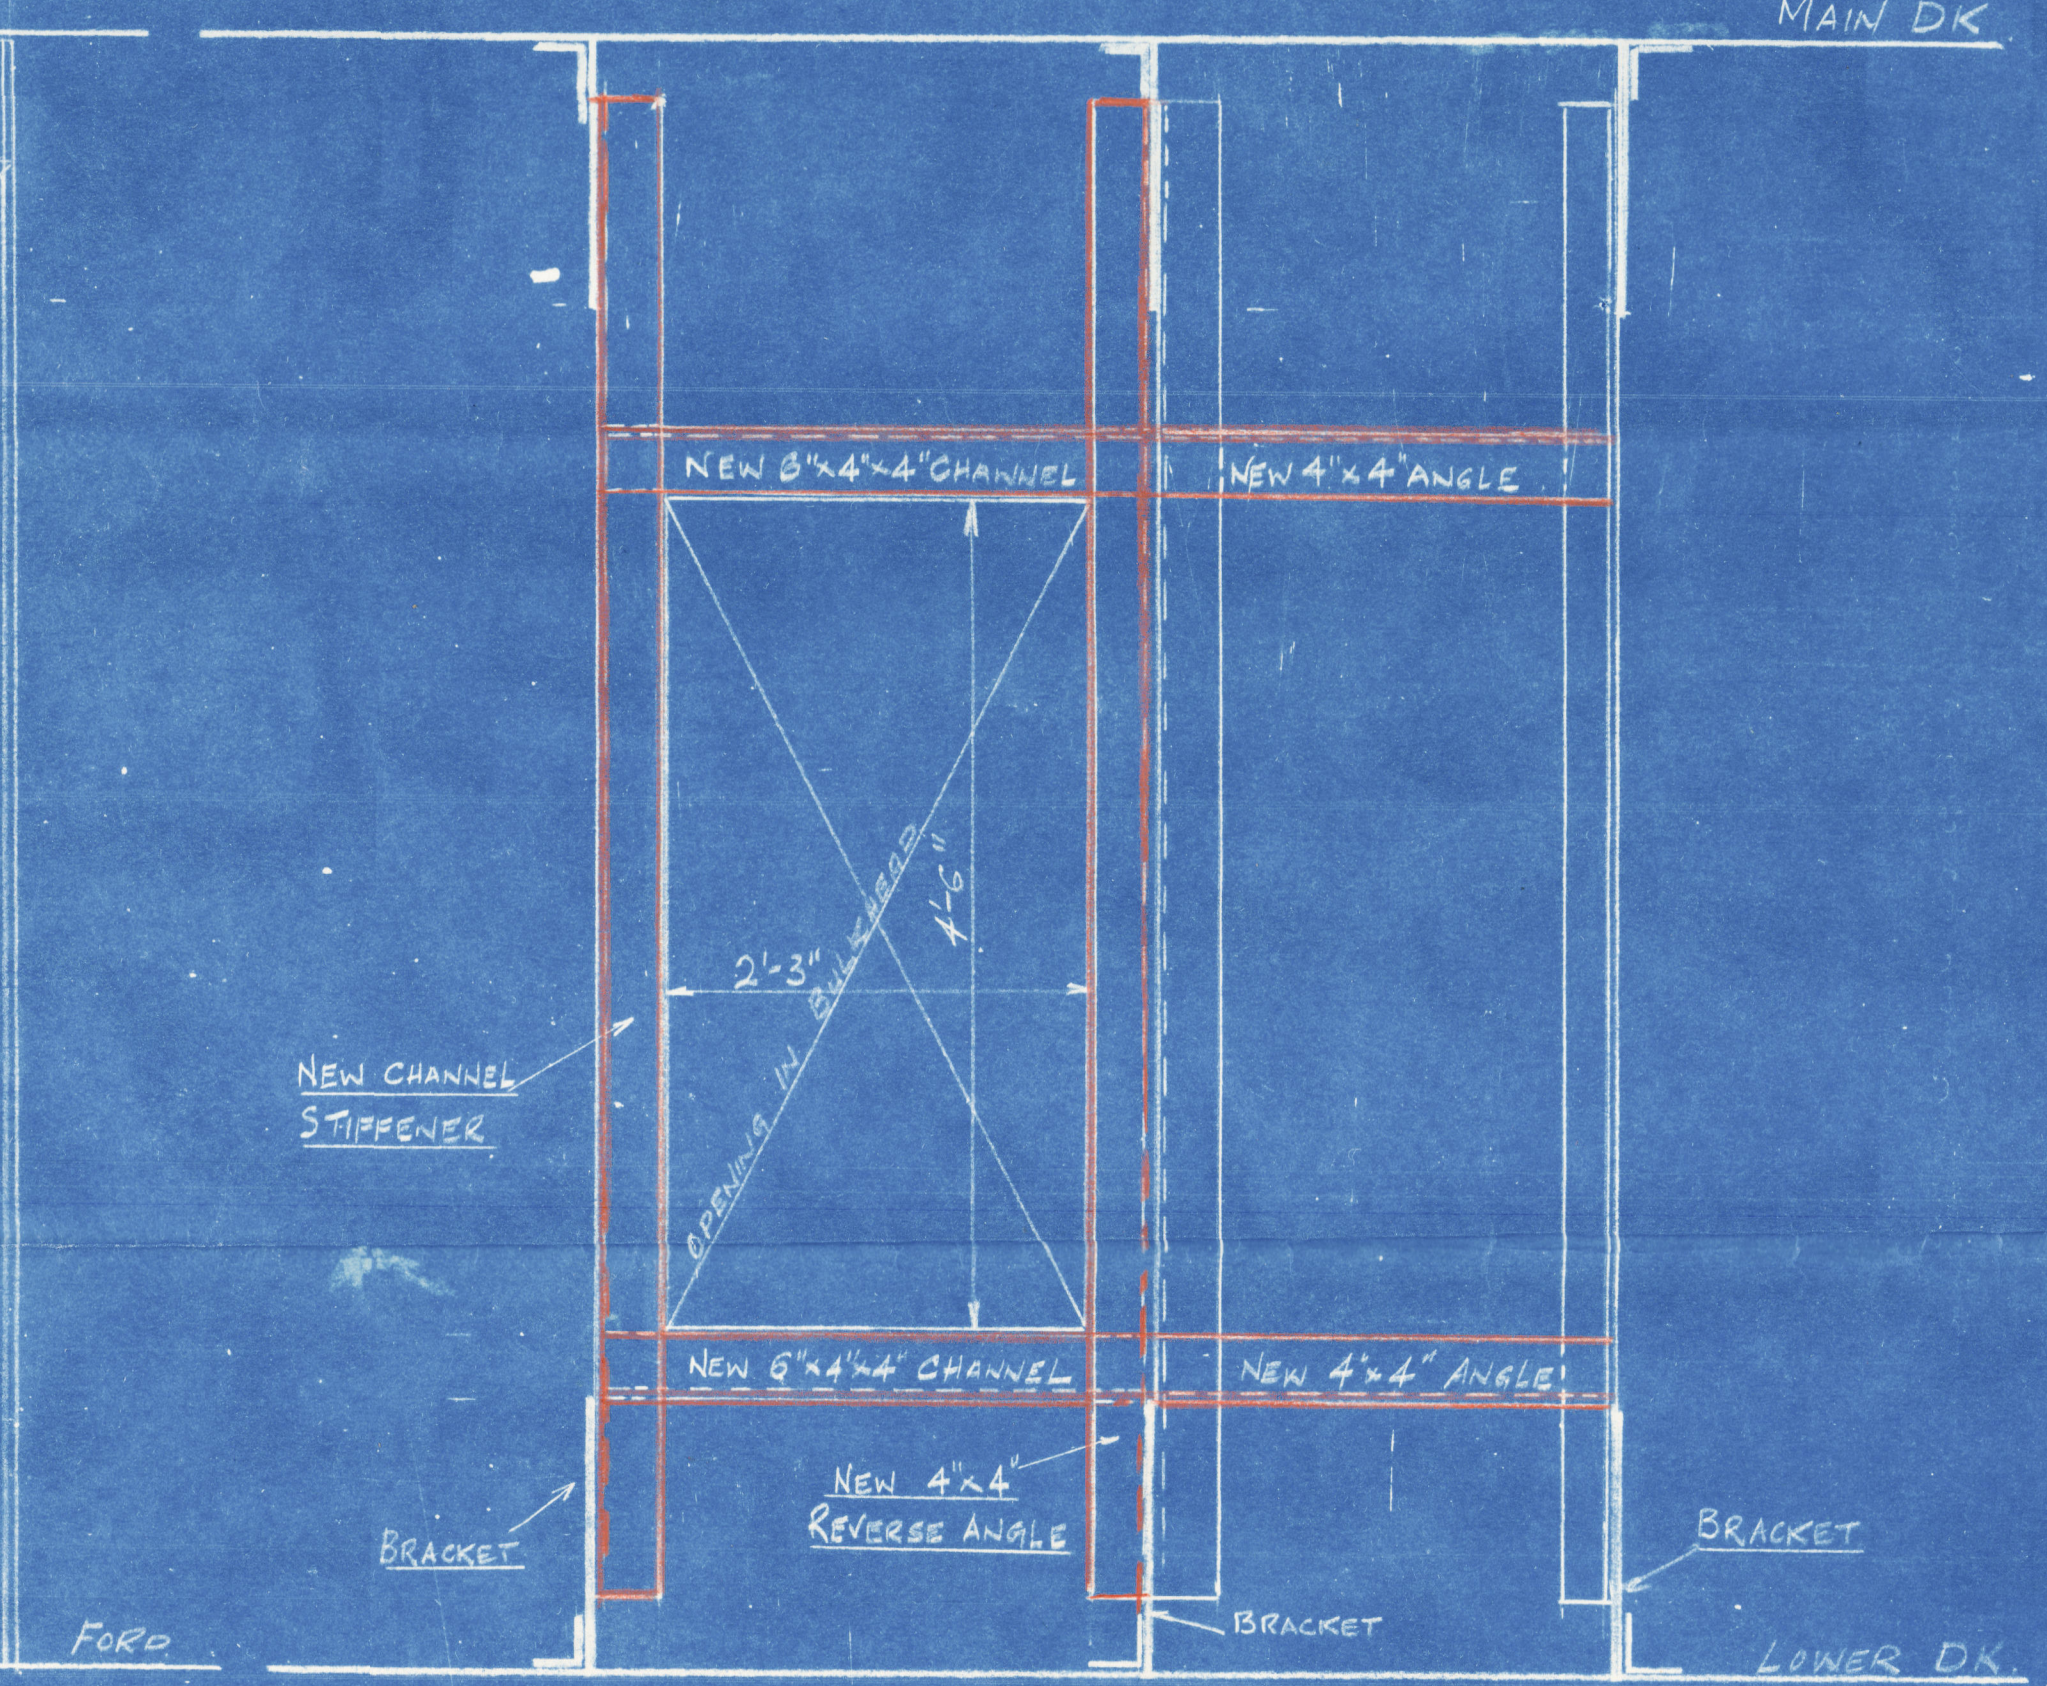

VIEW OF STIFFENING TO SUPPORT WATER TIGHT DOOR.  
LOOKING FORD AT AFT MOTOR ROOM BULKHEAD.

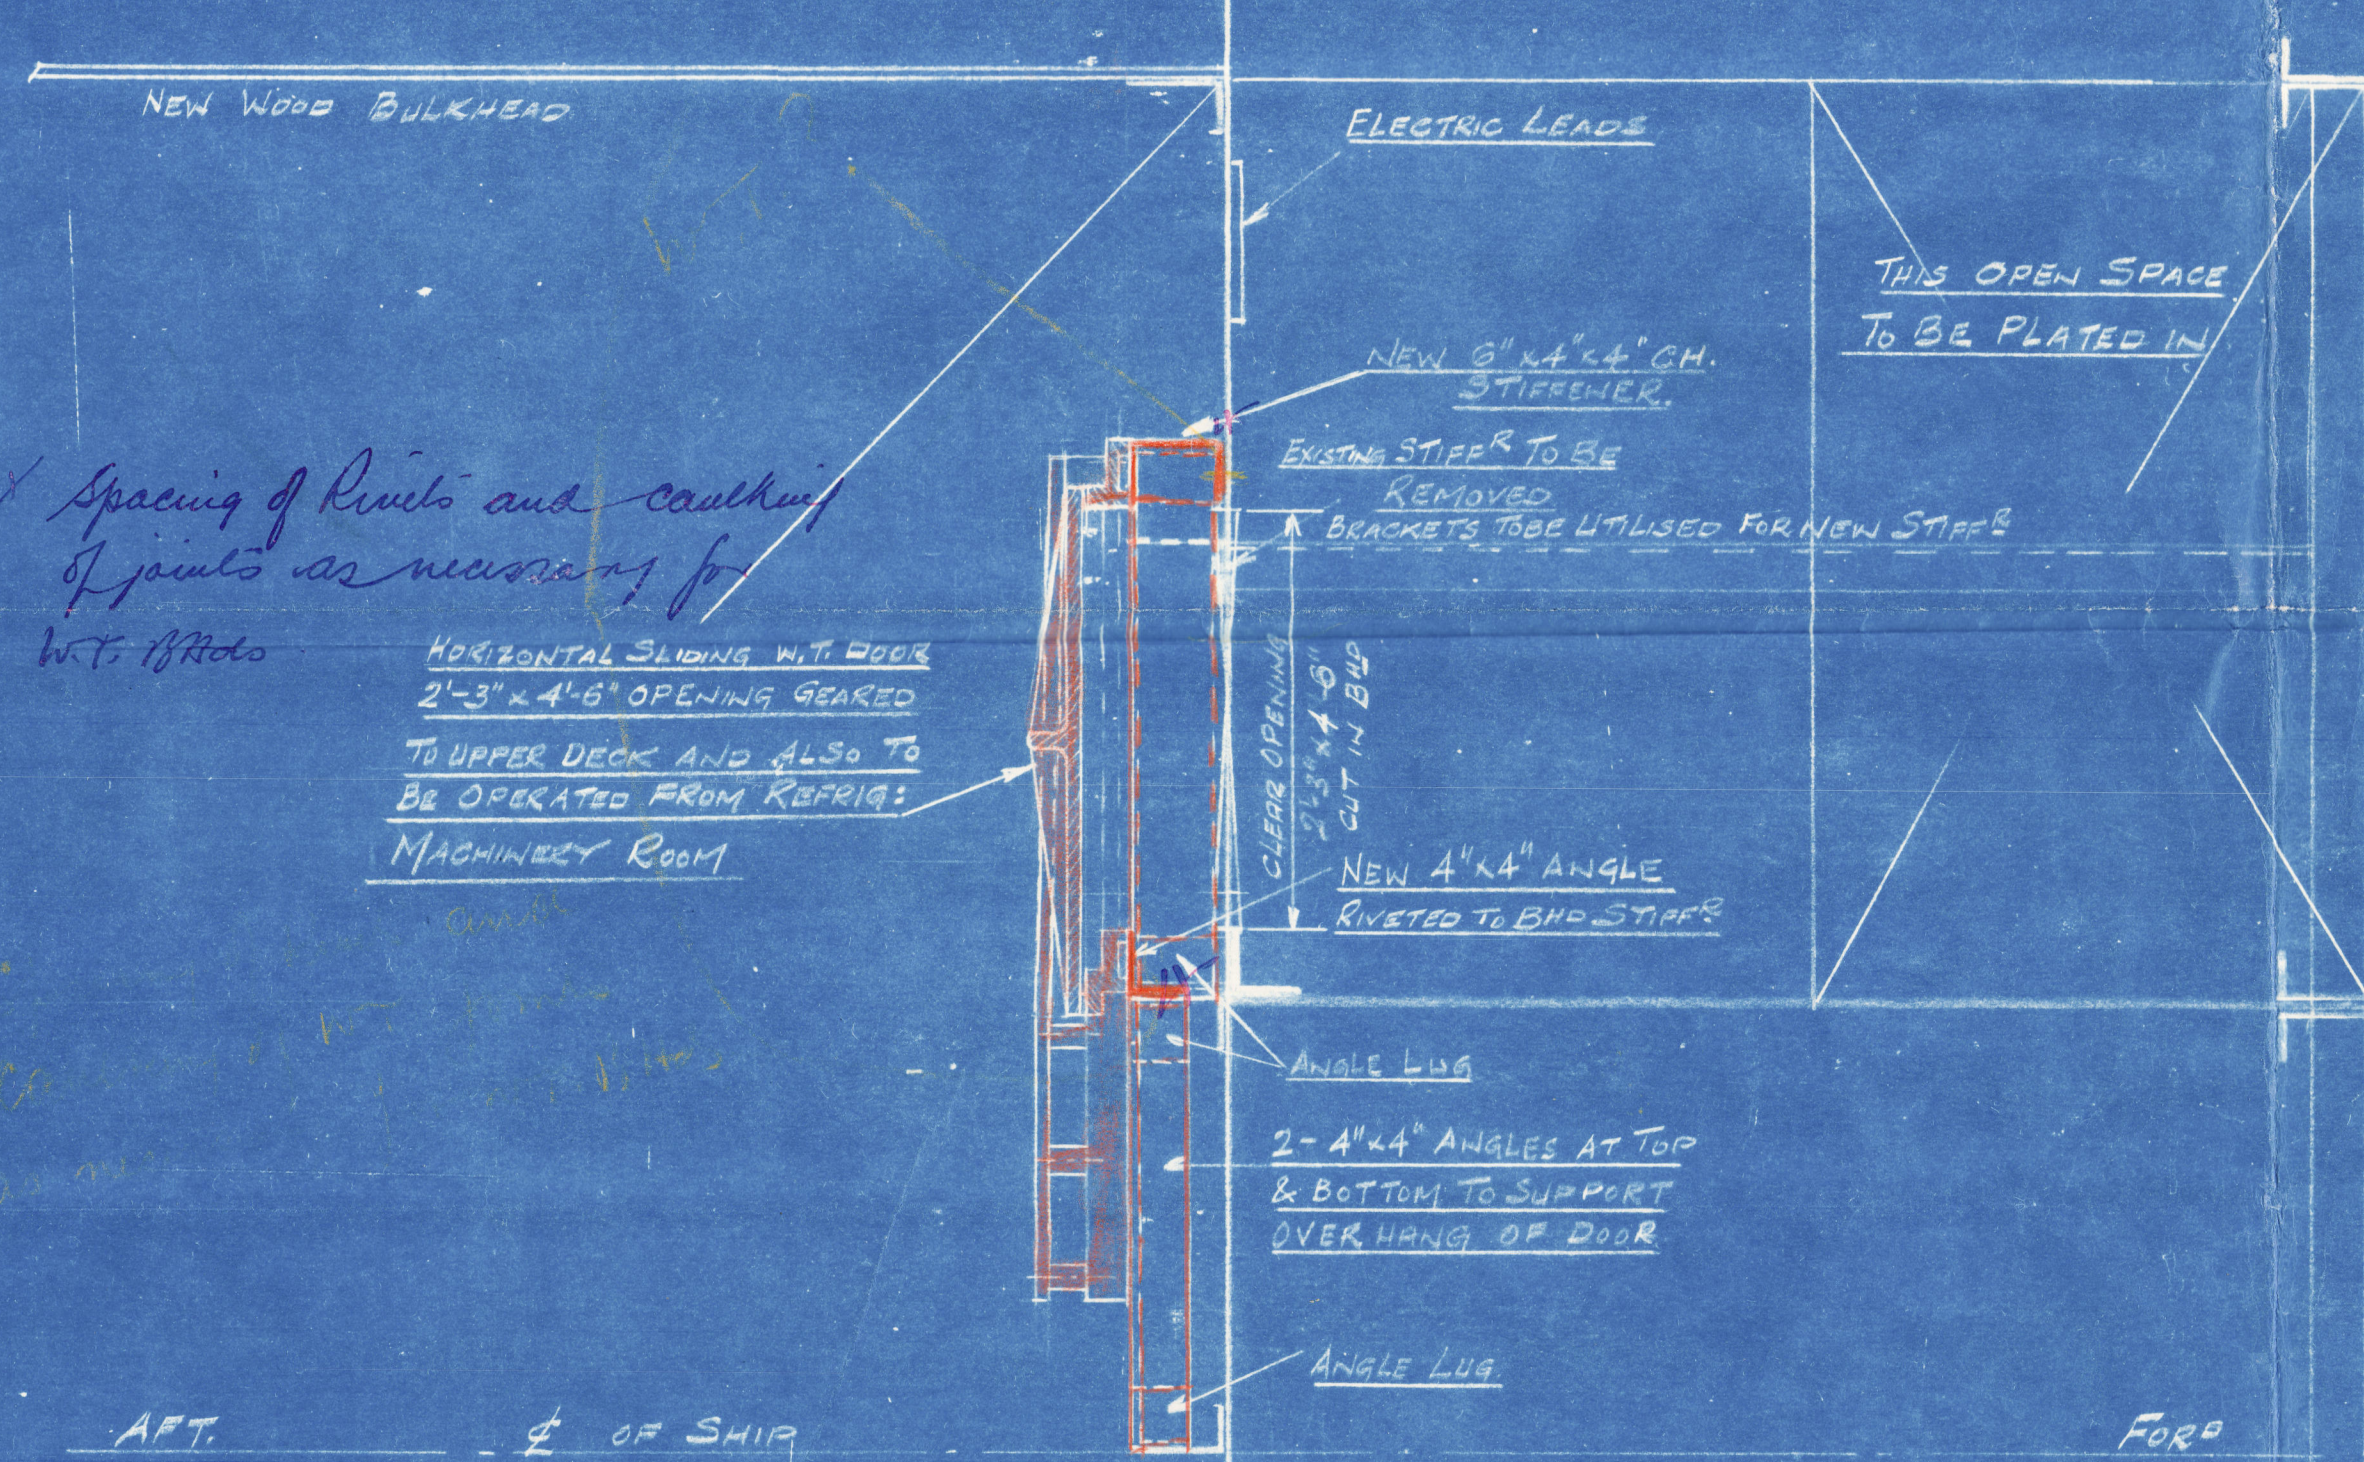


PLAN AT LOWER DECK

M.V. ACCRA & APAPA.  
PROPOSED METHOD OF FITTING NEW HORIZONTAL SLIDING WATERTIGHT DOOR TO AFT MOTOR ROOM BULKHEAD IN CONNECTION WITH NEW REFRIGERATED CHAMBER IN NO. 3. LOWER TWEEN DECK  
SCALE 1" = 1'-0"

NEW WORK IN RED

Door to be fitted & tested as per Section para 12 (a) & (b)

ELDER, DEMPSTER LINES, LTD.	
SUPT. ENGINEER'S DEPT.	
DRAWING OFFICE	
DRAWING NO.	A. 5608
DRAWER NO.	3
DRAWN BY	LM
CHECKED BY	
DATE	31.1.35

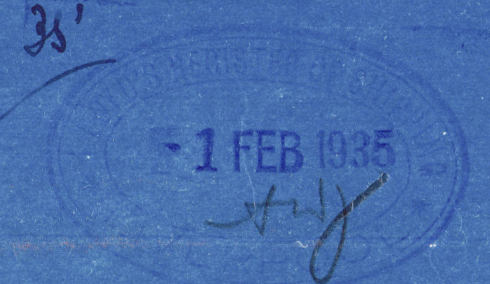



ACCRA

+

APAPA.

---


Seating Hor. W.T.

door

---

Liverpool Report No 105391

---

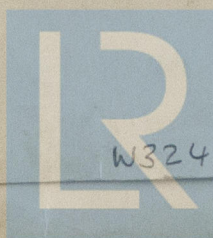

© 2020

W324-0017 Lloyd's Register  
Foundation