

30/9/24

PROCESSES


N^{os} 616 & 695

MIDSHIP SECTION.

LENGTH B. P. 450'-0"
BREADTH MLD. 62'-0"
DEPTH K_{to}B. 35'-0"
CAMBER 6" 62'-0"

SCALE 1/2" = ONE FOOT

LLOYDS 100 A1 CLASS WITH FREEBOARD.
CORRESPONDING TO A DRAFT OF 24'-0"

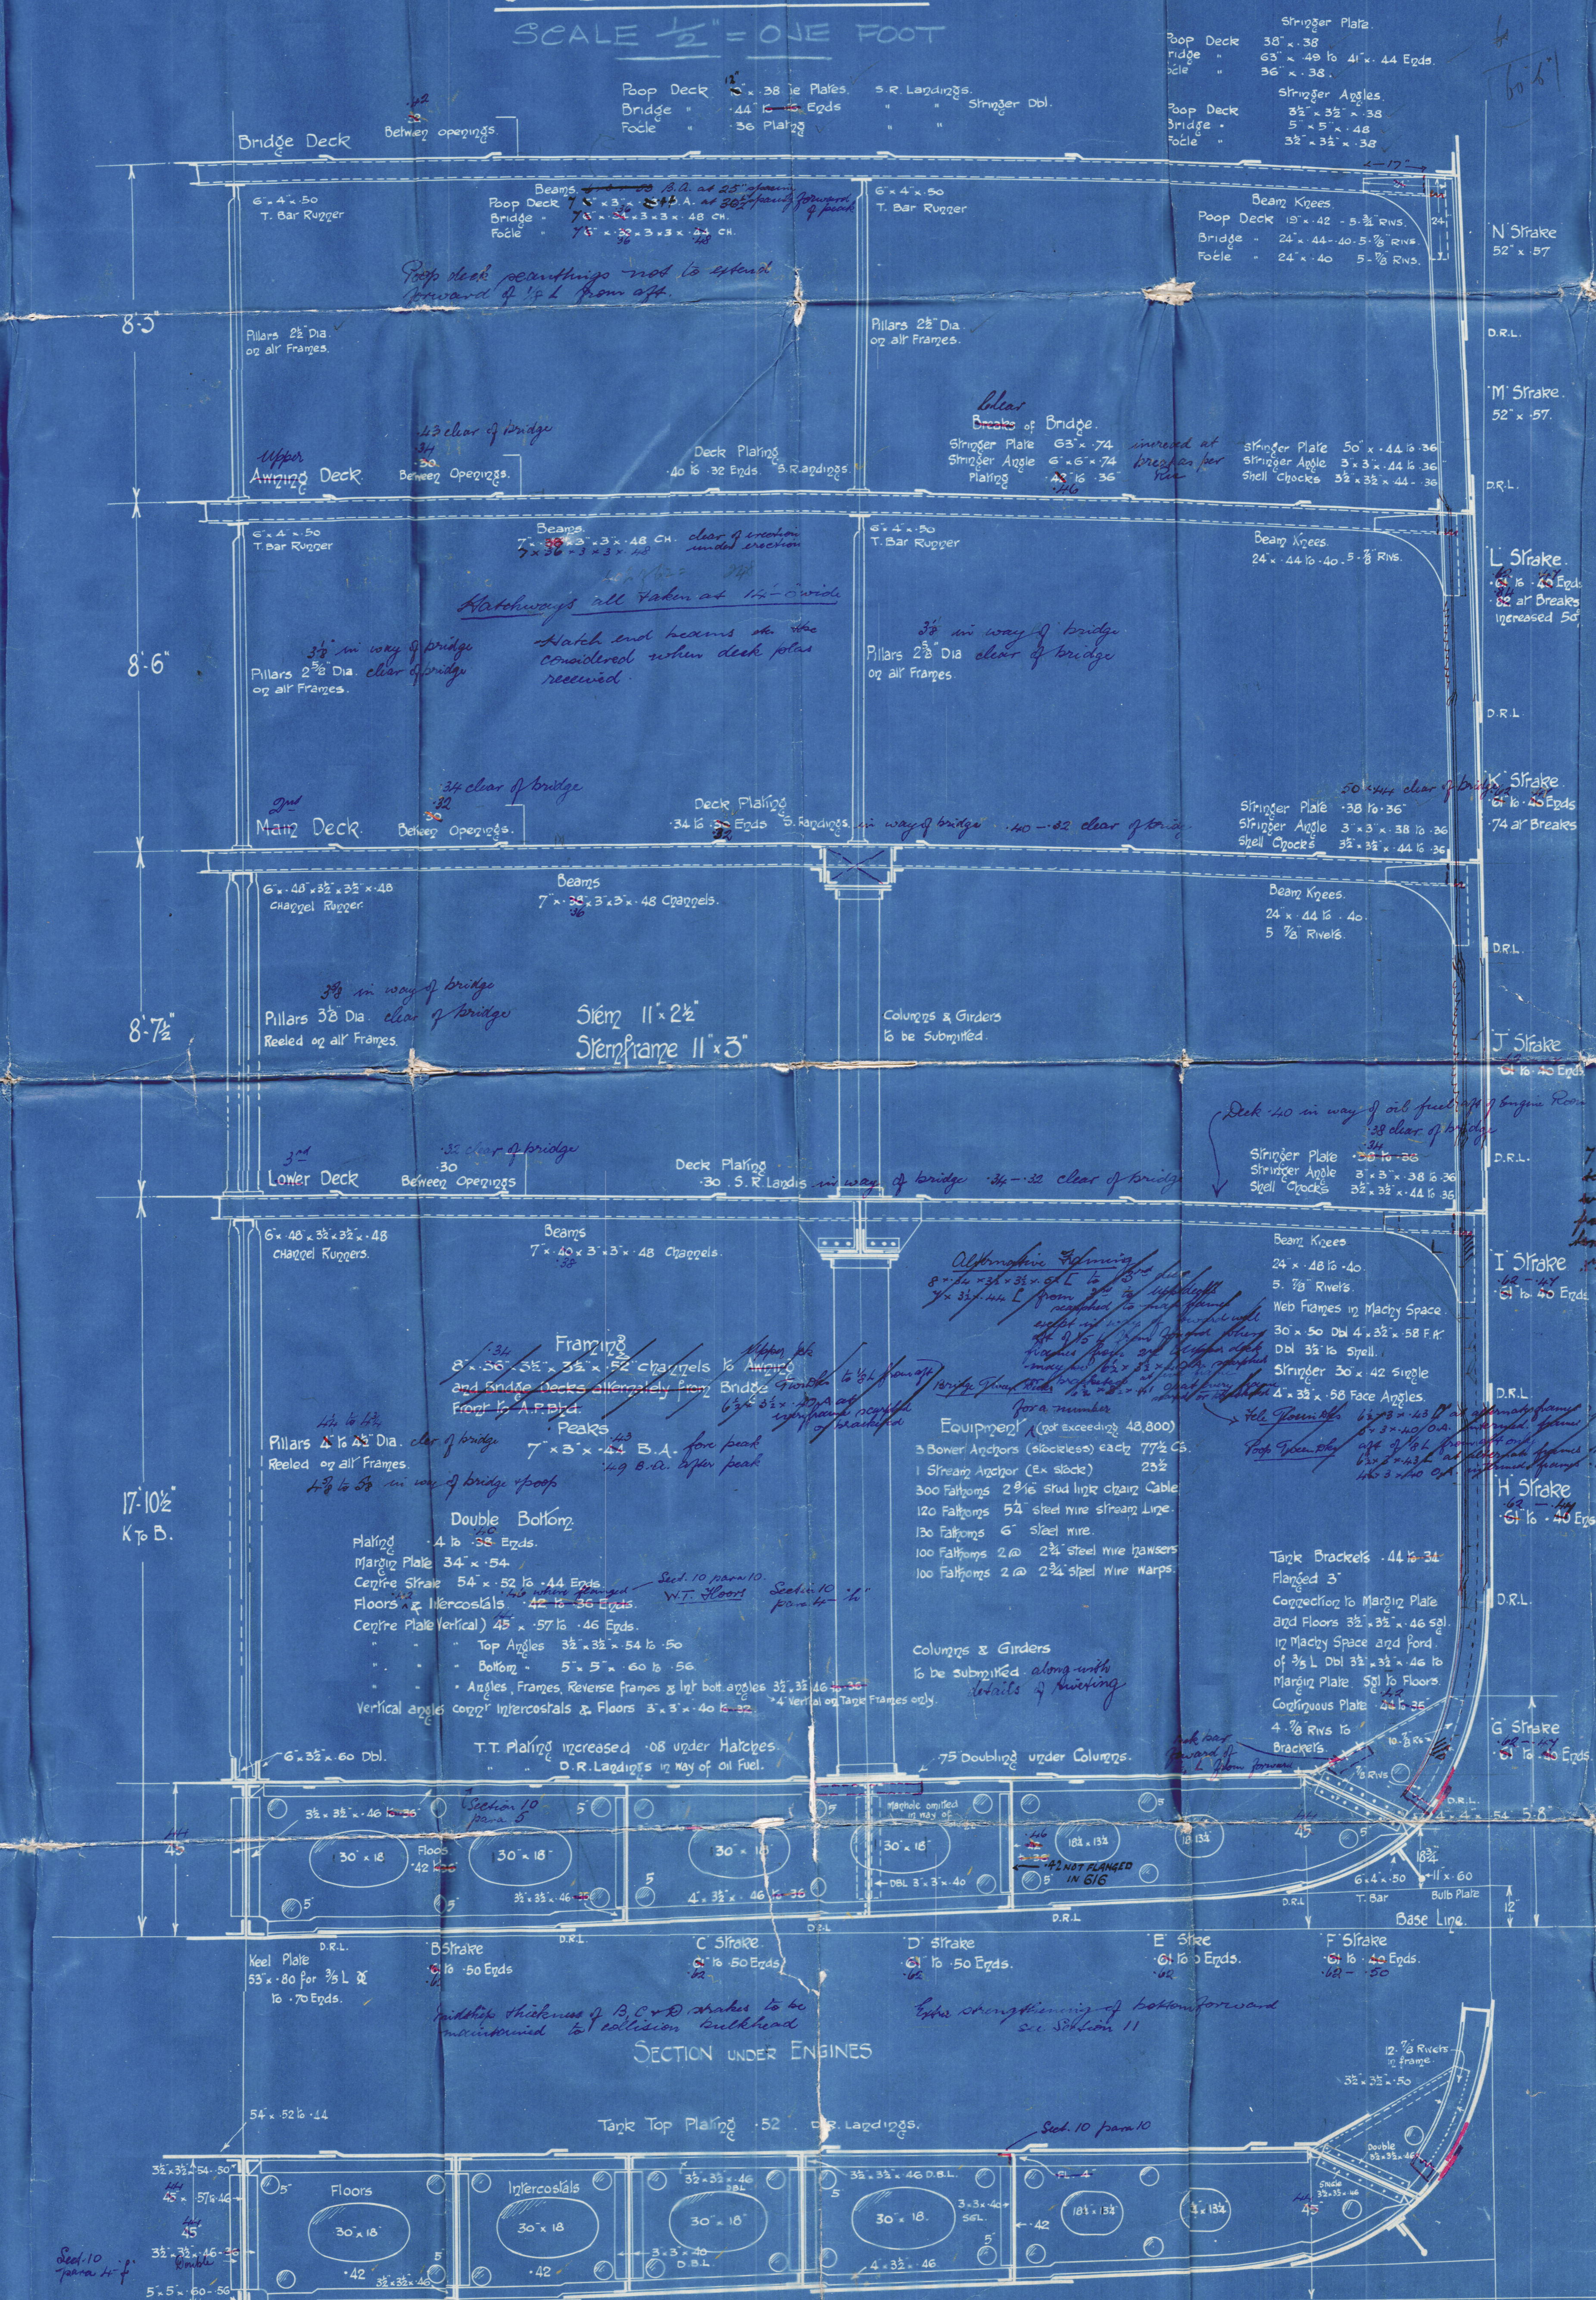

Note: Scantlings of running deck stringers, plating, sheertanks & other below on floor clear of obstructions to stand within the bridge for a distance equal to 1/3 breadth of vessel

Framing as fitted
7' x 3' x 3' x 48 CH from Tank side to Top Bridge & Forecastle St. m. every frame with reversed frame 4' x 3' x 3' x 48 CH over Tank brackets to under side of Beam, and to 2nd Deck Beam in Machinery Space.


30/9/24

Harland & Wolff Ltd

N^{os} 616 & 695

Midship Section

J^s Accra

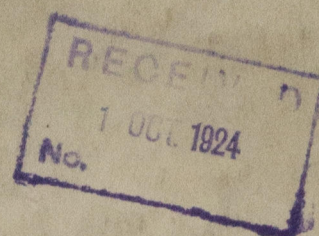

W324-0043

COPY.
PORT OF



© 2020

Lloyd's Register
Foundation