


? B6 P+5. To be further examined when repairs are carried out. P43

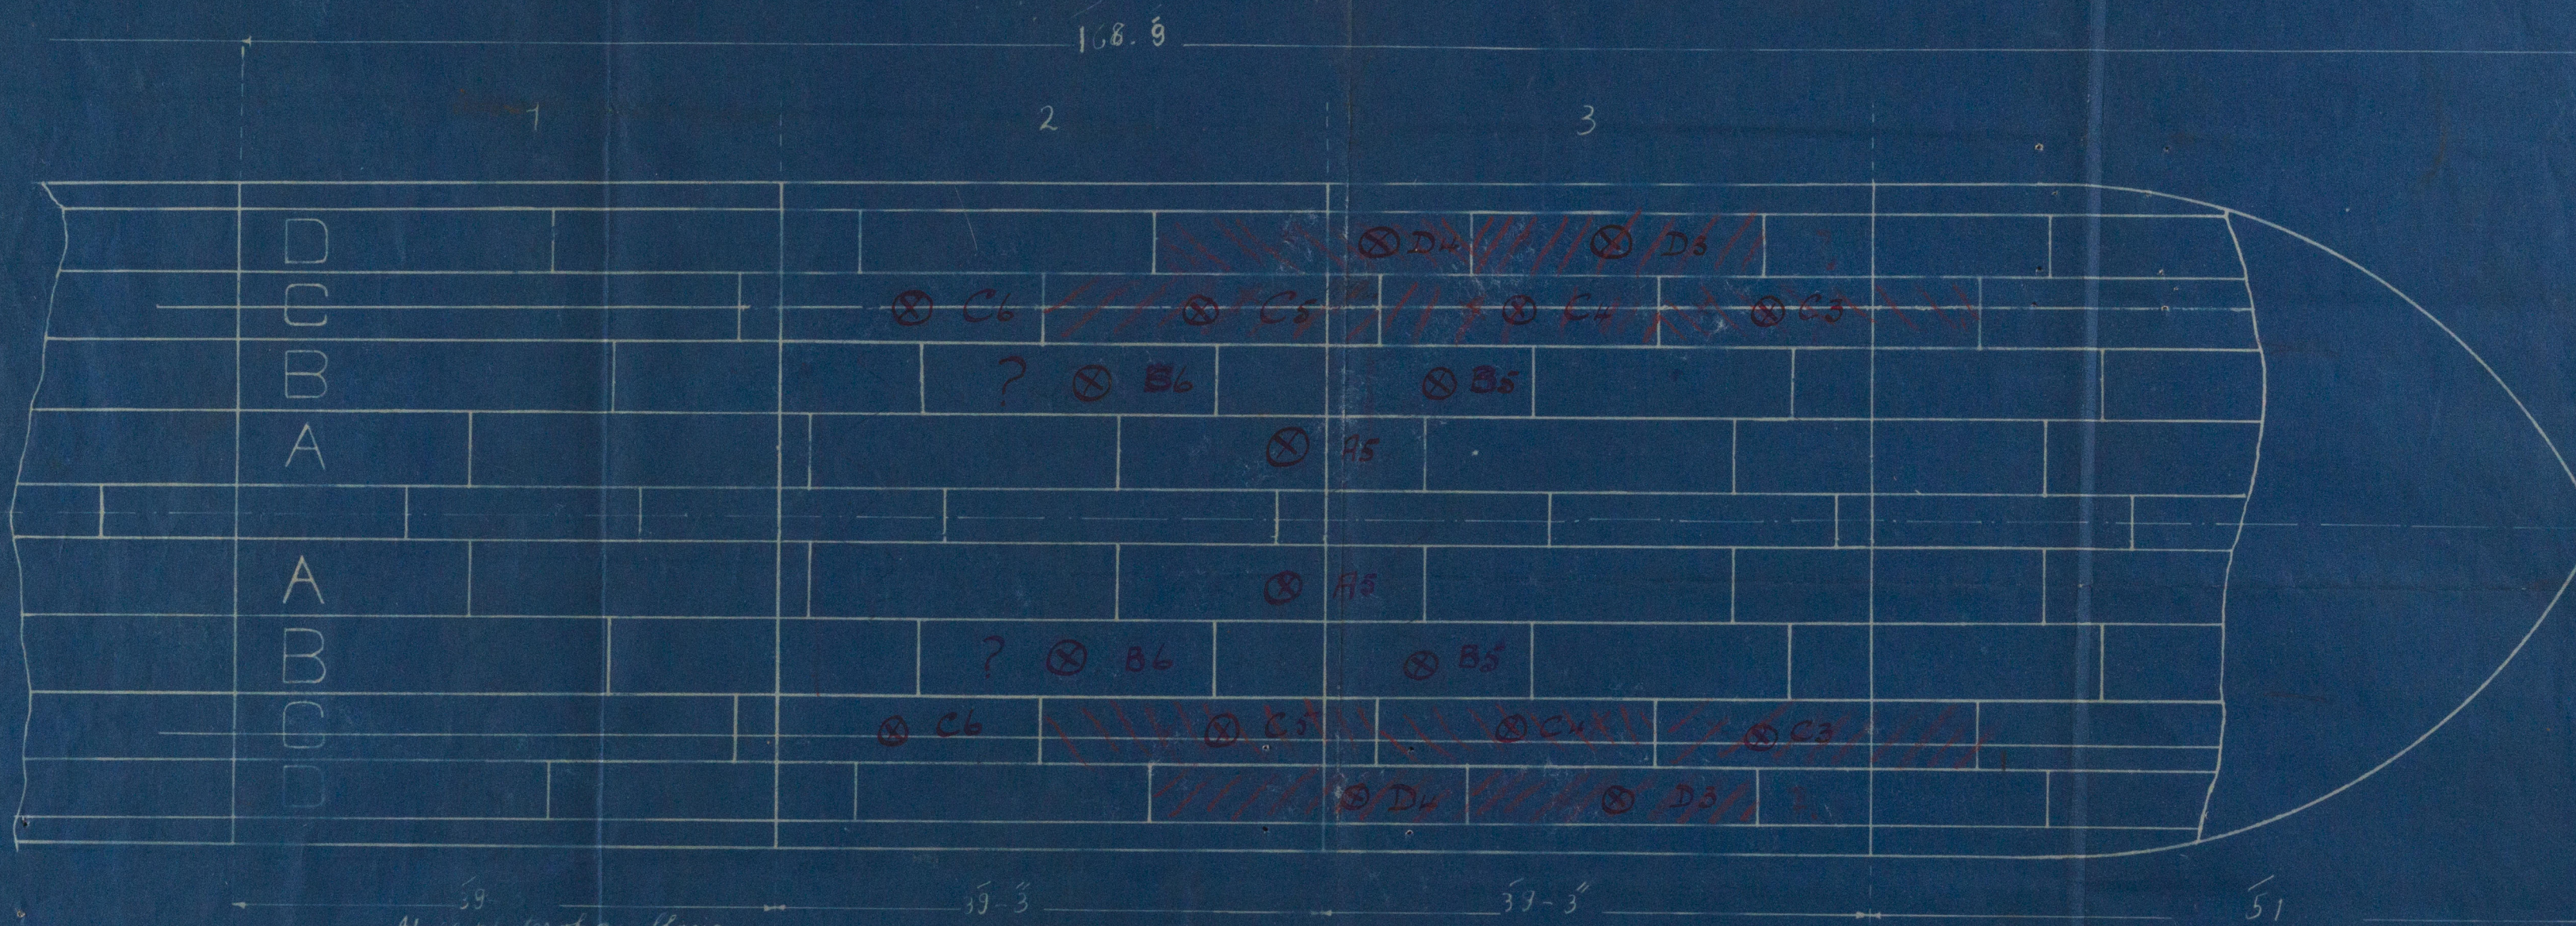

Keel plates	Size	A Strake	Size	B Strake	Size	C Strake	Size	D Strake	Size
2		2		2		1		1	
3	22' x 3'-6"	3	22' x 3'-6"	3	20' x 6"	2		2	20'-6" x 6"
4	20'-6" x 3'-6"	4	22'-6" x 5'-6"	4	23'-6" x 6"	3	23' x 6"	3	23' x 6"
5	22'-6" x 3'-6"	5	22'-6" x 5'-6"	5	22'-6" x 6"	4	23' x 6"	4	23' x 6"
6	22' x 3'-6"	6	22'-6" x 5'-6"	6	22'-6" x 6"	5	25' x 6"	5	23' x 6"
7	22'-6" x 3'-6"	7	24'-6" x 5'-6"	7	22' x 6"	6	23' x 6"	6	23' x 6"

Keel plates 5/8" thick.
A.B.C.D. Strakes 1/2" thick.

APOLLONIA
SCALE

10 feet = 1 inch
Lloyd's Register
Foundation