


S.S. BEAVERDALE

STIFFENING AT FORE END AS FITTED MAY 1931.

SCALES $\frac{1}{8}"$ & $\frac{1}{2}"$ = ONE FOOT.

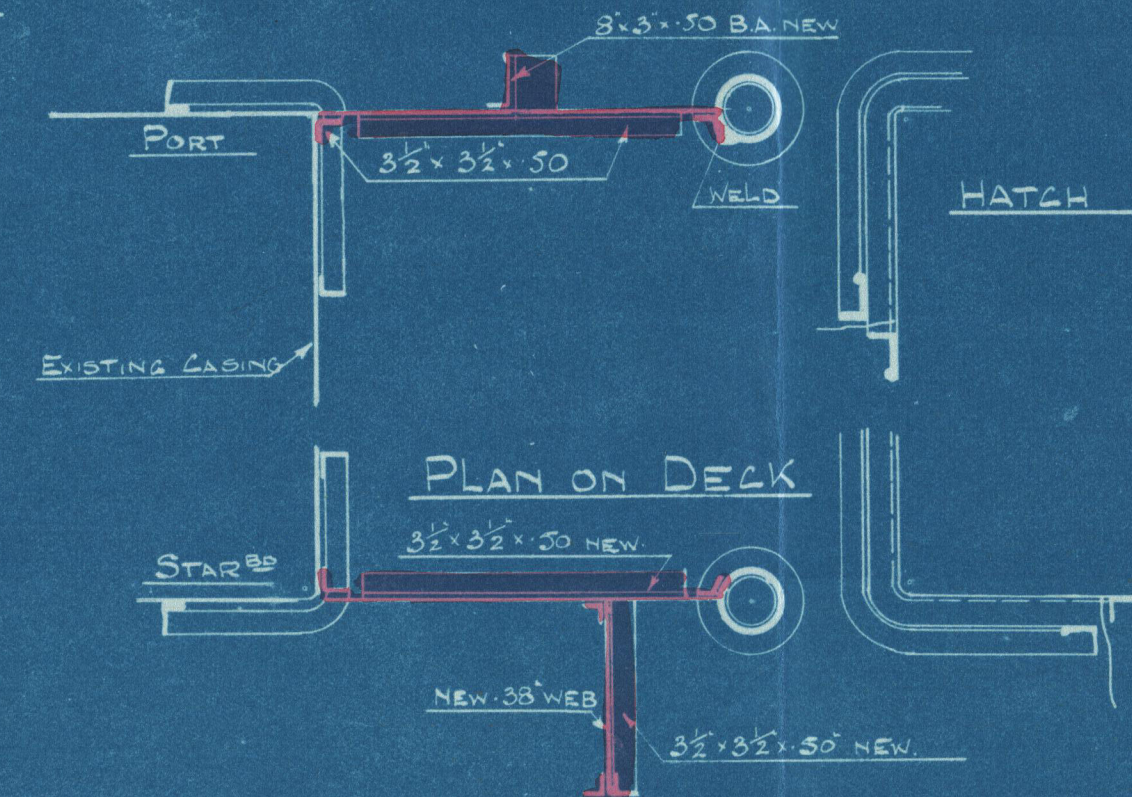

"S. S. Beaverdale"

Additional Stiffening

Fore End.

Antwerp report
No 17627

W336-0009



© 2020

Lloyd's Register
Foundation