





PROFILING AND DECK PLANS

Scale 1/4" = 1'

Dimensions 280' 0" B.P. x 41' 8" M.P. x 20' 9" H.P.

TO CLASS 100A1 AT LLOYD'S

Shall be given

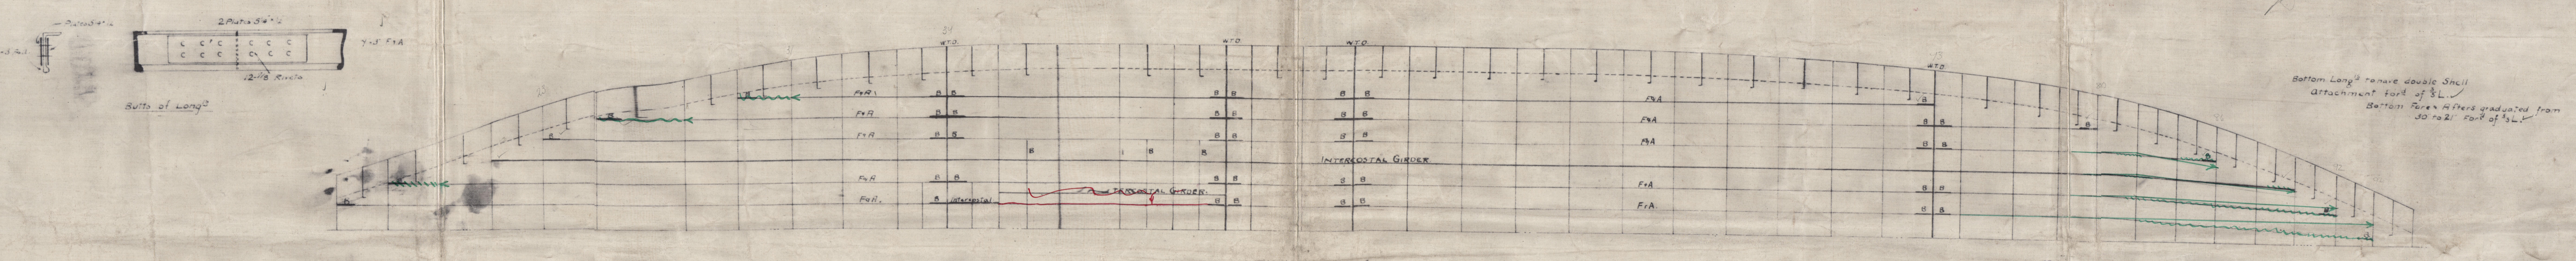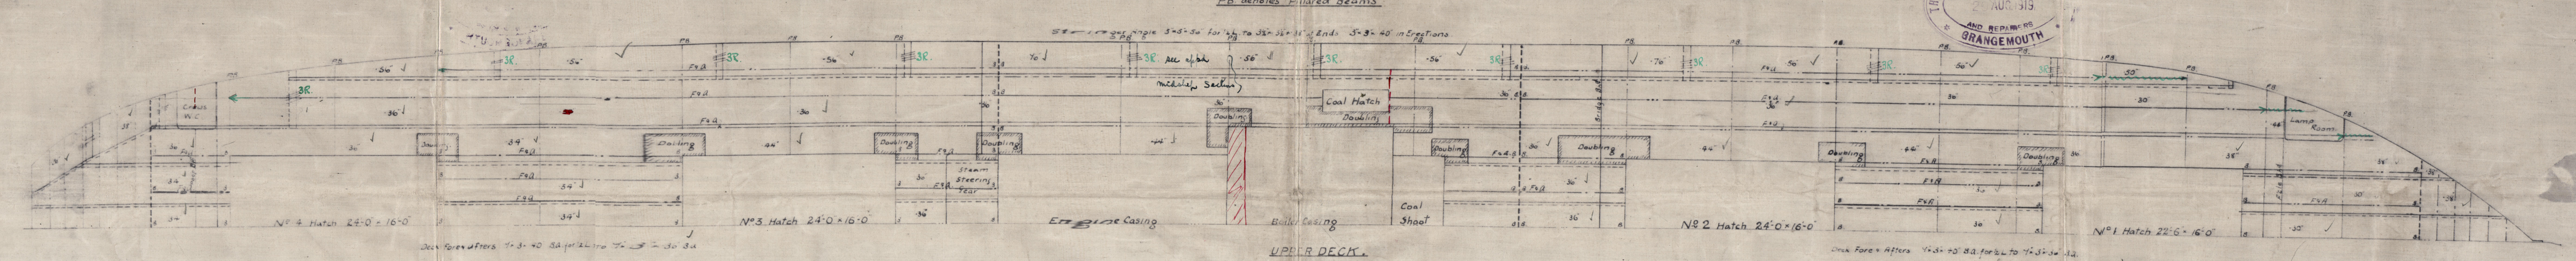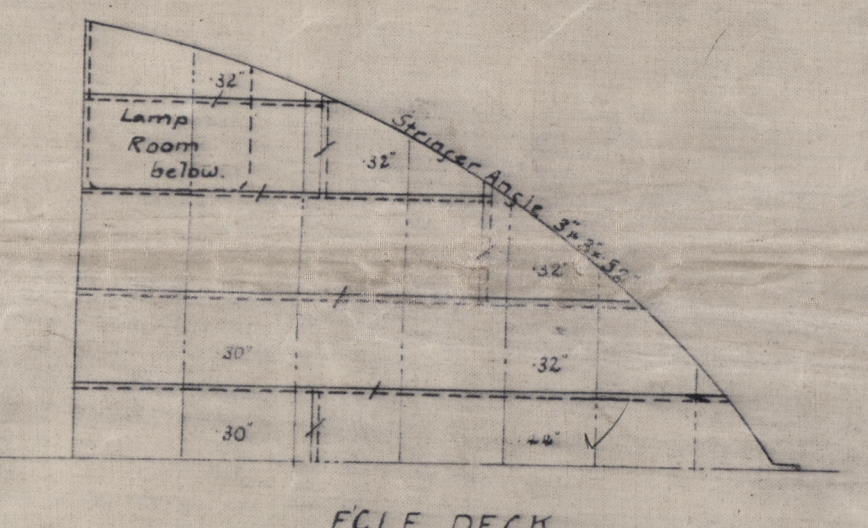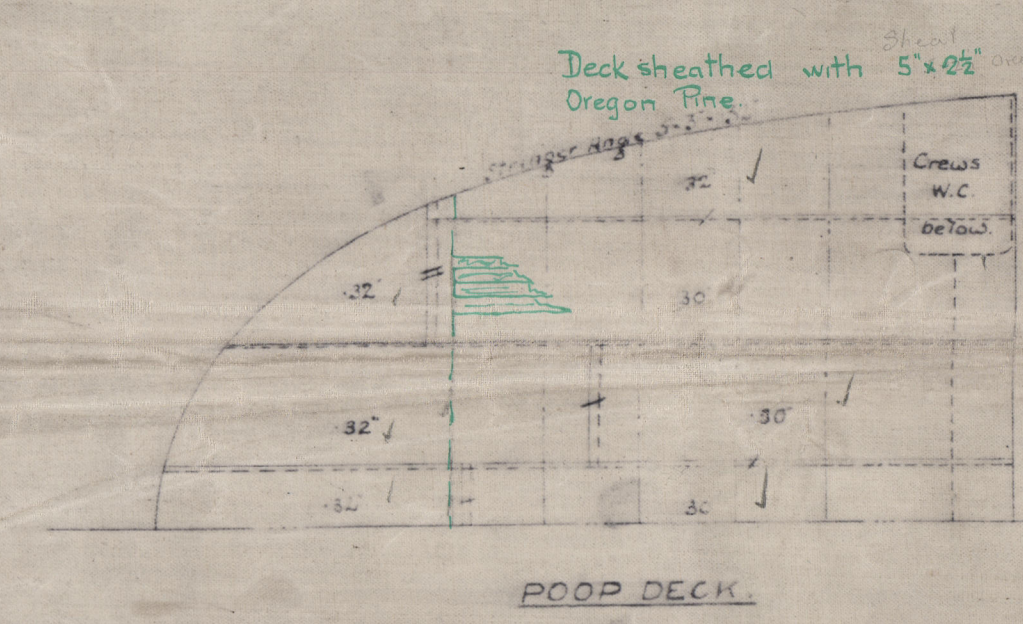

APPROVED

LLOYD'S REGISTER OF SHIPPING

2.9.19

W^o 403 & 404

Grangemouth Dockyard Co^{ld}
Profile & deck plan.

BALMORE

EX

N^o 403 - 3/8 Rowanpark



GLASGOW REPORT No. 40679

H04 - S.S. "Willowpark"

GLASGOW REPORT No. 41957

W338-0078



© 2020

Lloyd's Register
Foundation