



ADDITIONAL STIFFENING AT AFTER END  
AS FITTED APRIL 1931.

SCALES  $\frac{1}{8}$ " &  $\frac{1}{2}$ " = 1 FOOT.

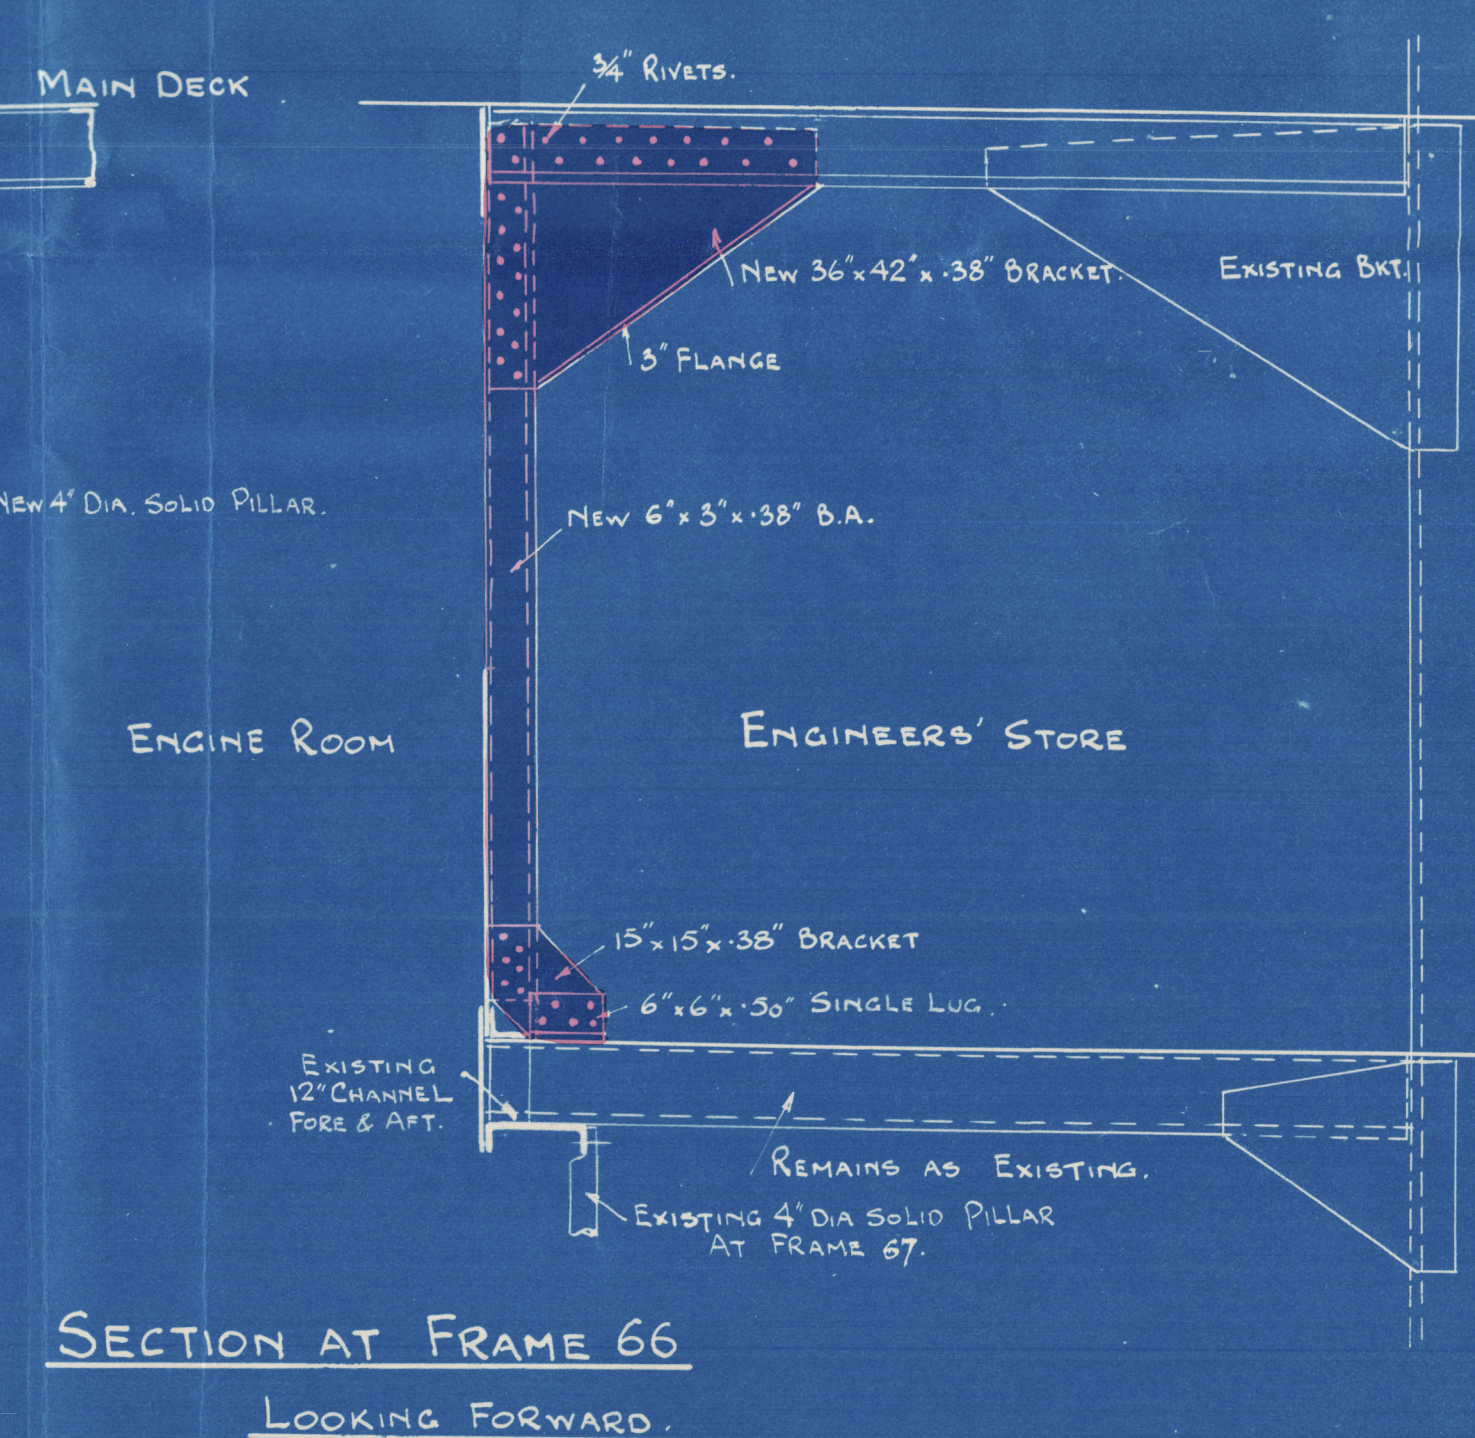

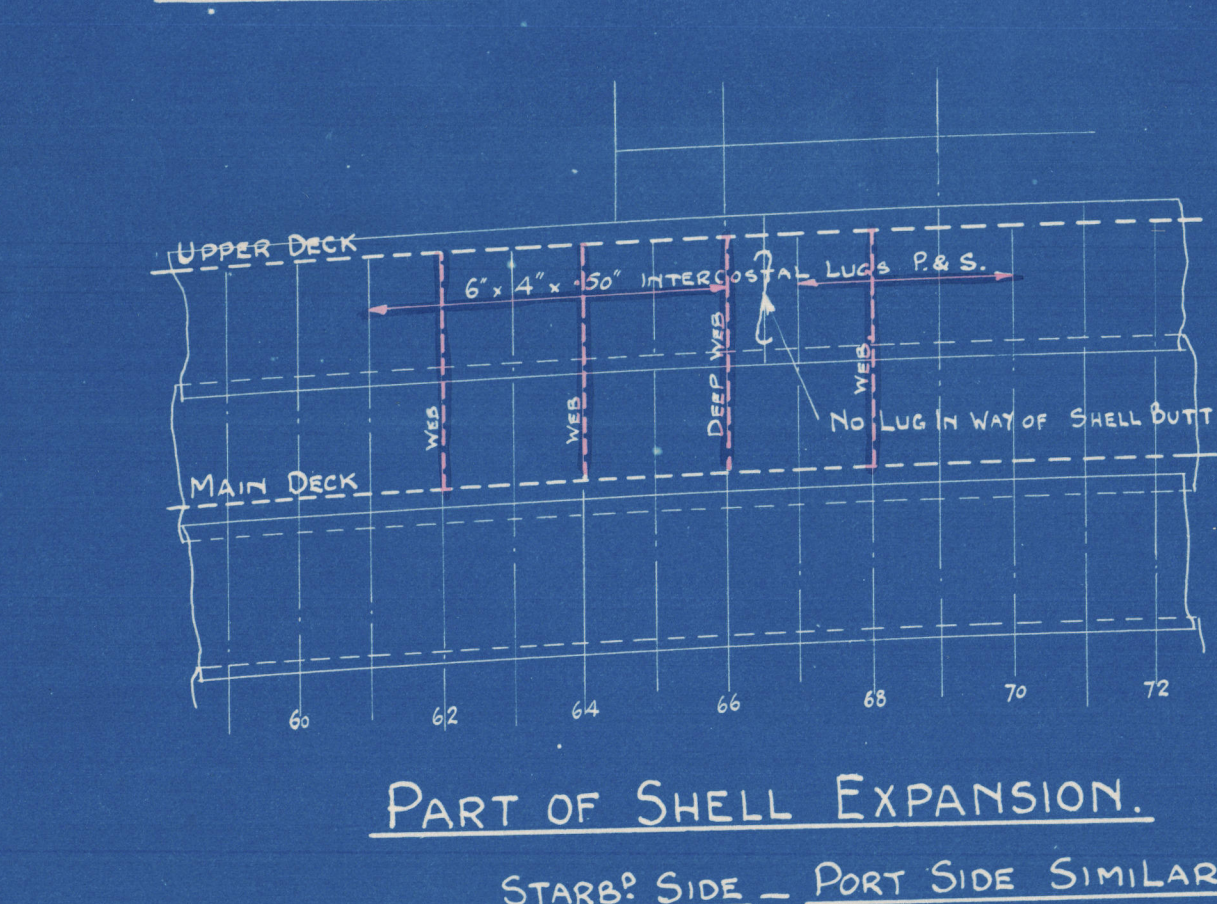

Guthrie M. M. M. M. M.

D. S. Beaumont

Additional Shipment of  
After seed.

Antwerp report No. 17606.

W339-0058



© 2020

Lloyd's Register  
Foundation