


# S.S. BIBURY No 393. PROFILE AND DECK PLAN.

SCALE 1/8" = 1 FOOT

RULE DIMENSIONS:- 404' 92" ON L.W.L. x 54' 75" MLD. x 57' 42" MLD. TO UPPER DECK.  
TO CLASS 100 A.I. WITH FREEBOARD  
CORRESPONDING TO THAT OF A C.S.S. VESSEL WITH TONNAGE OPENING.

ALL BULB ANGLE SECTIONS ARE  
NEW BRITISH SECTIONS.

 



MESSRS. ROBT. DUNCAN & CO. LTD.

PROFILE & DECK (As Built).


---

S.S. "BIBURY".

GRN. REPORT N. 19121.

---

RETAIN

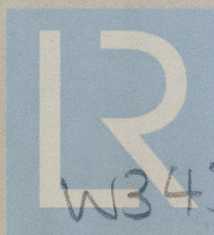

© 2020

Lloyd's Register  
Foundation

W343-0017