

MODIFIED ARRANGEMENT OF COMBUSTION
CHAMBER BACK STAYS.


upon 25.10.29

MAIN BOILERS - 2-OFF

SCALE - 3/4" = ONE FOOT

TO PASS LLOYDS' SURVEY FOR 200 LBS/IN² W.P.

ENG. NO 434

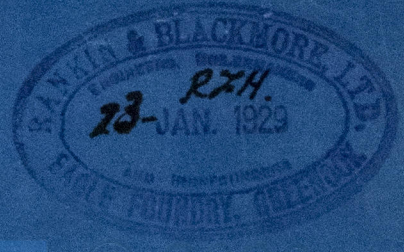

W343 0019

Foundation

8-9 1/2
2
17-7

W343-0019



© 2020

Lloyd's Register
Foundation