




S. S. No 393.
PROFILE AND DECK PLAN.

SCALE 1/8" = 1 FOOT

RULE DIMENSIONS:- 404'92" ON L.W.L. x 54'79" MLD. x 37'42" MLD. TO UPP. DECK.
TO CLASS 100 A.I. 'WITH FREEBOARD'
CORRESPONDING TO THAT OF A C.S.S. VESSEL WITH TONNAGE OPENING.

ALL BULB ANGLE SECTIONS ARE
NEW BRITISH SECTIONS.

 

APPROVED
LLOYDS REGISTER OF SHIPPING
J. J. J.
DATE 10.1.29

②
R. DUNCAN & Co


NO 393

PROFILE & DECKS

S. S. "BIBURY"

GRN. REPORT NO 19121

RETAIN

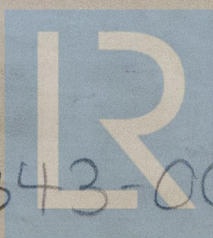

© 2020

Lloyd's Register
Foundation

W343-0023